

Profile
Midship Section
No. 350



Profile & Sect. Plan
Mess. Fleming & Ferguson
Lda


No. 350

DREDGER

N° 350

AS BUILT

Gr. n° 24239

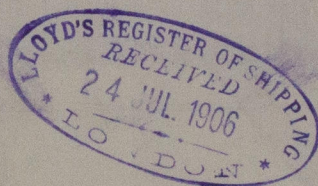

W 1240-00/4



© 2020

Lloyd's Register
Foundation