



18.9.00
 24.9.00
 26.10.00
 8.12.00
 22.3.01
 2.4.01
 15.4.01

— Longitudinal Section of No 180. S.S. —
 Scale $\frac{1}{8}$ inch = 1 Foot.


18.9.00
 24.9.00
 26.10.00
 8.12.00
 22.3.01
 2.4.01
 15.4.01

 


Belfast
Workman Clark & Co
S.S. 180
Long ~~Leith~~ Dept Section

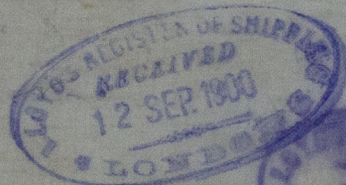

S.S. City of Madrid
Bel 5296

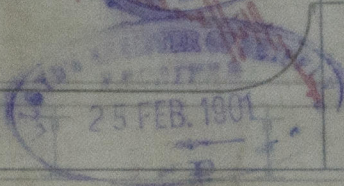

W1241-0119

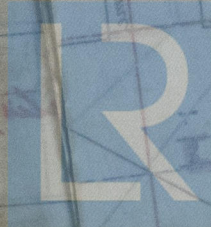

© 2020

Lloyd's Register
Foundation