

# Midship Section of No 180 S.S.


To. class 100 71. (3 Decks)

Scale 1/2 Inch = 1 Foot.

Similar to ss Lord Cornwallis

Refers report no 5086








18.9.08  
25.9.00  
29.9.00  
26.10.00  
8.12.00  
22.3.01  
2.4.01  
15.4.01

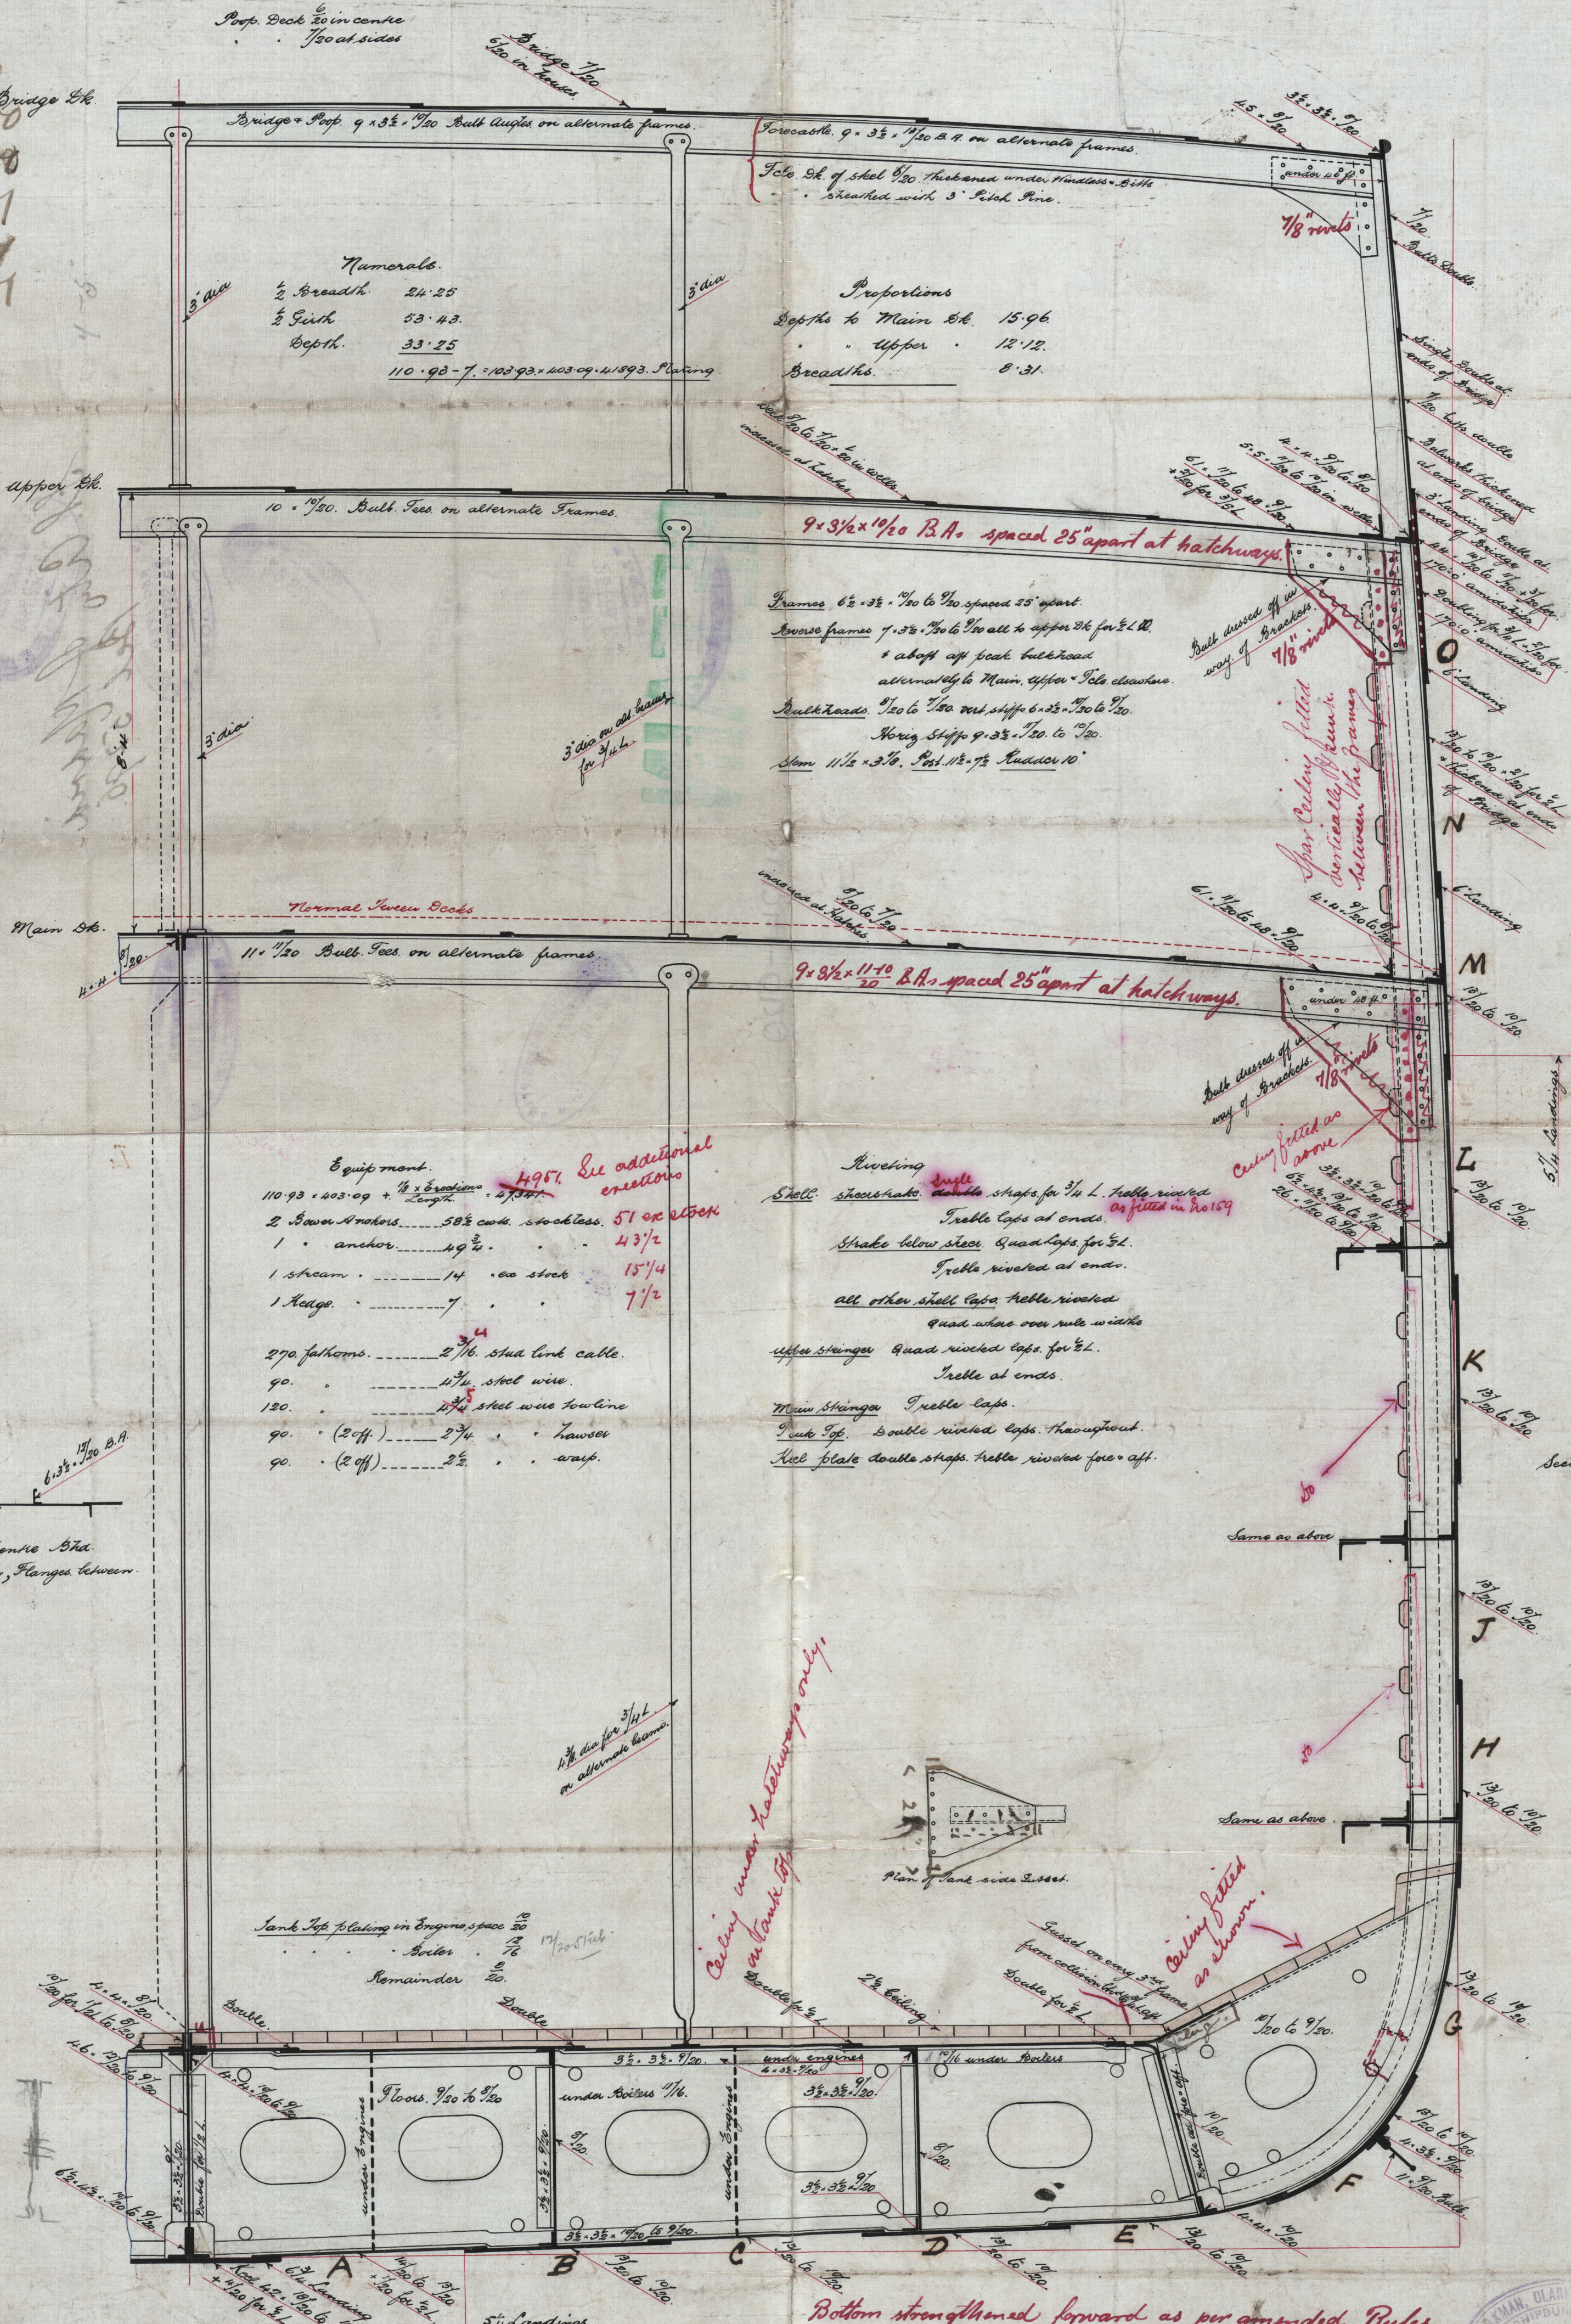

© 2020  
Lloyd's Register  
Foundation  
W1241-0120

Belfast  
Worham Clark & Co  
15/80  
~~Mitchell~~ R. Ann

S. City of Madrid  
Bel 5296.

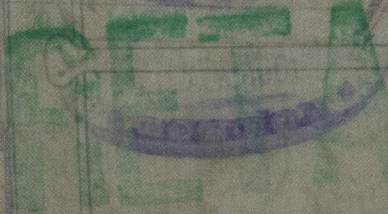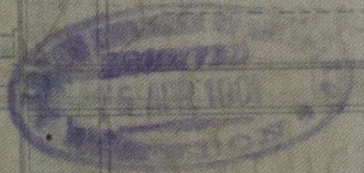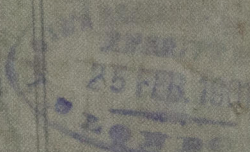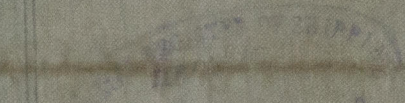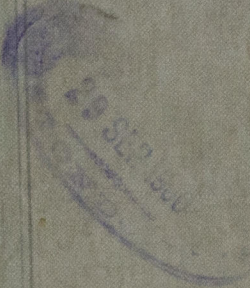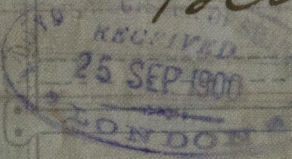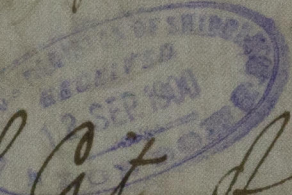

© 2020

Lloyd's Register  
Foundation

W1241-0120