

— PROFILE N^o 151. —

— SCALE 1/8" = 1 FOOT. —


— DIMENSIONS: 410.0 x 52.0 EXT x 30.6 MLD —

BEAMS TO FLANGE ASY EXCEPT WHERE OTHERWISE SHOWN ON UPPER DECK

BEAMS TO FLANGE FOR EXCEPT WHERE OTHERWISE SHOWN ON UPPER DECK

NOTES:
RIVETS AND FRAMES TO SHELL 1/8" DIA. SPACED 6 DIA. APART EXCEPT IN FORE PEAK WHICH ARE 1/4" DIA. APART.

NOTE:
MAIN 1 LOWER DECK BEAMS TO STOP AT JOE OF FRAMES
1 TO FLANGE SAME WAY AS FRAMES EXCEPT WHERE OTHERWISE SHOWN.

 

Boiler fitted in 151

bridge in 151

DOUBLE FRAMES IN TANK FROM 147 TO 164 INCLUSIVE 1/4" x 3/8" x 1/4" BEFORE THE 35 LENGTH FOR THE RIVETS IN THE LANDING EDGES OF THE STRAKES OF PLATING FORMING THE FLAT OF BOTTOM SPACED NOT MORE THAN 4 1/2 DIA. APART. THE RIVETS IN THE PLATING TO FRAMES IN WAY OF SAME TO BE NOT MORE THAN 3/4 DIA. APART ELSEWHERE RIVETS CONNECTING PLATING TO FRAMES 6 DIA. APART EXCEPT IN FORE PEAK WHICH ARE 1/4" DIA. APART.




Northumberland S. Co.

No. 156.

S. S. "Brantford"

Profile.

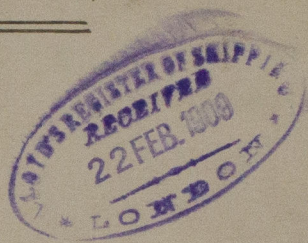

RETAIN



© 2020

Lloyd's Register
Foundation

W1242-0155