

2'-0" ~~19'-5"~~ DEPTH
19'-7"

SCALE: 1 FOOT TO 1 INCH

L.G. MOUCHEL AND PARTNERS LTD
CIVIL ENGINEERS
38 VICTORIA ST LONDON SW.

CARCO SHIP

8. AMENDED

~~6TH DEC 1917.~~

14TH FEB 1911


~~25TH MARCH 1918~~
23RD APRIL 18

25TH MARCH 1918-
23RD APRIL 18

WORKING PLAN

205'-0" x 32'-0" x 19'-5" DEPTH

FERRO CONCRETE CONSTRUCTION HENNEBIQUE SYSTEM

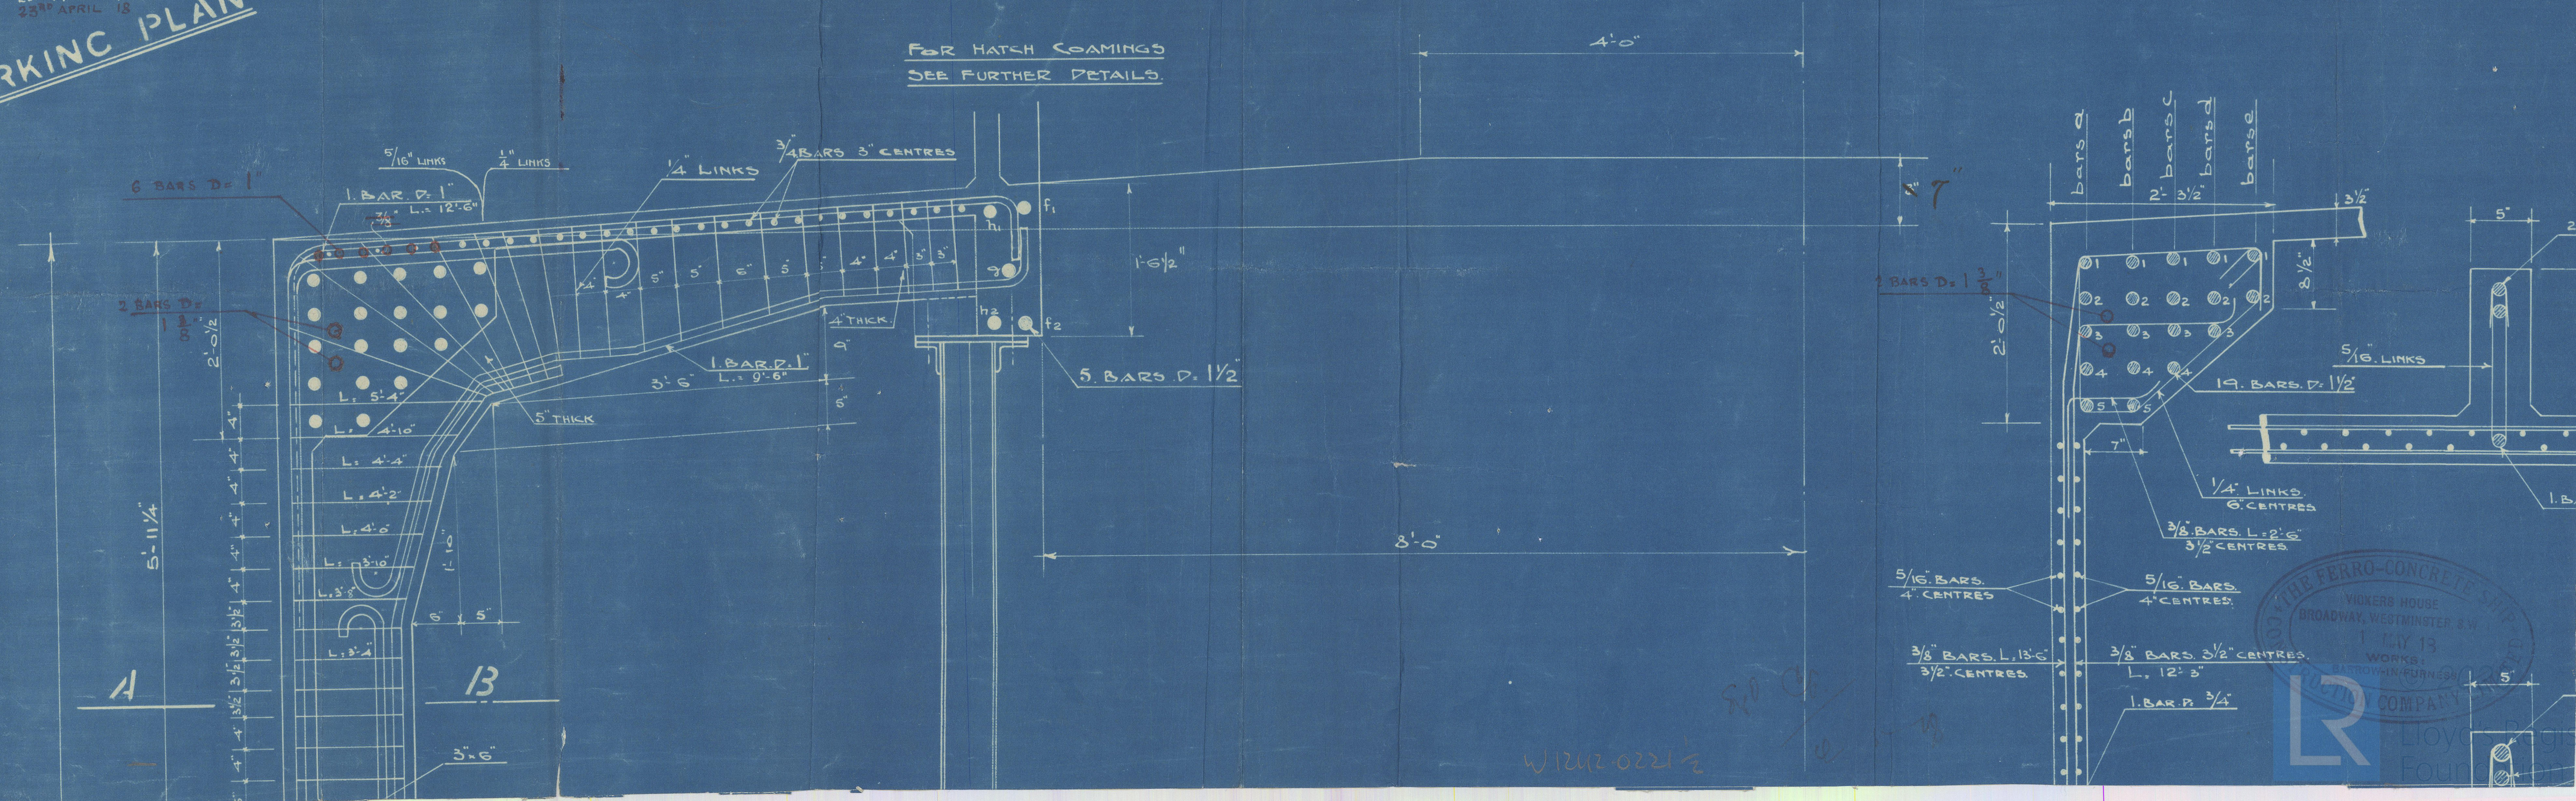

Lloyd's Register
Foundation

(1)



Ferro-concrete Ship Construction Co. Ltd

No 99-104

Cargo Steamers

Midship Section

(8 amended)

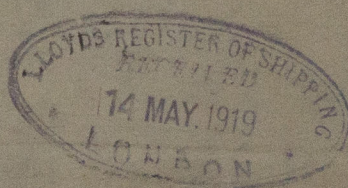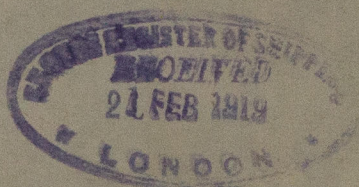

© 2020

Lloyd's Register
Foundation

W1242-0212