

STEEL BOILER 9-6 DIA 9-0 LONG

140 LBS W.P. LLOYDS

Nº 5102-3

Shell 8'-3" wide

Buttstraps  $\frac{11}{16}$ " thick.

Tensile 28-32 tons

RILEY BROS. (BOILERMAKERS) LTD  
STOCKTON ON TEES

84A

Heating Surface 743 SFT.  
Grate area 29 SFT.

Lloyd's Register  
Foundation



Messrs Riley Bros

Boilers No 5102  
5103

for

Messrs G. T. Grey & Co Jun<sup>r</sup>  
S. Shields

Working Press 140 lbs.

5102

No. 5871
LLOYD'S TEST
280 lbs.
28.2.18 - W.M.

trial report

No. 10050

5103


No. 5872
LLOYD'S TEST
280 lbs.
4.3.18 - J.S.

trial report

No. 10051

Messrs. Amis & Co (Warr)  
Rearrow. 1768

(28)

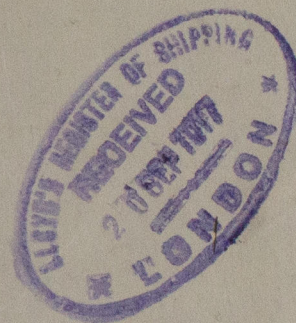

W1242-0222



© 2020

Lloyd's Register  
Foundation