

Received at

LLOYD'S REGISTER
OF SHIPPING

21 SEP 1905

100

Lloyd's Register of British and Foreign Shipping.

(Report on Vessel No. 17382 Port Hull)ss "Duncraig"

No. 6087A SHIP FORGINGS OR CASTINGS.

The words FORGINGS or CASTINGS, IRON or STEEL, should be struck out as may be required.

I have to report that the undermentioned Iron or Steel Forgings or Castings, manufactured by Mr. J.L. Foster

of Pallionfor the Vessel No. 508, being builtby Messrs. Charles S.B. & Co. of Hull

have been inspected by me as set forth below and found to be, so far as can be seen, Sound

Mark on Forgings.

Lloyd's

No. 6087A


F.C.

Frank R. Hooker


Sunderland.
20.9.05

	STERN FRAME.	RUDDER FRAME.	STEM.
Material*	<u>Scrap.</u>	<u>Scrap.</u>	
How made	<u>Forged.</u>	<u>Forged.</u>	
Dimensions	<u>6" x 3"</u>	<u>4 1/2 to 3 1/2 x 3"</u>	
Progress on Inspection	<u>Forged & smithed</u>	<u>Forged & smithed</u>	
Date when Inspected	<u>27/4/05 to 31/5/05 12/7/05 to 18/8/05</u>		

SKETCHES OF FRAMES SHOWING POSITION AND DESCRIPTION OF WELDS OF FORGINGS, OR PARTICULARS OF TESTS APPLIED TO CASTINGS.

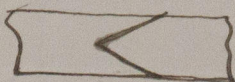

Welds.

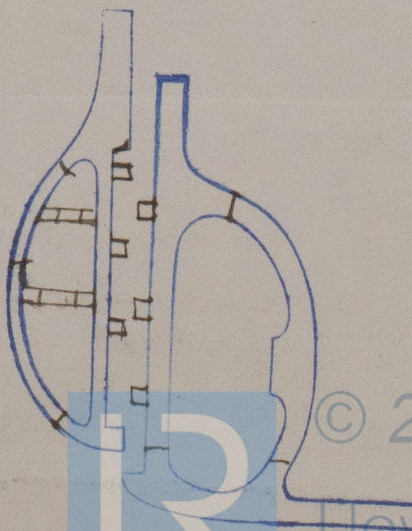

Fee (if any chargeable) £

To be paid at