

— No 508 — STEAM FISHING TRAWLER. —

— SCALE 1/2" = ONE FT. —

— MIDSHIP SECTION —

DIMENSIONS 123'6" B.P.P 22'0" EX x 12'4 1/2" MOULD


DIMENSIONS PER L.R. 122'38" x 21'85" x 12'87"

TO CLASS 100 A.1 AT LLOYDS


RAISED QUARTER DECK 65'6"

FOR CLC " 19'0"

HALF BREADTH	10.93
HALF GIRTH	19.66
DEPTH	12.87
	43.46 -- 1ST NO
	122.38
	347.68
	13038
	8692
	8696
	4346
	53190348 2ND NO

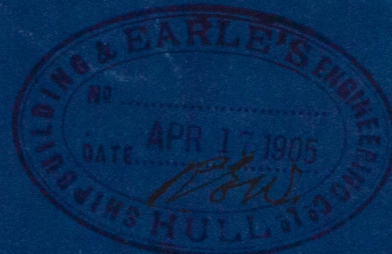

20.4.05

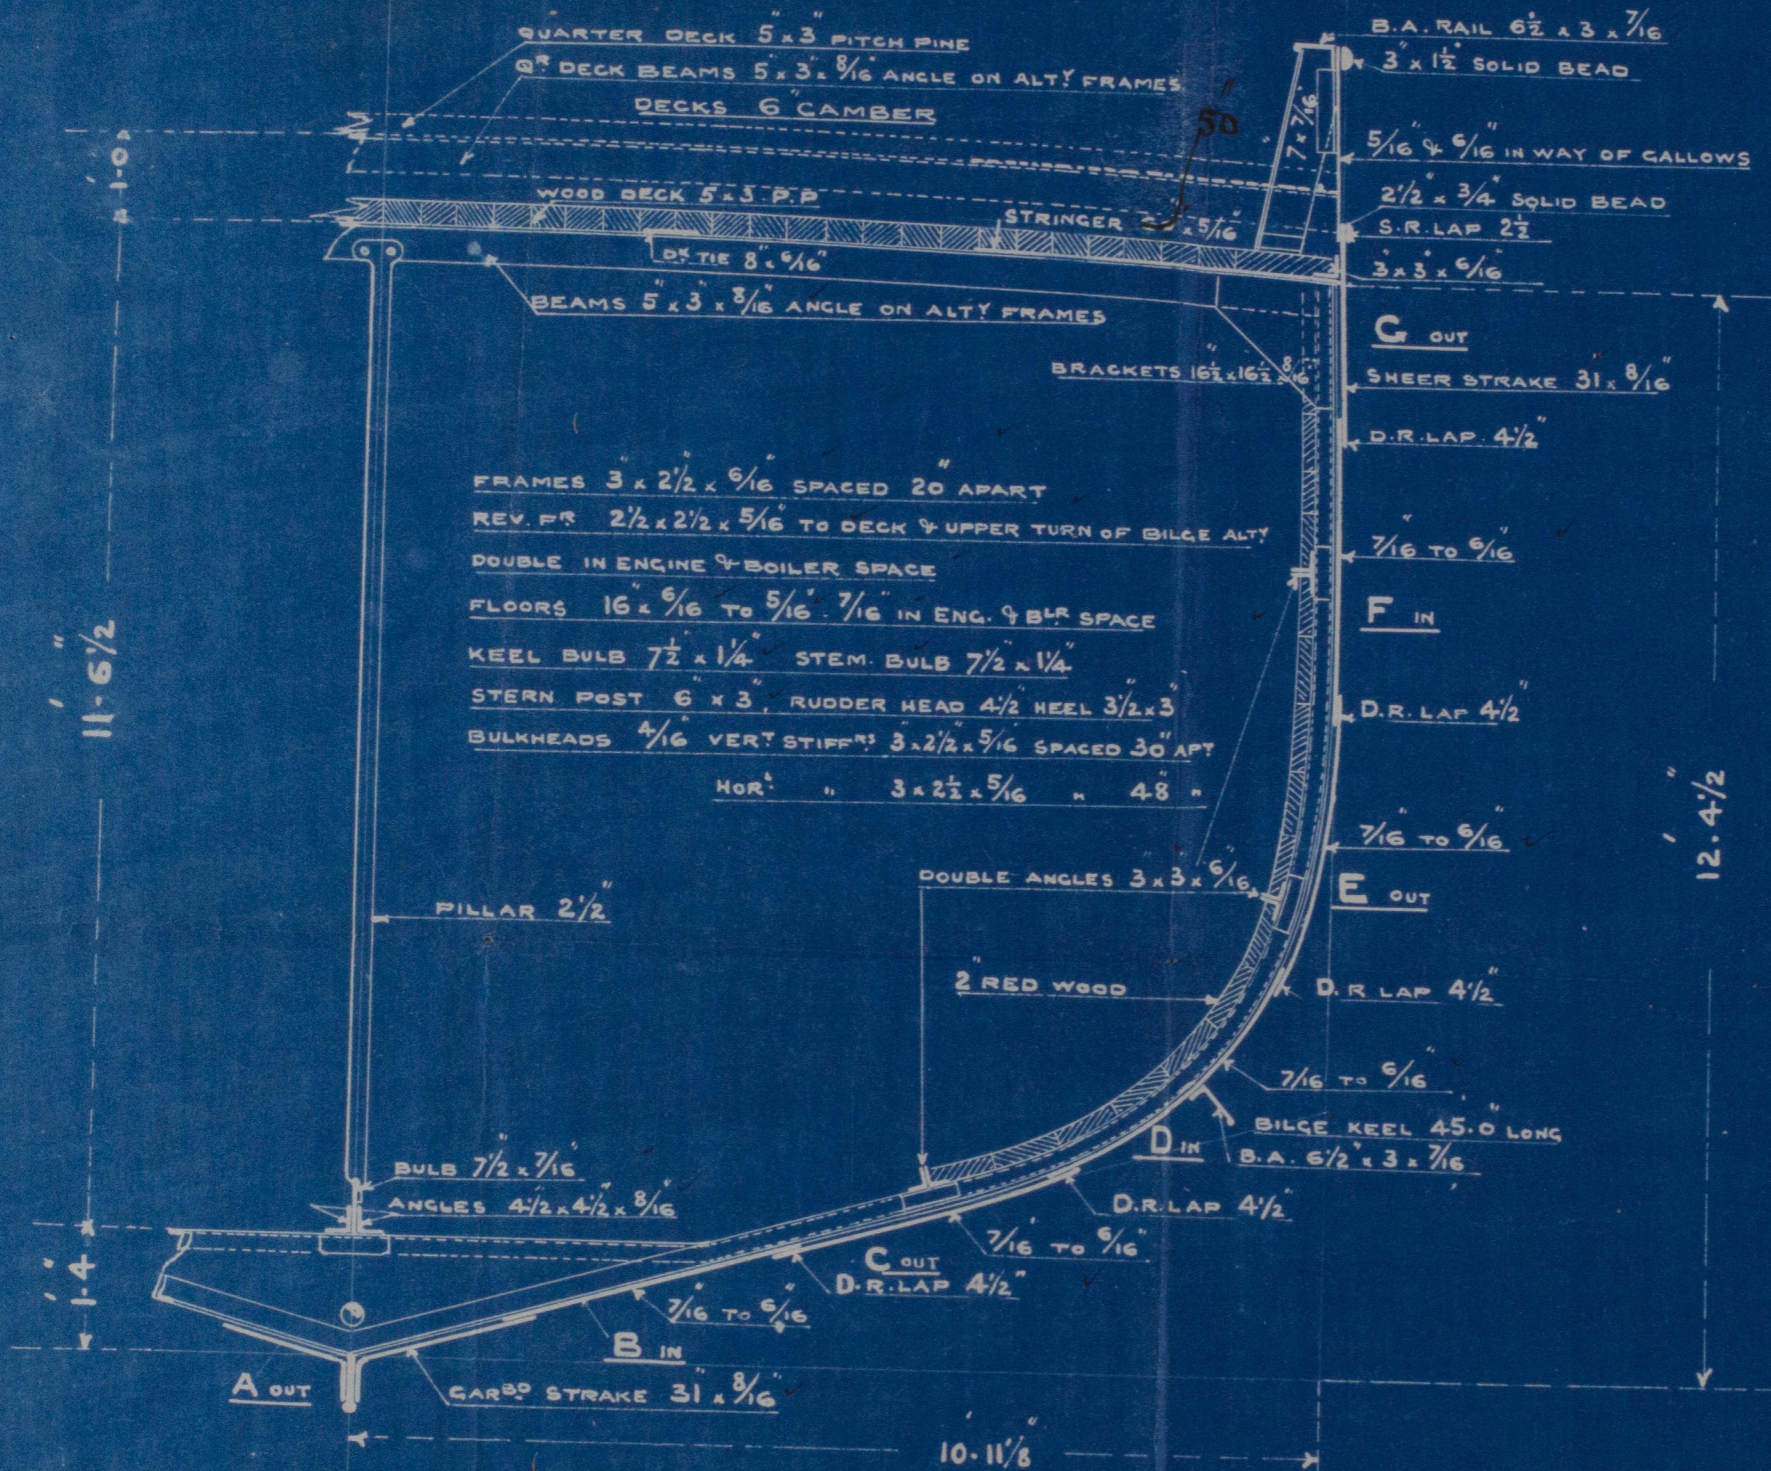

BUTTS OF 4 STRAKES OF SHELL
B, C, D & E TO BE LAPPED & DOUBLE RIV'D
BUTTS OF SHELL A, F & G TO BE STRAPPED
WITH DOUBLE RIV'D STRAPS 1/16" THICKER
THAN PLATES THEY CONNECT
BULWARK PLATES STRAPPED & S. RIV'D

- EQUIPMENT -

ANCHORS EX STOCK 5 1/2 - 5 AND 2 3/4
105 FATHOMS OF 1 1/16" CHAIN CABLES
60 " " 6" HAWSER
60 " " 4 1/2" WARP




© 2020

Lloyd's Register
Foundation


WHL-0204

Charles & B. & Co's
No. 508

Midship Section

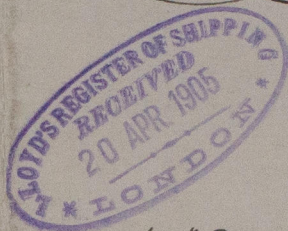

s/s "Deveron"
Hull Report No. 17382

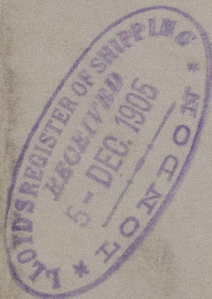

RETAIN



© 2020

Lloyd's Register
Foundation

W1242-0264