

20.4.05

TO CLASS 100A1 AT LLOYDS



Nº 508

STEAM FISHING TRAWLER


PROFILE AND DECK PLAN

SCALE 1/4" = ONE FT


DIMENSIONS 123'6" x 22'0" EX x 12'4 1/2" MOULDED

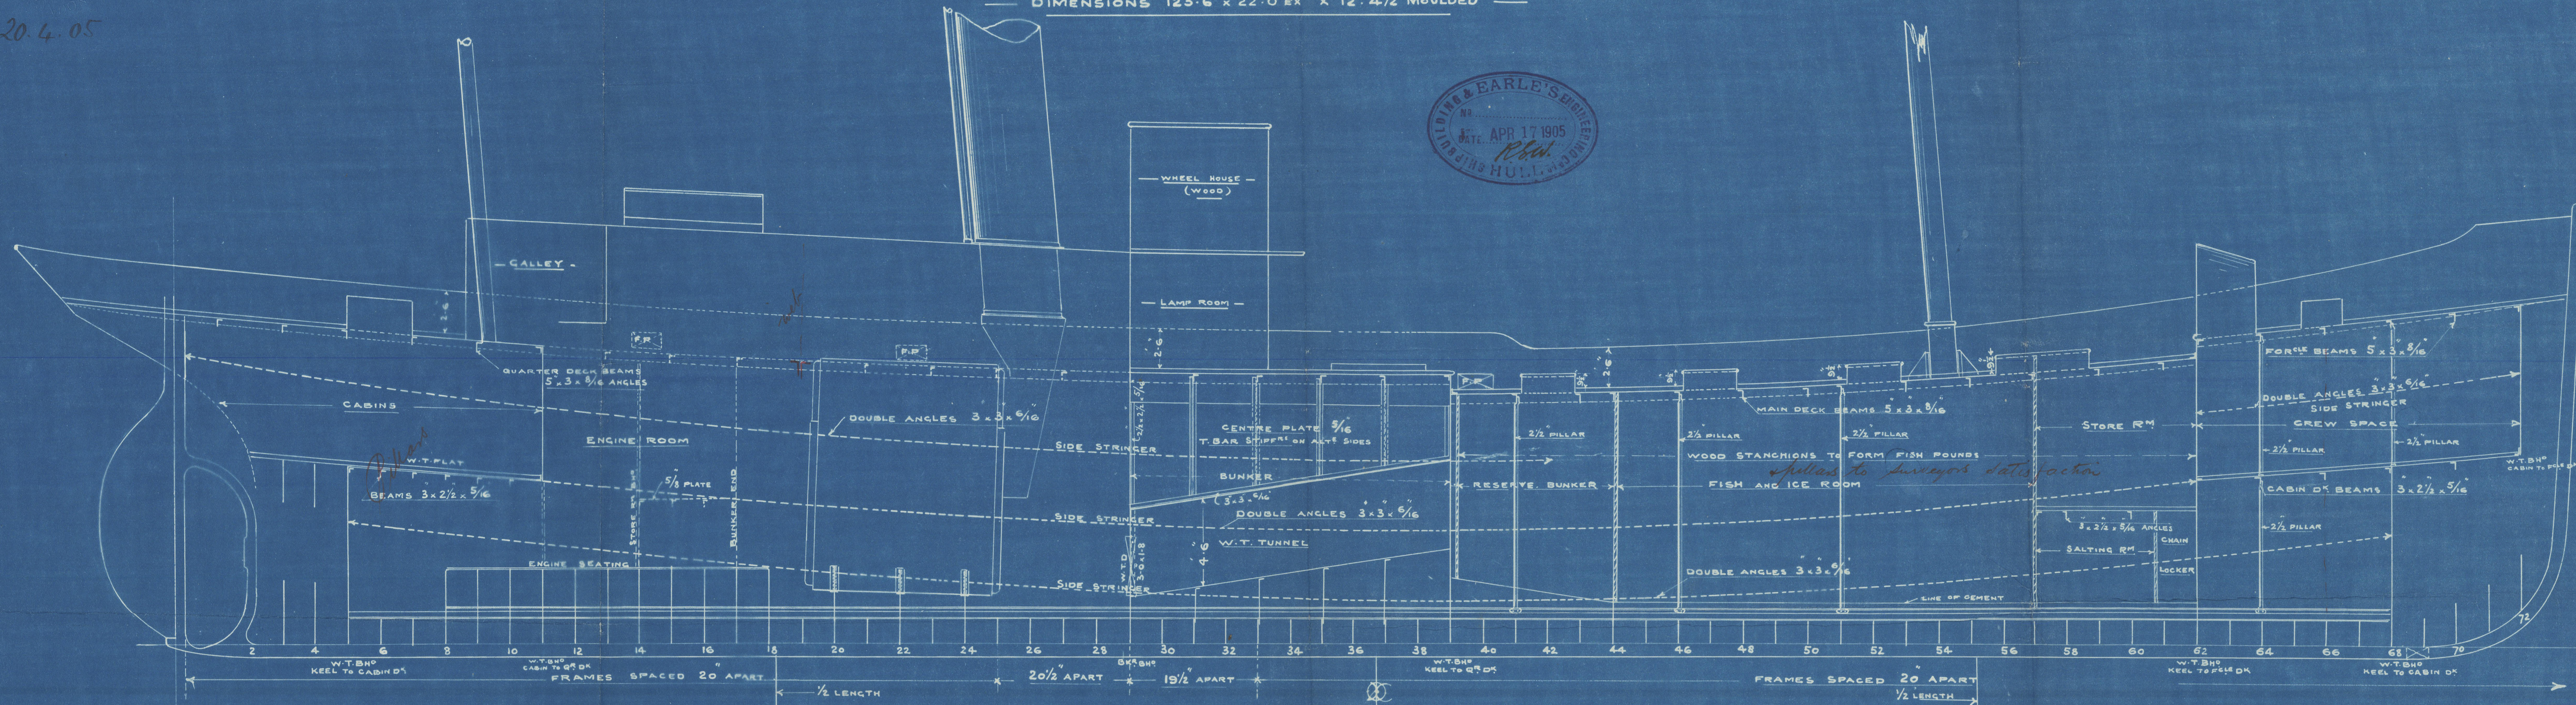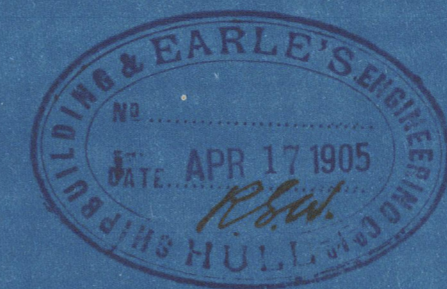

PLAN OF QUARTER, MAIN & FORCE DECKS

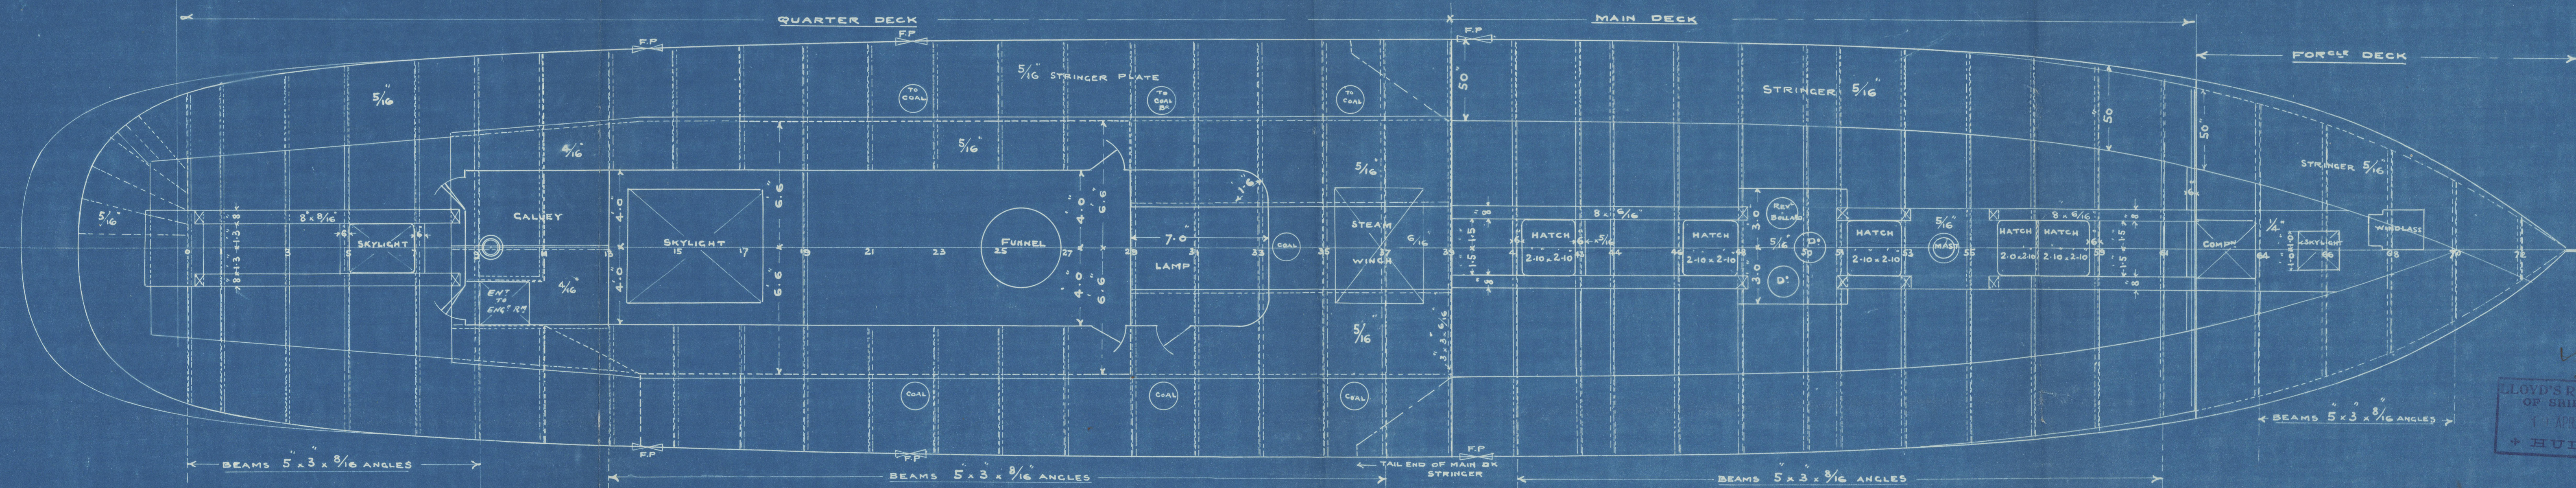


BUTTS OF STRINGER PLATES LAPPED & DOUBLE RIVETED
BUTTS OF TIE PLATES " " " "

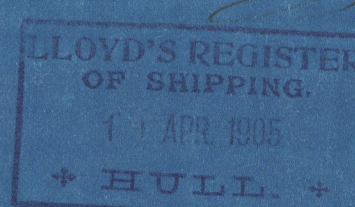

20.4.05

Charles S. B. Co's
No. 508
Profile & Deck plan

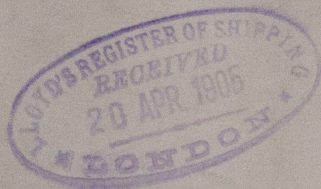

s/s "Deveron"
Hull Report No. 17382

W1242-0266



© 2020

Lloyd's Register
Foundation