

1.8.12
29.8.12
13.9.12
30.9.12
9-6.13.

SS 641

MIDSHIP SECTION


390-0 B P x 50-4 M^L x 30-5 M^L

TO CLASS '100A1 LLOYDS

SCALE $\frac{1}{2}$ = 1 FOOT

NUMERALS

| | | |
|-----------------------------|-----------------|-------------------|
| BREADTH | M ¹⁰ | 50.33 |
| DEPTH | " | 30.42 |
| TRANSVERSE | N ^o | 80.75 |
| LENGTH | | 389.75 |
| LONGITUDINAL N ^o | | 314.72 |
| DEPTH d = | | 18.11 |
| DEPTHS TO LENGTH | | 12.8 TO UPPER Dk |
| | | 10.3 TO BRIDGE Dk |

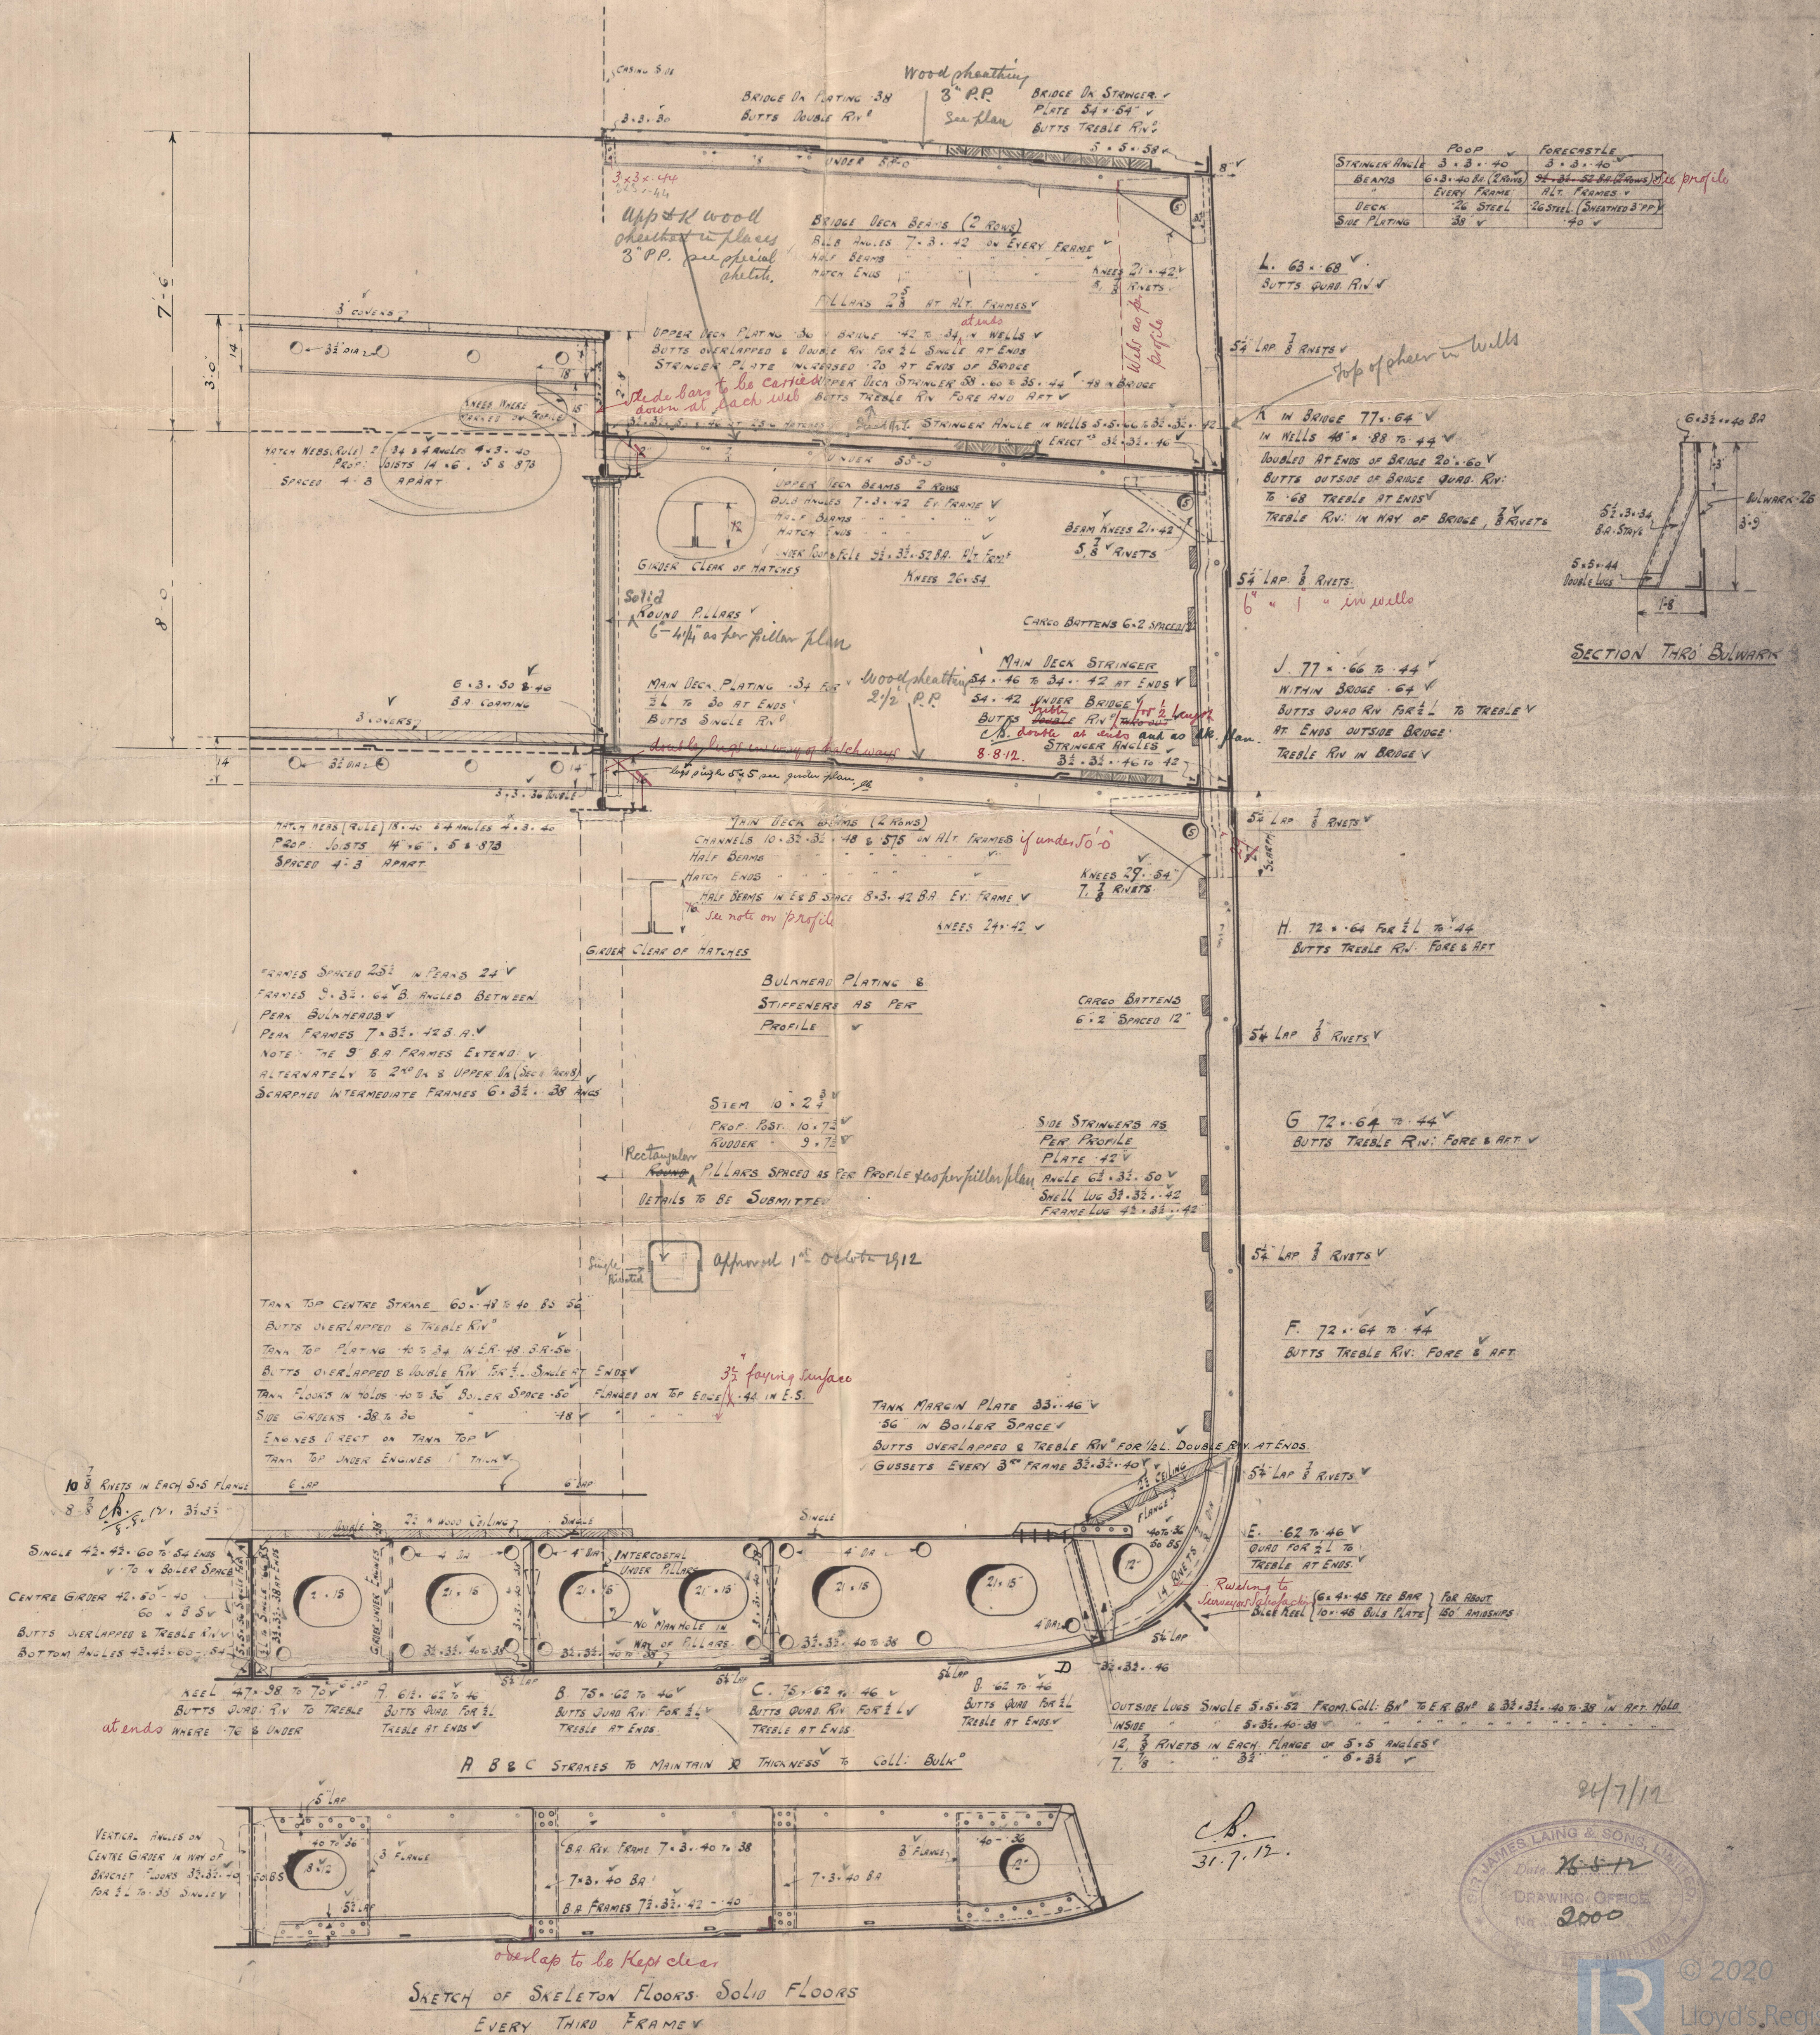

26/7/12

C.B.
31.7.12



A circular purple ink stamp from James Laing & Sons, Limited, Drafting Office. The stamp contains the text "JAMES LAING & SONS, LIMITED" around the top arc and "DRAUGHTING OFFICE" around the bottom arc. In the center, there are two lines of text: "Date" followed by the handwritten date "18-5-12" and "No." followed by the handwritten number "2000".

© 2020
Lloyd's Register
243-0261

Mid. Section

Saings

641

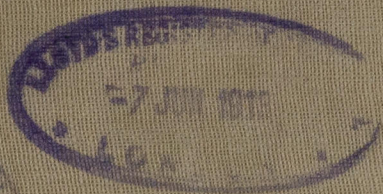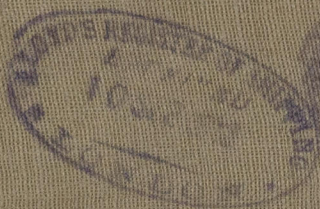

S.S. "NOVGOROD"
SLD RPT. N° 25735.



W1213-0201



© 2020

Lloyd's Register
Foundation