


No 2234.

GREAT CENTRAL RAILWAY STEAMER.

PROFILE.


SCALE  $\frac{1}{8}$ " = 1 FOOT.

10.10.05  
20.12.05  
3.1.06  
13.1.06  
7.2.06

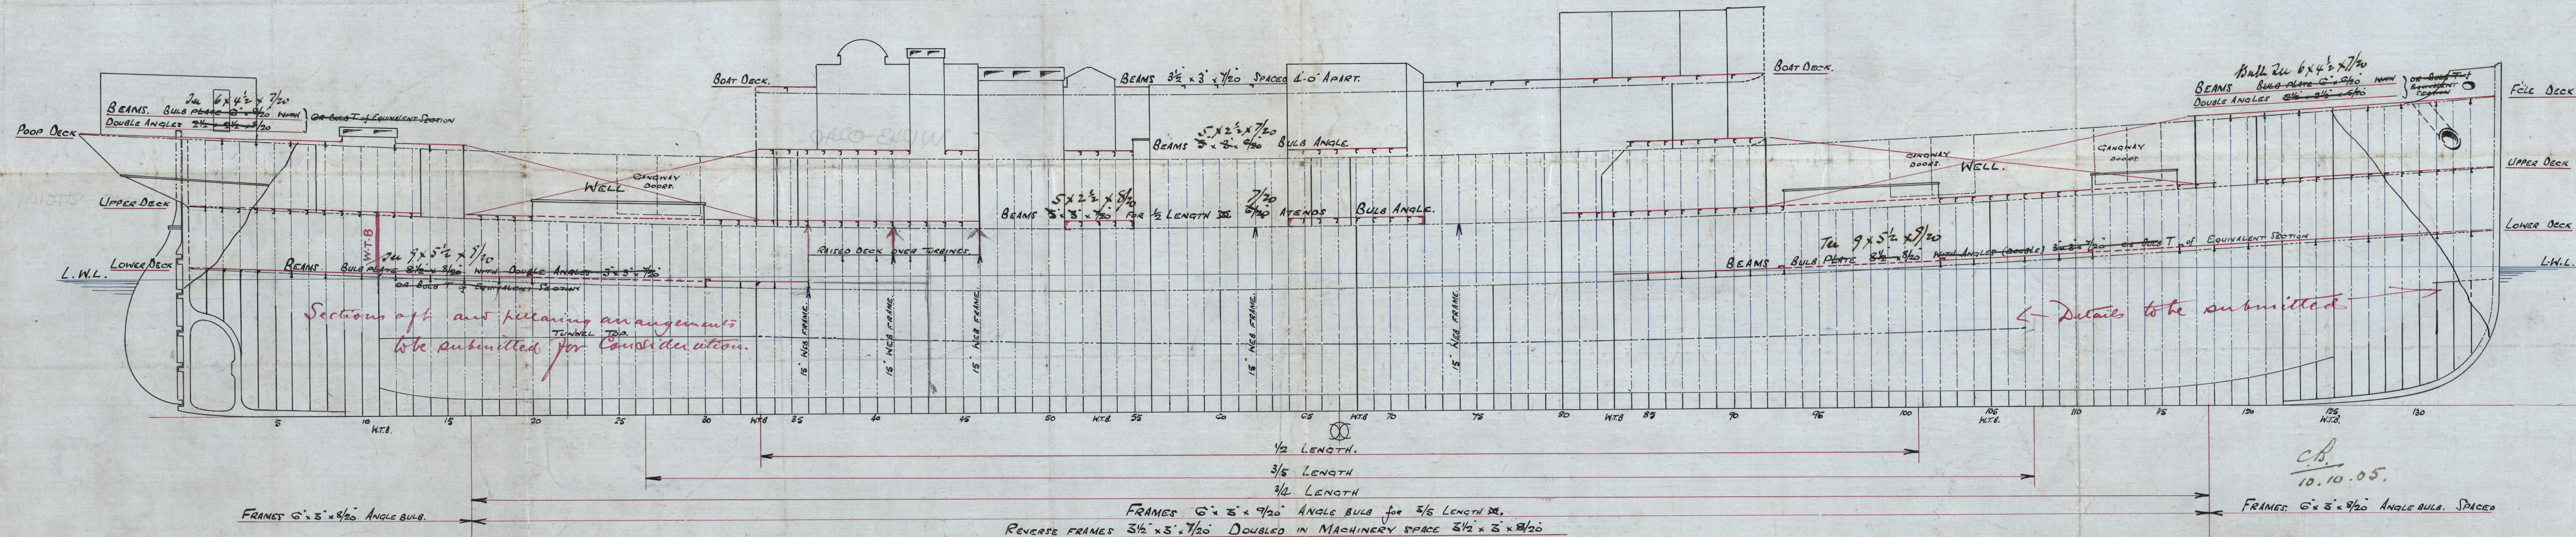




670

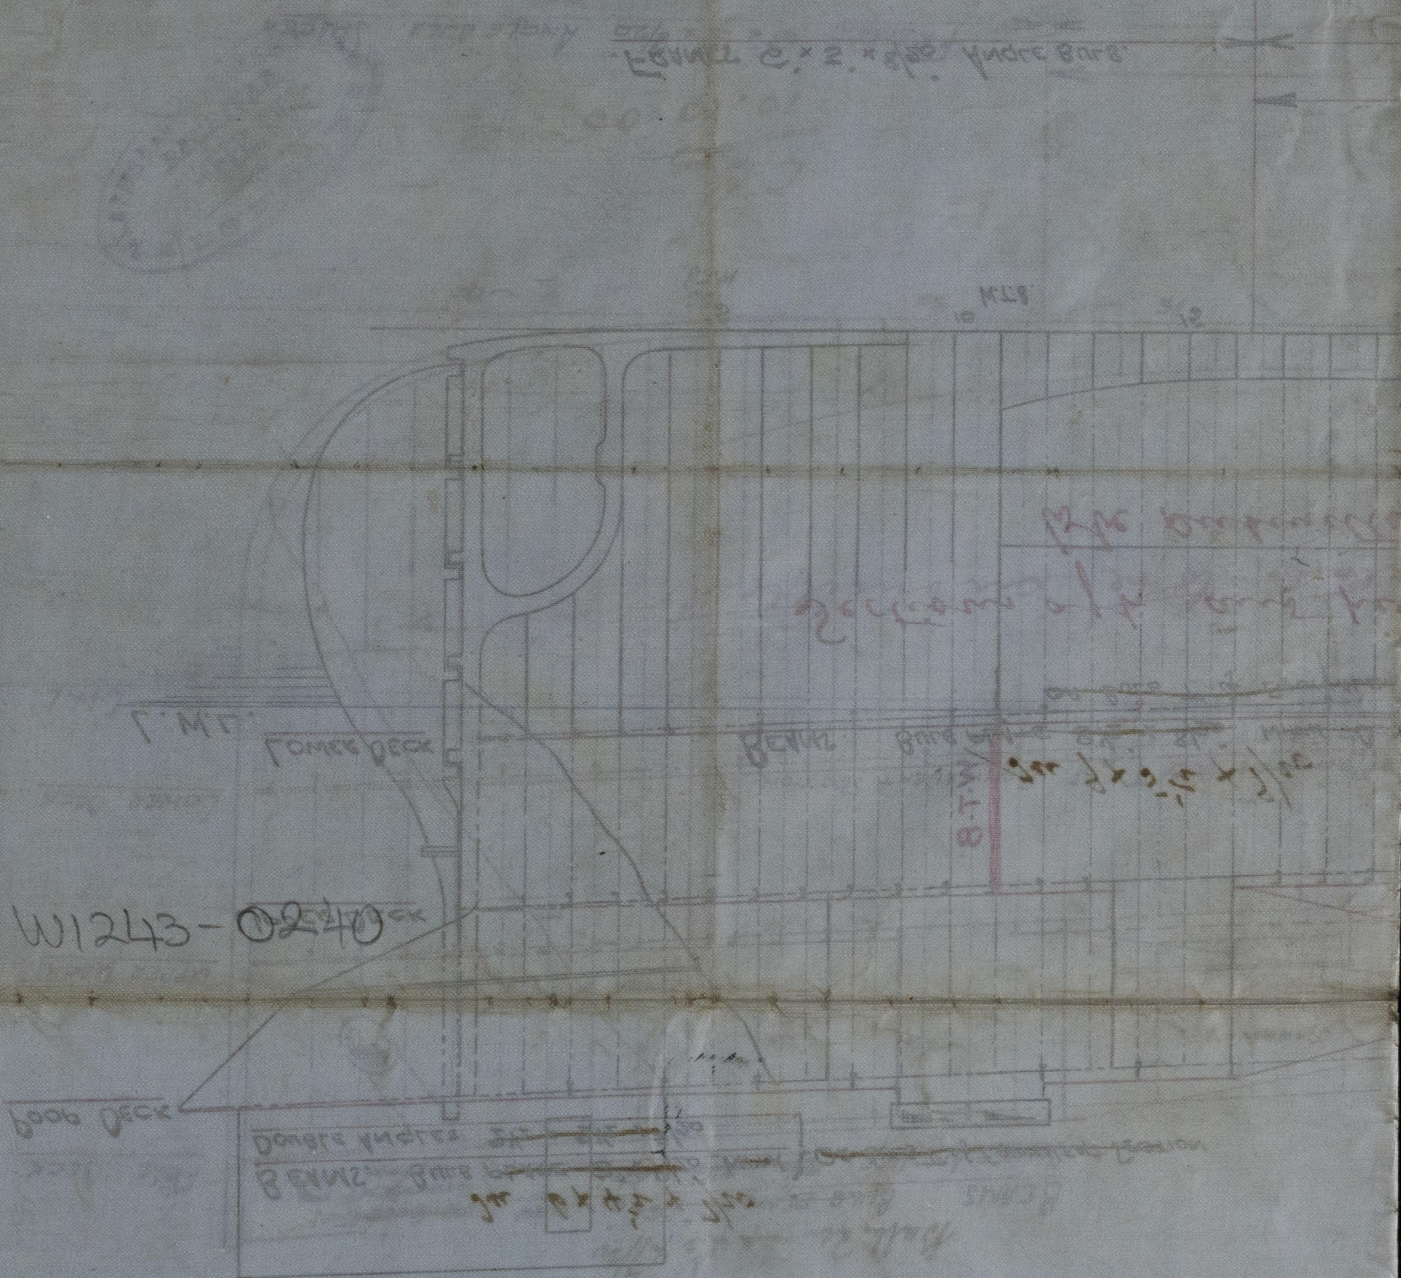

1. 5. 00  
10. 1. 00  
3. 1. 00  
20. 12. 02  
10. 10. 02

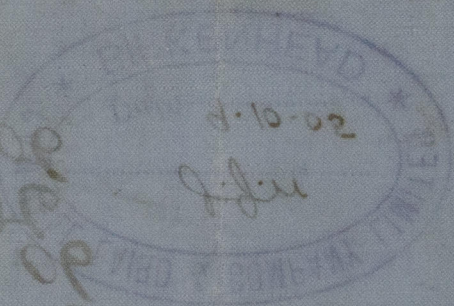






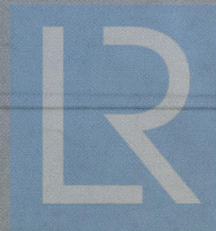

© 2020

Lloyd's Register  
Foundation



5/ MARYLEBONE


Marylebone Land No  
No 670

Profile Plan

Qiv Rpt No 58760

~~Hull Rpt No 23942~~

PLAN

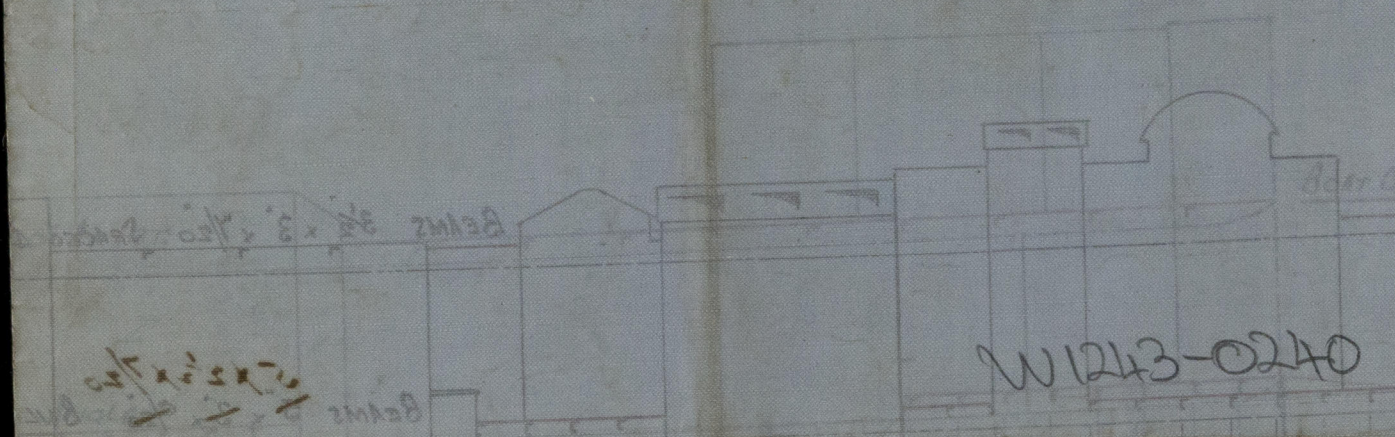

W1243-0240



© 2020

Lloyd's Register  
Foundation