

# MIDSHIP SECTION.

LENGTH BP 350'-0" BREADTH EX 51'-0 1/2" DEPTH M<sup>d</sup> 26'-3".


SCALE 1/2" = ONE FOOT.

CLASS 100.A.1. AT LLOYDS.

SHELTER DECK.

FORECASTLE DECK	= 32'-6" x 7'-6"
FORECASTLE DECK BEAMS (SEE PROFILE)	
BEAM KNEES	= 20" x 40" x 5-3/4" RIVETS.
STRINGER PLATE	= 33" x 3/4"
STRINGER ANGLE	= 3 1/2" x 3 1/2" x 3/4"
STRINGER BUTTS	DOUBLE RIVETED OVERLAPS.
STEEL DECK (WOOD SHEATHED)	= 25" x 30" under keel.
SIDE PLATING	= 40" DOUBLE RIV OVERLAPS
STANCHION 2 FRAMES APART	= 2 1/2" DIAM.

SHELTER DECK STRINGER 50" x 52 FOR 1/2 LT TO 33" x 42.  
BUTTS TREBLE RIVETED THROUGHOUT.  
STEEL DECK 3/4" TO 3/2".  
HATCH CORNERS DOUBLED.  
STRINGER ANGLE 4 1/2" x 4 1/2" x 5/8 TO 3 1/2" x 3 1/2" x 4/2.

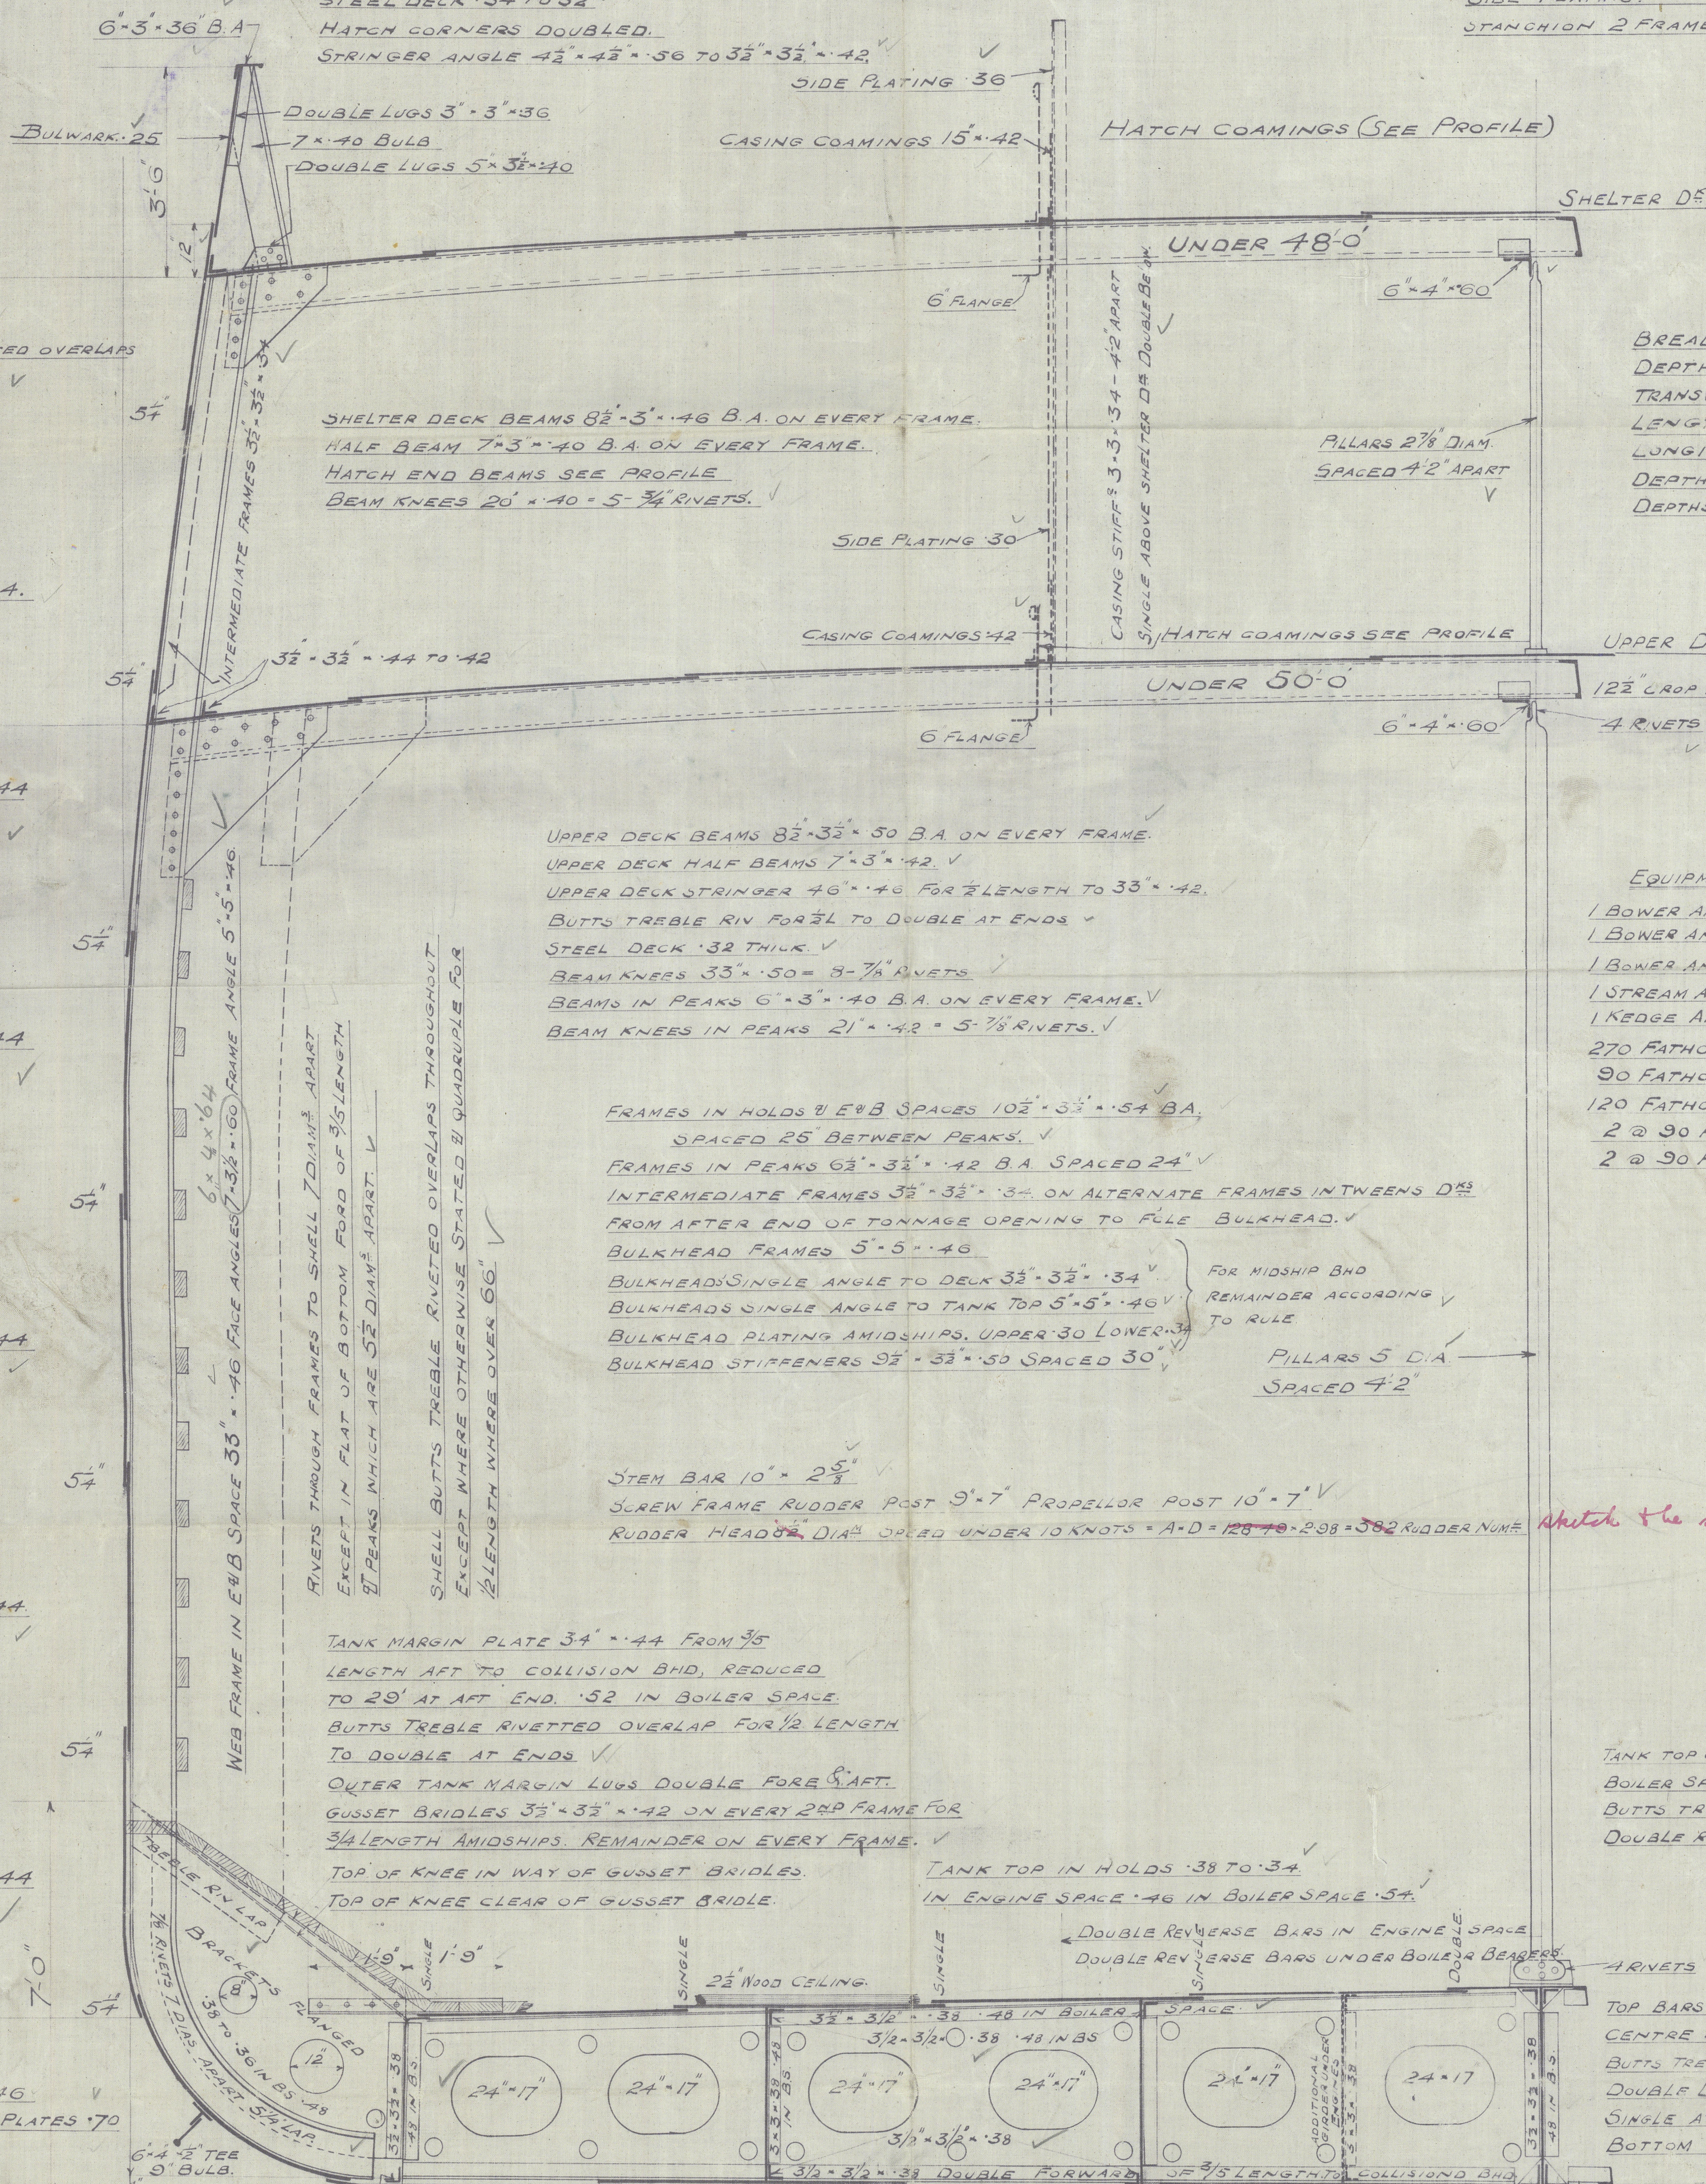

LLOYDS NUMERALS	
BREADTH MOULDED	50.83
DEPTH MOULDED	26.25
TRANSVERSE NUMBER	77.08
LENGTH B.P.	350.00
LONGITUDINAL NUMBER	26978.00
DEPTHS IN LENGTH TO UPPER DECK	13.33
DEPTHS IN LENGTH TO SHELTER DECK	10.22

EQUIPMENT NR = 204 G4	
1 BOWER ANCHOR STOCKLESS	52 1/2 CENTS
1 BOWER ANCHOR STOCKLESS	52 CENTS
1 BOWER ANCHOR STOCKLESS	45 CENTS
1 STREAM ANCHOR EX STOCK	14 CENTS
1 KEDGE ANCHOR EX STOCK	6 CENTS
270 FATHOMS 2 1/16 STUD CHAIN CABLE	
90 FATHOMS 1 3/16 STREAM OR 4 1/2 STEEL WIRE	
120 FATHOMS 1/2 STEEL WIRE TOW LINE	
2 @ 90 FATHOMS 7" WARP MANILLA	
2 @ 90 FATHOMS 7" HANSEN MANILLA	

TANK TOP CENTRE STRAKE 4 1/2" x 48 TO 40"  
BOILER SPACE 54" ENGINE SPACE 48"  
BUTTS TREBLE RIVETED FOR 1/2 LENGTH  
DOUBLE RIVETED AT ENDS.  
TOP BARS 3 1/2" x 3 1/2" x 48 TO 40 BOILER SPACE 58"  
CENTRE KEELSON 4 1/2" x 50 TO 40 BOILER SPACE  
BUTTS TREBLE RIVETED OVERLAP THROUGHOUT  
DOUBLE LUGS 3 1/2" x 3 1/2" x 38 FOR 1/2 LENGTH 48 IN B.S.  
SINGLE AT ENDS.  
BOTTOM BARS 4 1/2" x 42" x 58 TO 54 AT ENDS.

IRVINE'S  
SHIP BUILDING  
AND  
DRY DOCKS CO LTD  
WEST HARTLEPOOL

N<sup>os</sup> 542. & 3.

Ct.  
12.12.13

C.B.



Midship Section  
Irvine SB & SD Colin.


Nos 542 & 3.

542: 1/5 " Hambleton Range "

West Hartlepool report No. 14972.

543: 1/5 " Cheviot Range "

West Hartlepool report No. 15012

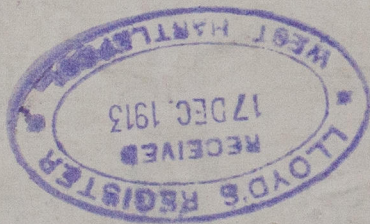

RETAIN



© 2020

Lloyd's Register  
Foundation

W1247-0299