


180 LBS WORKING PRESSURE TOLLOYS

[illegible]

Heating Surface	
Tubes	826 $\frac{1}{2}$
Furnaces	64 "
Combustion Chambers	104 "
Back Tube Plates	30 "
Front " "	30 "
Total Heating Surface	1054 "
Grate area	30 "

Stays marked S
are $1\frac{3}{4}$ dia
screwed in threads
off dia = 1.63"
off area = 2.1 sq in

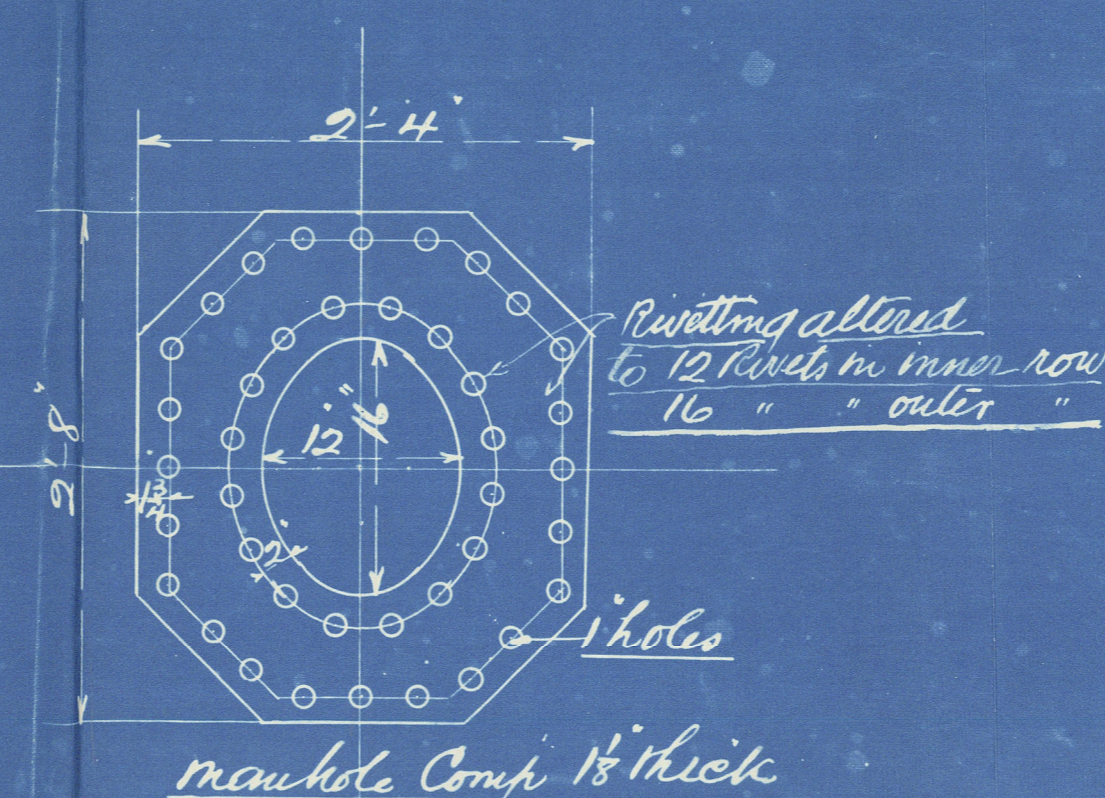

2 1/2 Steel Stay
16 Rivetted w/
3/8" thick

Nº A 7 A38
A8 A42
A9 A44
A14
A16



Bolton N^o. A44

Great Central Co. op.
Eng^g. Ship Repair^g.
Ch^d. GRIMSBY

for
stm. trawler
Elie Chenieriere

Ans. N^o. 8459

This boiler was
subsequently removed
& refitted (1930) into
another trawler of
same name. The
above report has been
attached to Ans. repl.
No. 12044 (F.E.)

J.M.
30.12.30



RETAILED



© 2021

Lloyd's Register
Foundation

W1248-0019