

MIDSHIP SECTION STEEL SCREW TUG N° 636

DIMENSIONS 100' x 23'-6" x 11'-6" MLD

3.10.13.
17.11.13.

CLASS 100A1 TOWING PURPOSES on Coast

BY
HEPPLE & CO. LTD SOUTH SHIELDS

NUMERALS


100 x 23-6 x 11-6 MLD

B + D = 35 1st N° x 100 = 3500 2nd N°

d = 10.44

D to I = 8.6

Equipment as per rule
for tugs.

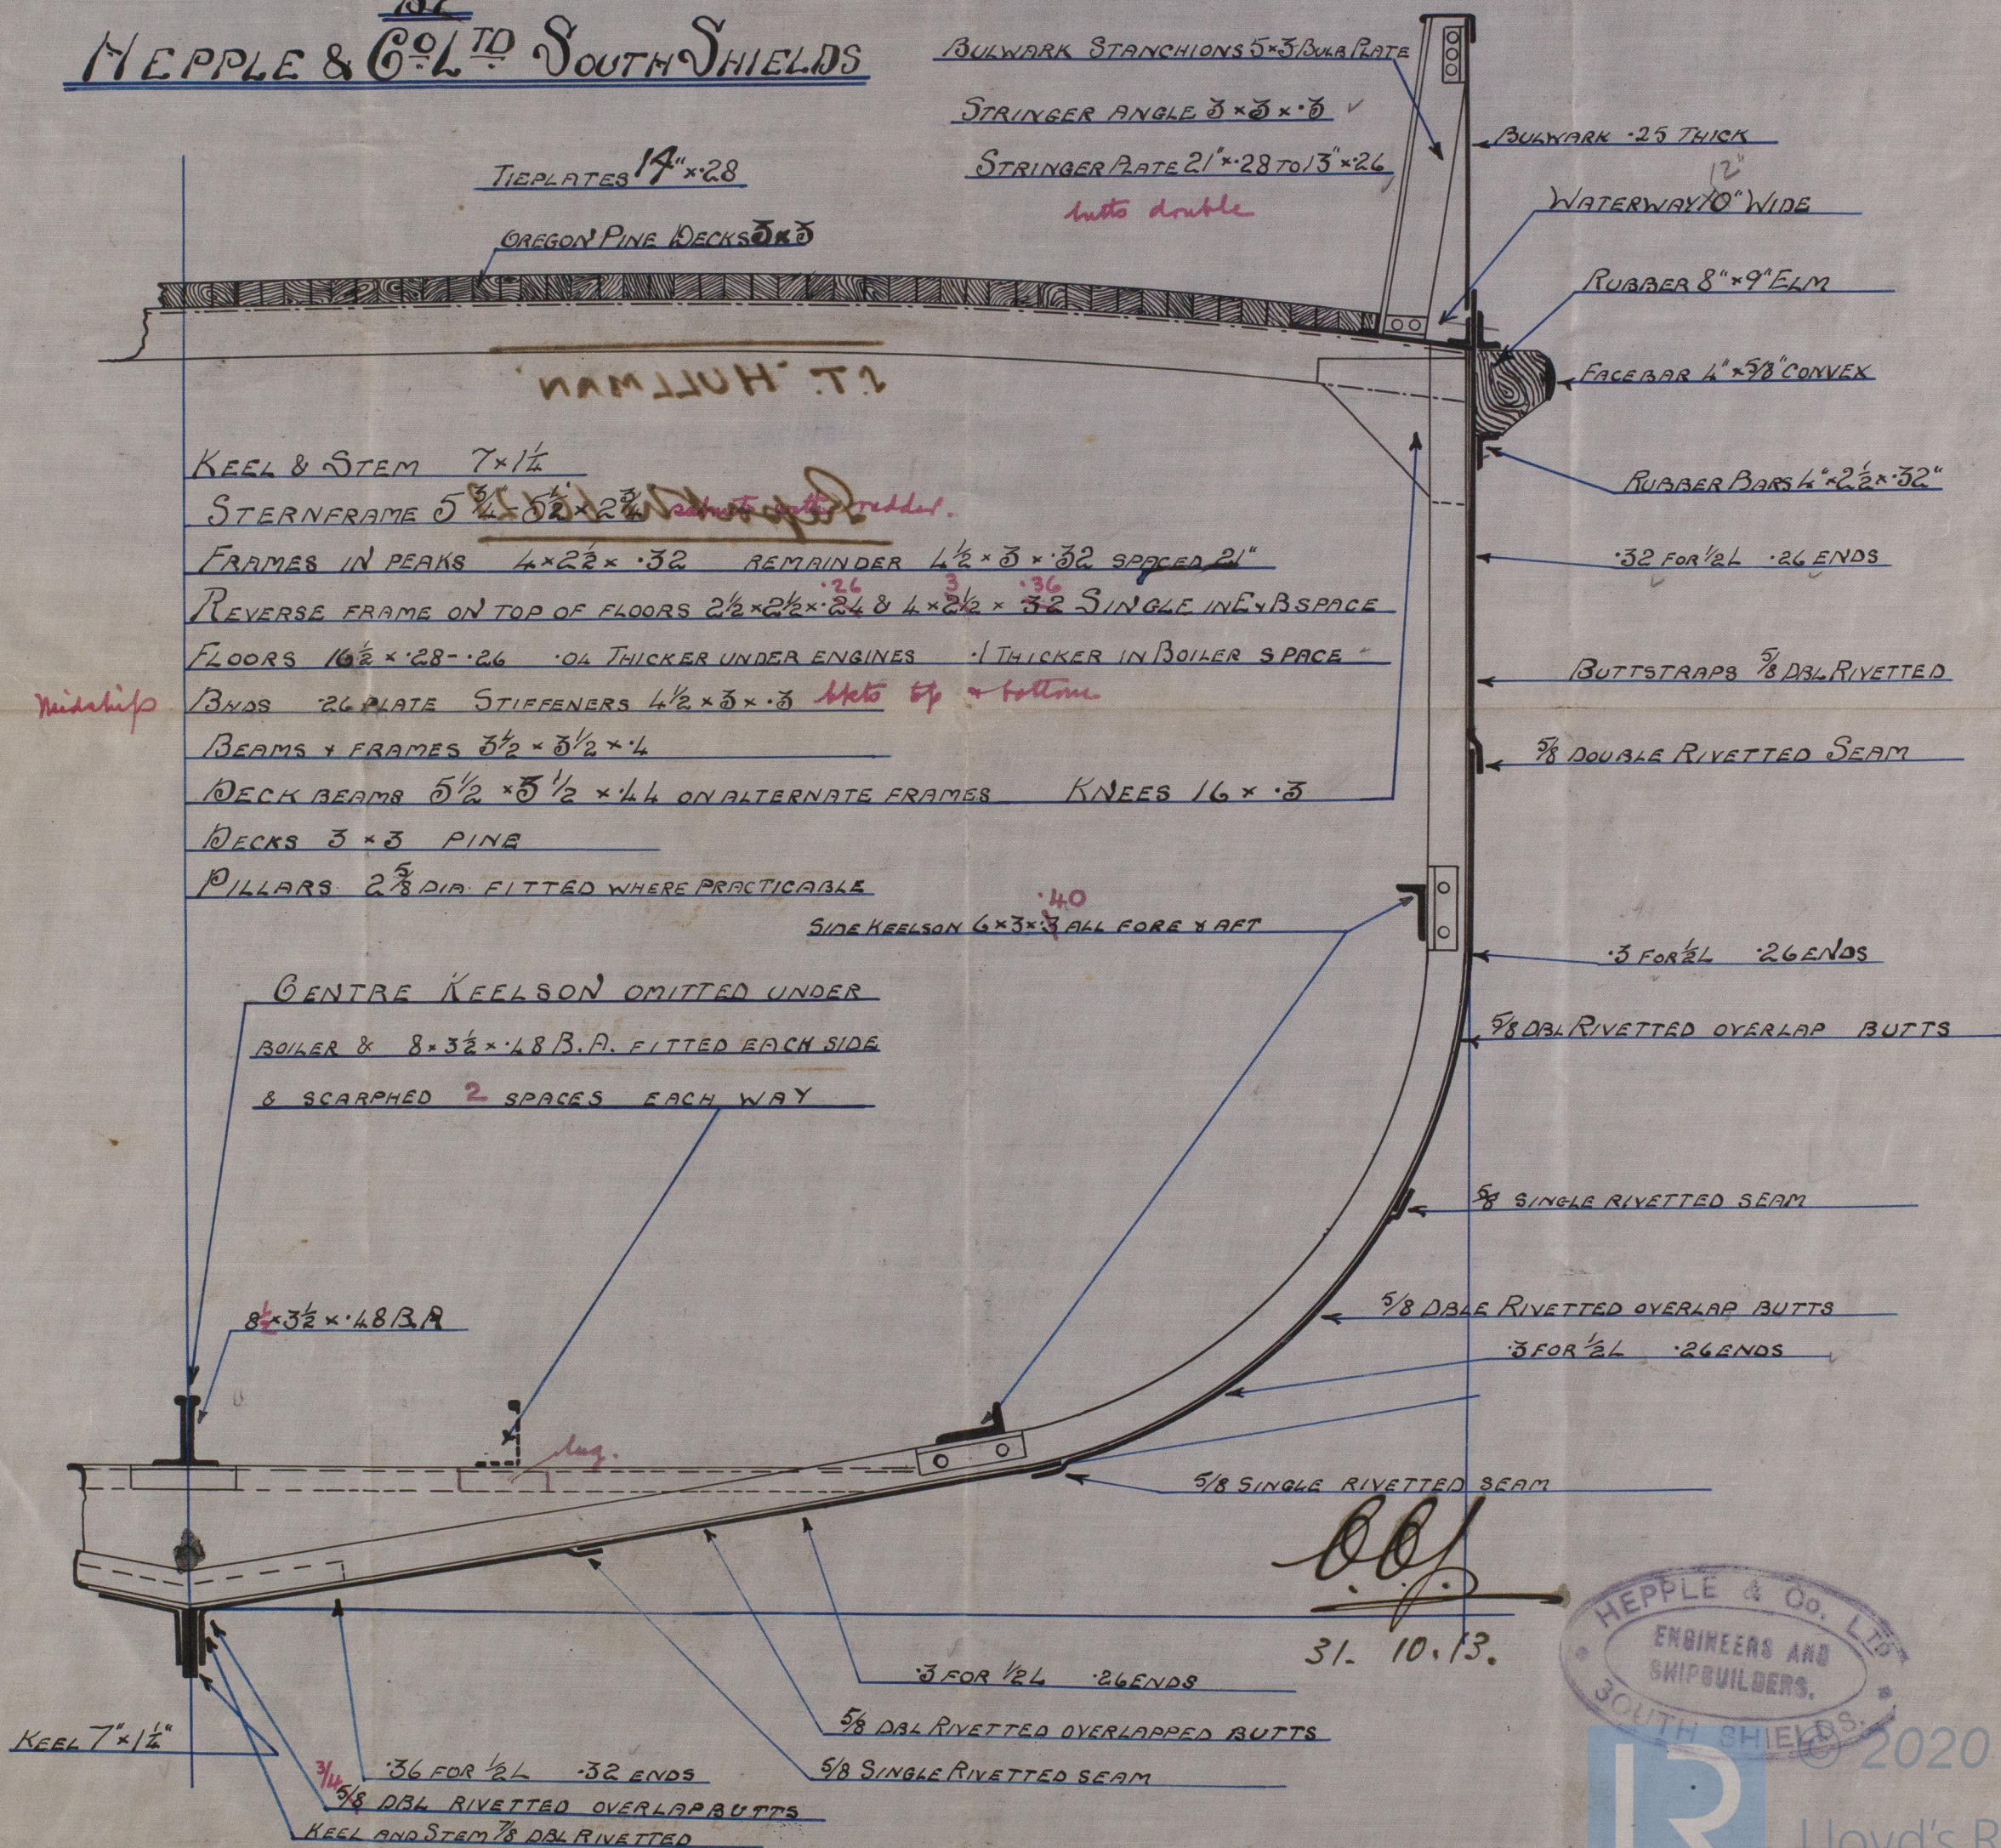

HEPPLE & CO. LTD
ENGINEERS AND
SHIPBUILDERS
SOUTH SHIELDS

Mio-Section.

NEWCASTLE-ON-TYNE

Report No 66128

W1249-6035

© 2020

Lloyd's Register
Foundation