

N^o 109

PROFILE & DECK




DIMS. 76'-8" B.P. x 18'-0" x 9'-0" M^{LD}

TO CLASS A¹ FOR TOWING SERVICES - HARBOUR WORK

SCALE: 1/2" = 1'-0"

FOR W.T. BULKHEADS SEE SEPARATE PLAN

ENGINE SEAT

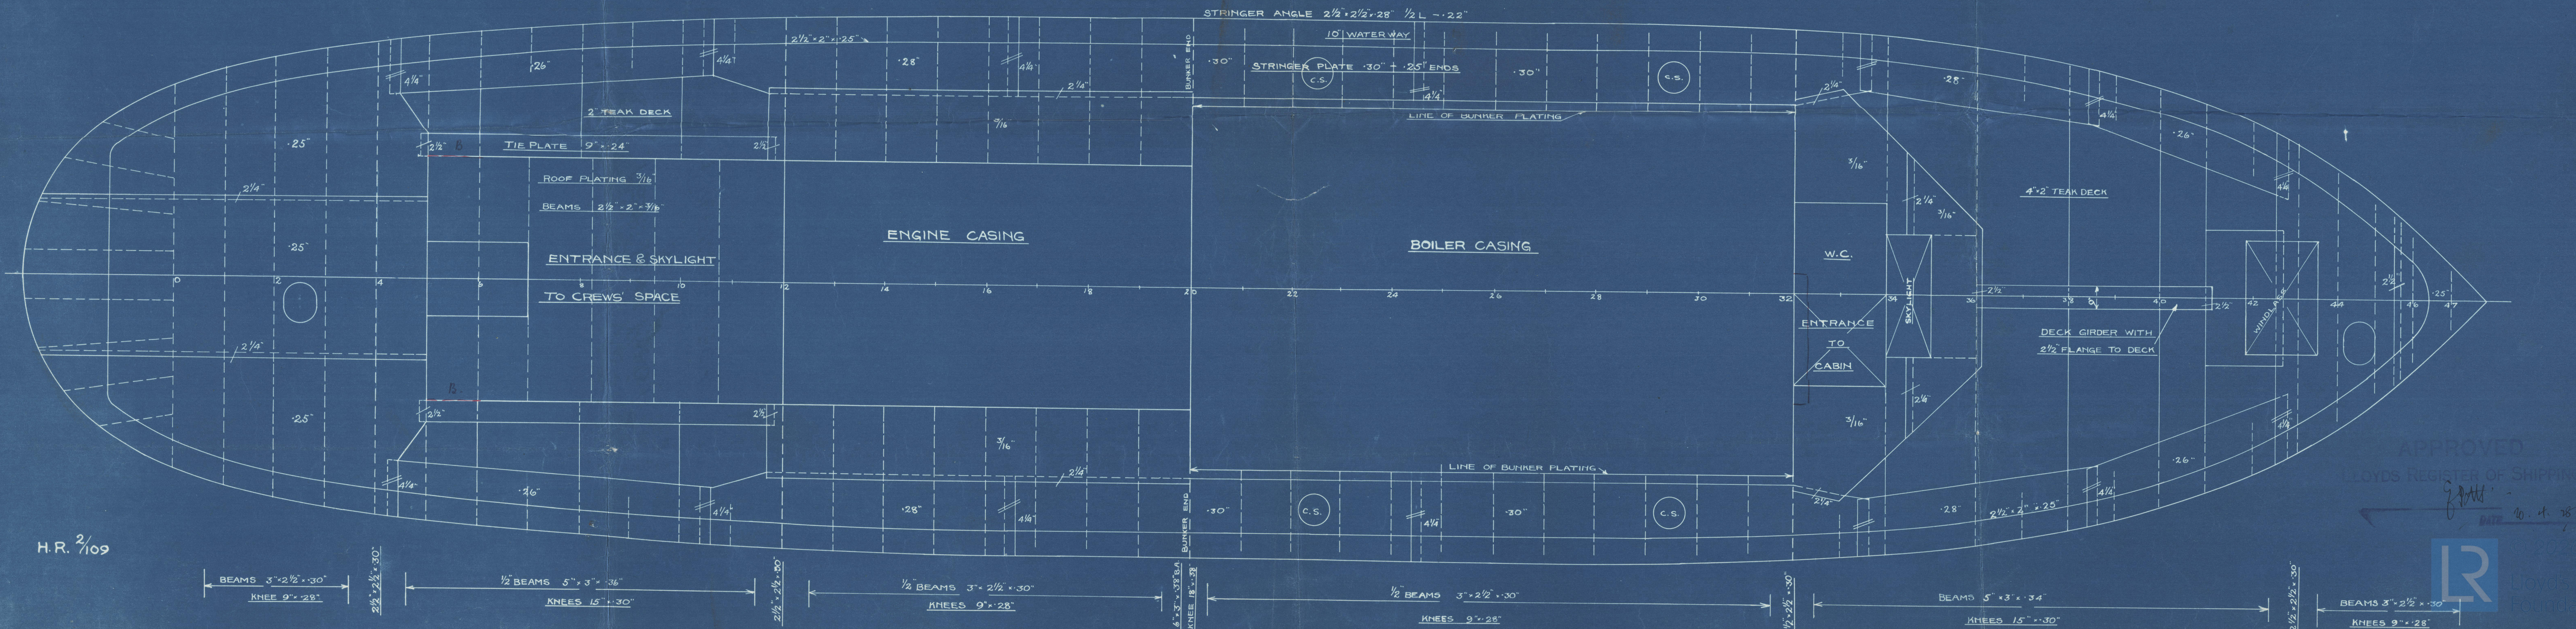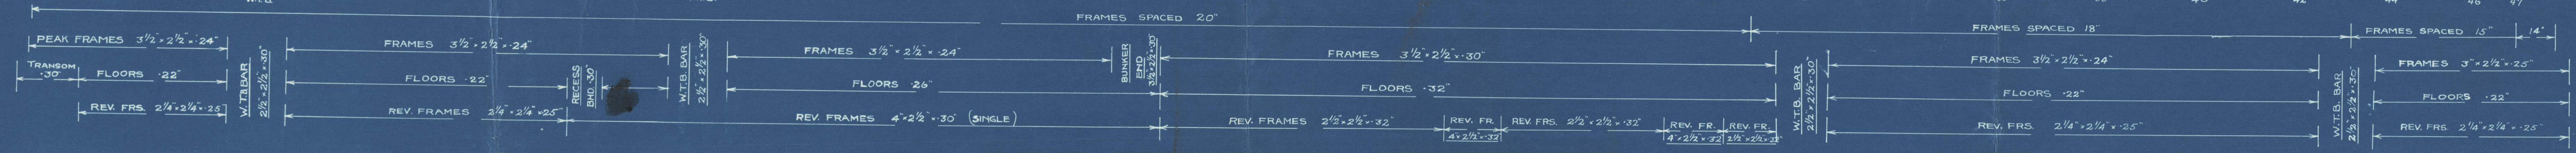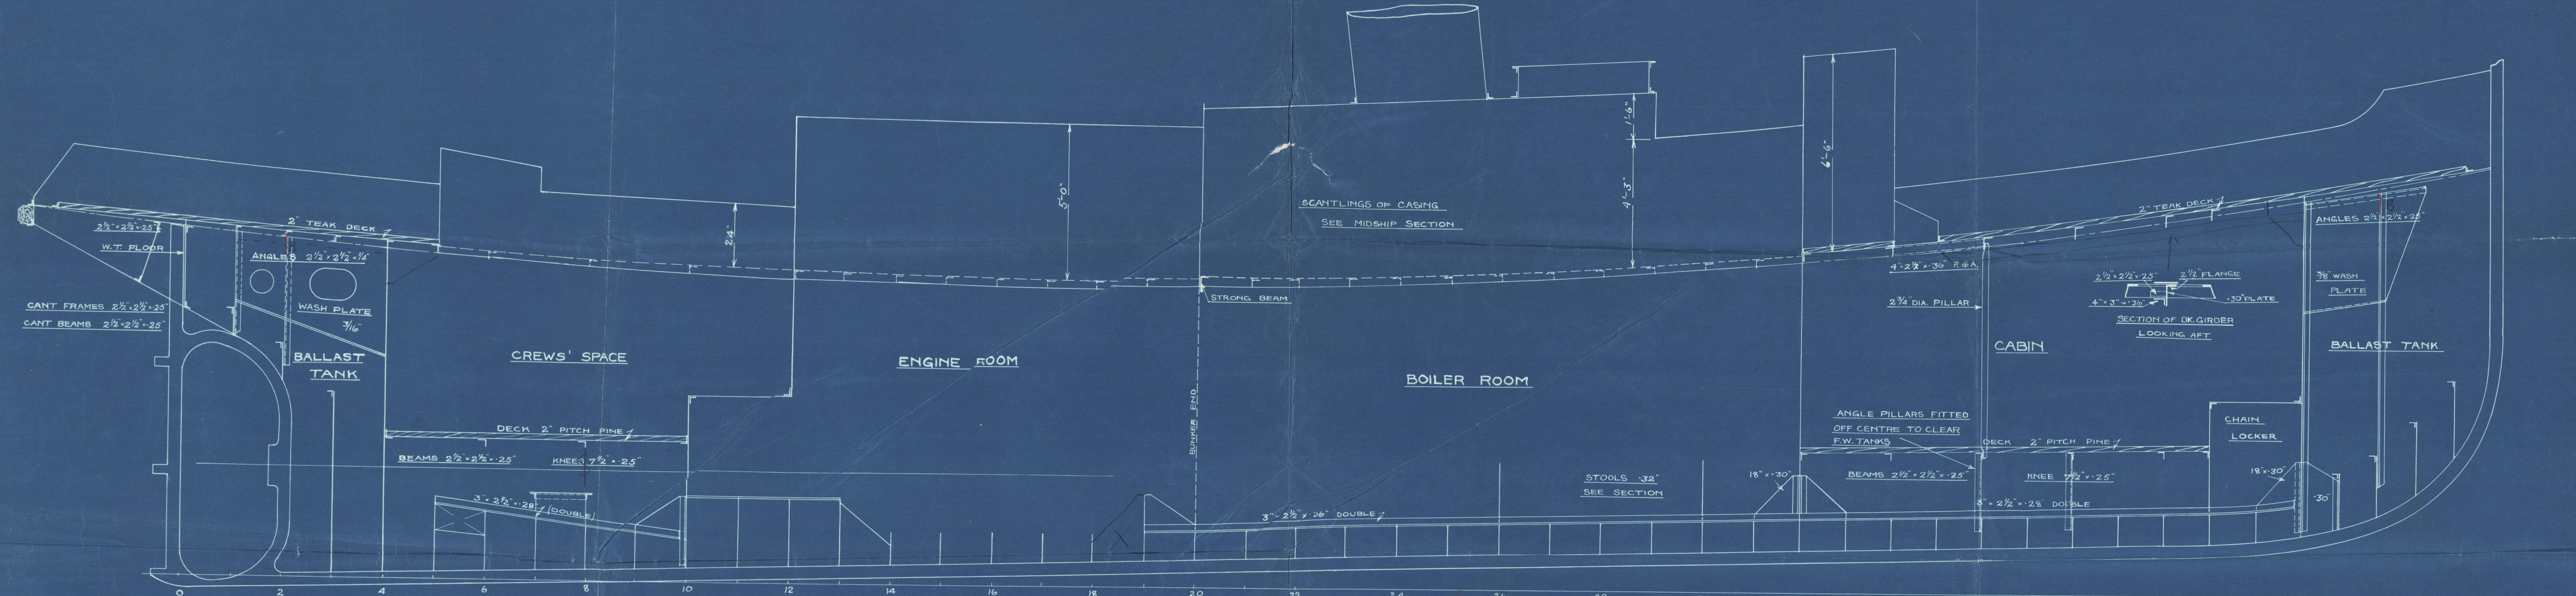

H.R. 2/109

APPROVED
LLOYD'S REGISTER OF SHIPPING



Lloyd's Register of Shipping

MESSRS HENRY ROBIN L⁹
N^o 109

PROFILE + DECIL

8/5 Munda

Al for Waterloo Towing Services

RETAIN



© 2020

Lloyd's Register
Foundation

W1249-0115