

To Lloyd's requirements for a working pressure of 80 lbs per  $\square$ "  
 All plates, rivets, stays, & girders of Steel. Tubes of Wrought Iron.  
 Scale 1" = 1 Foot. R.B.I.

Combustion Chambers: Circumferential + Longitudinal Stems. Furnaces single riveted  $\frac{15}{16}$ " Rivet Holes  $2^{\circ}$  Pitch  $2^{\frac{1}{2}}$ " Lap.

Furnace Fronts to 5<sup>th</sup> DRAWING N<sup>8</sup>

[illegible]

ENG N° 605 Intended for Messrs John Blumer & Co. P.P. N° 182 April 11<sup>th</sup> 1904

DATE \_\_\_\_\_



J. Dickinson & Sons Ltd

No. 665


Donkey Boiler

for

Messrs J. Blumer & Co.,

S. S. No 182

W. P. = 80 lbs

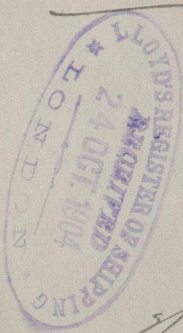

1/2 "Spennymoor"

Sld F.E. No. 22273



© 2020

Lloyd's Register  
Foundation.

W1251-0018