



ASTILLEROS BARREAS  
VAPOR PARA EL GOBIERNO PORTUGUES Nº 157  
CALDERA-MARINA  
ESCALAS 1010-1015

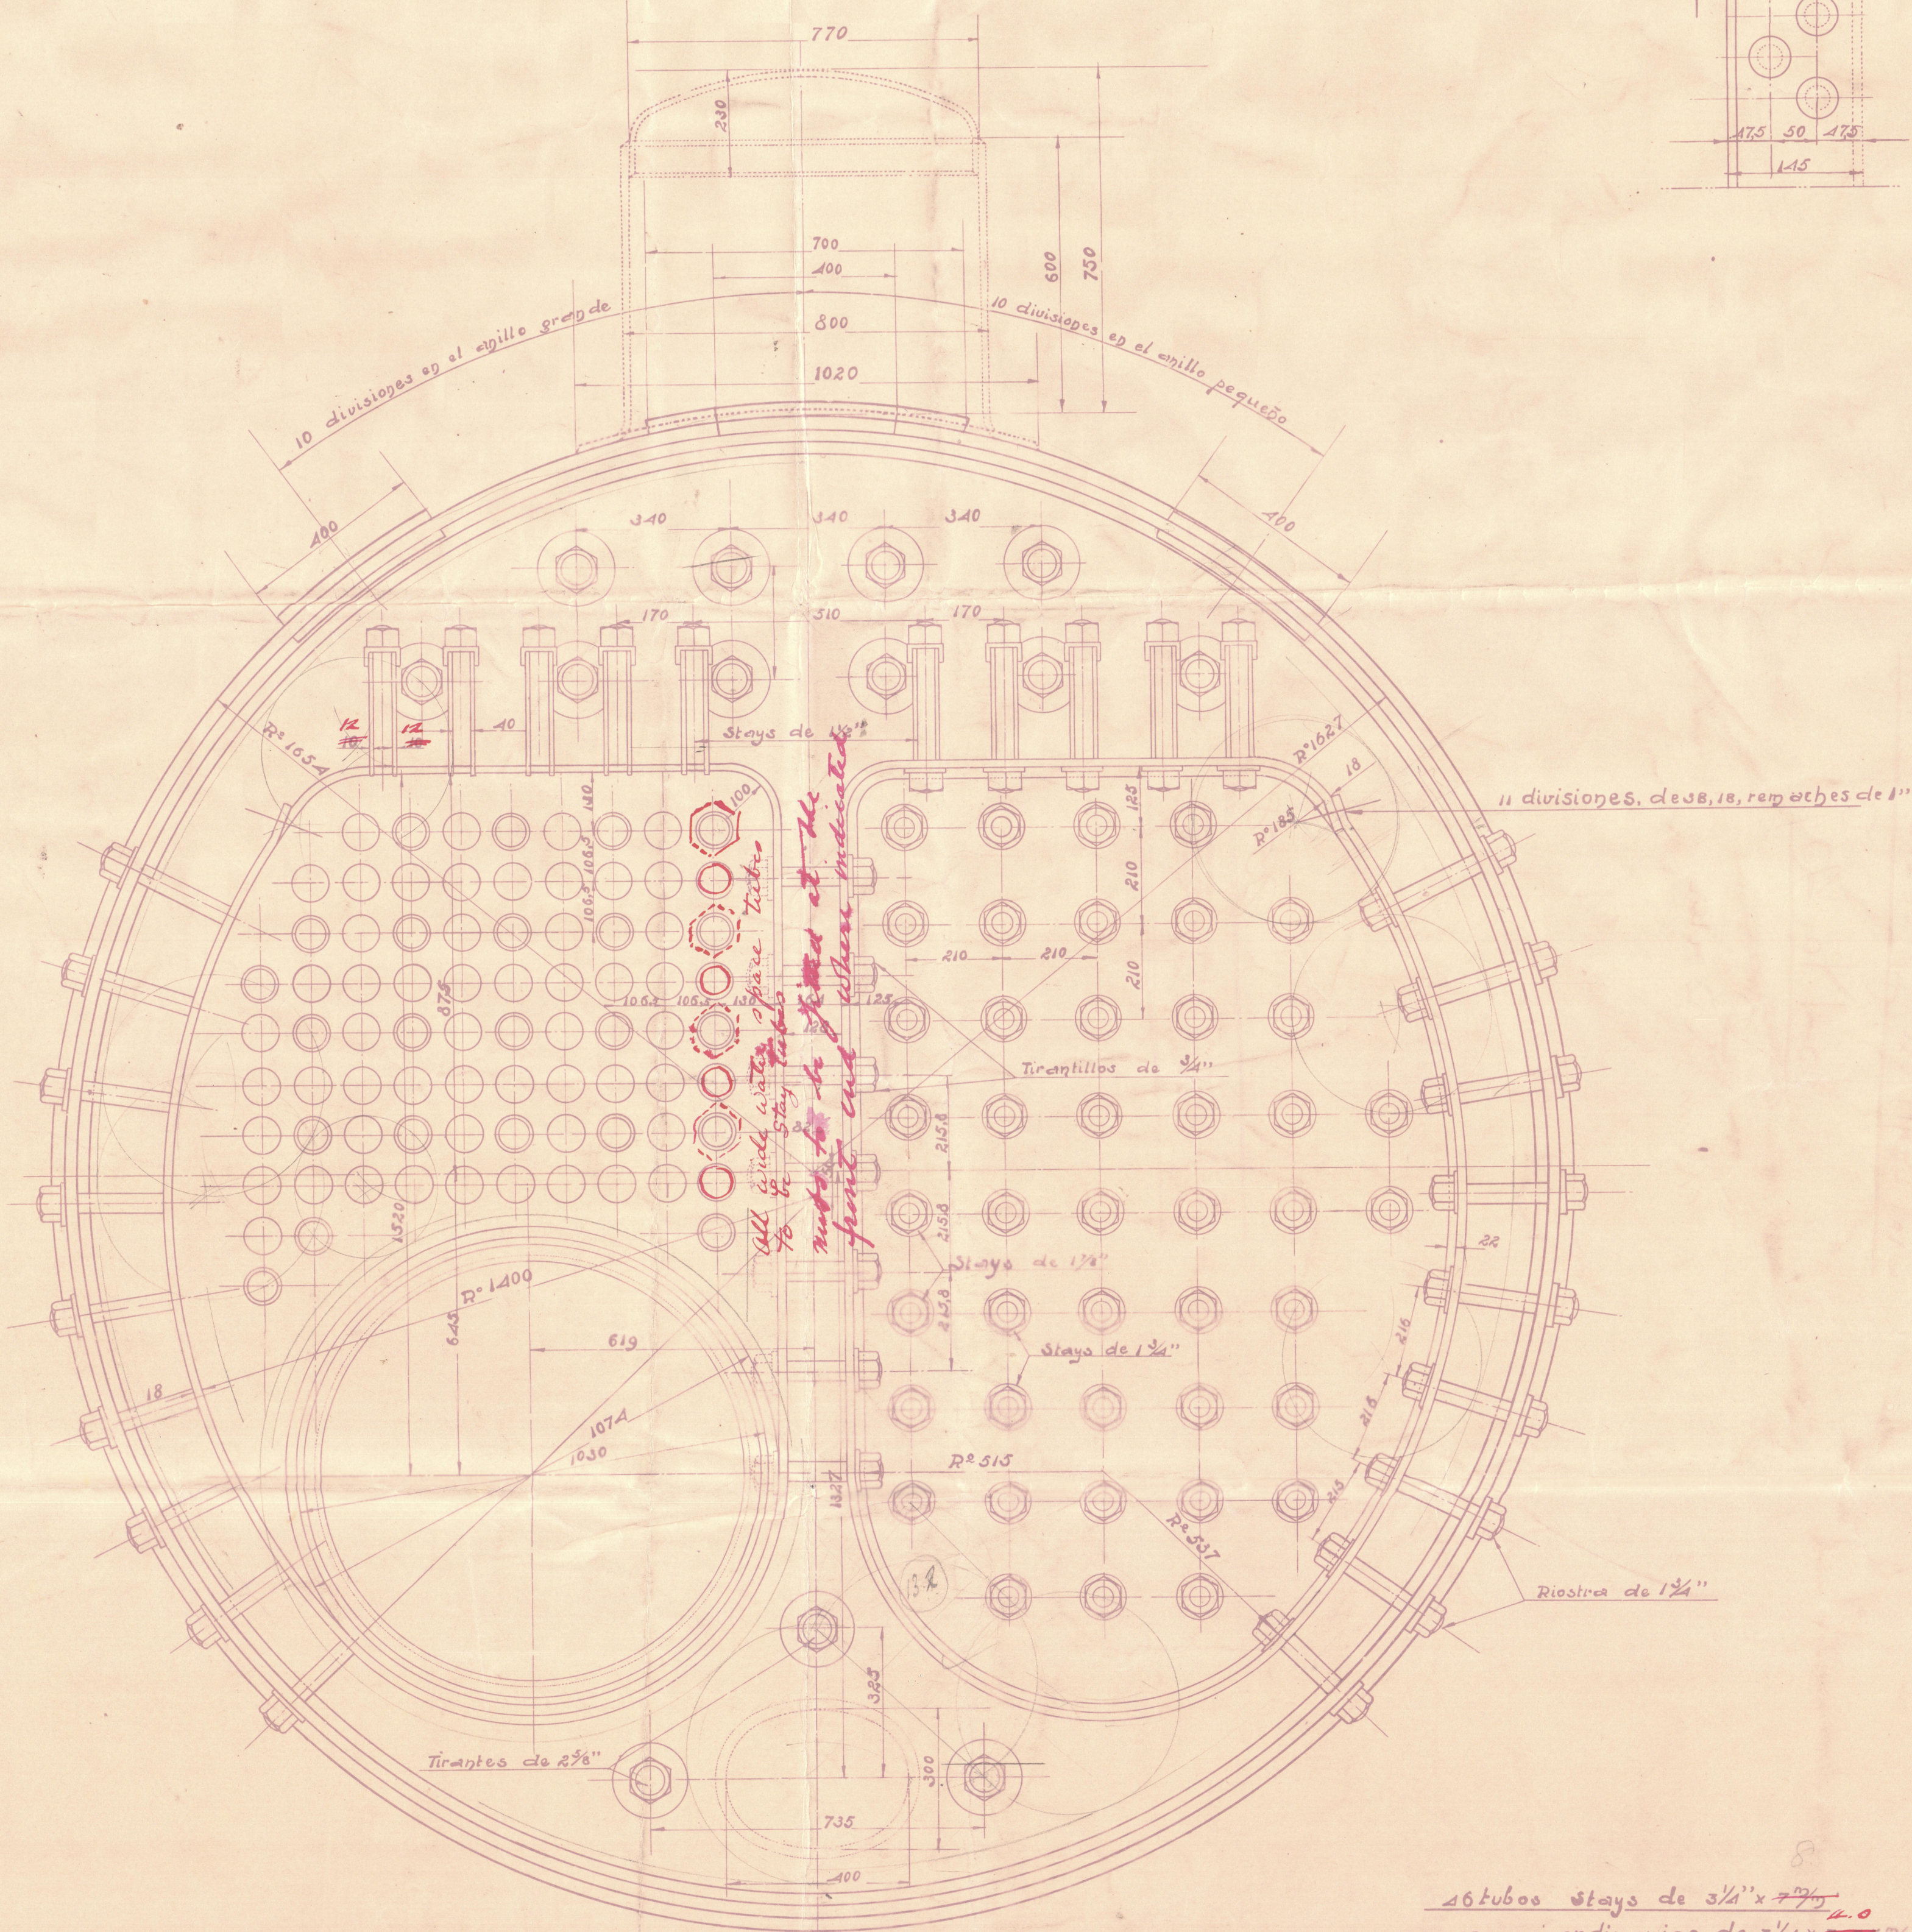


Thickness marginal stay tubes to be not less than 6 1/4" measured under the threads.

Back Plate  
PLACA DEL FONDO

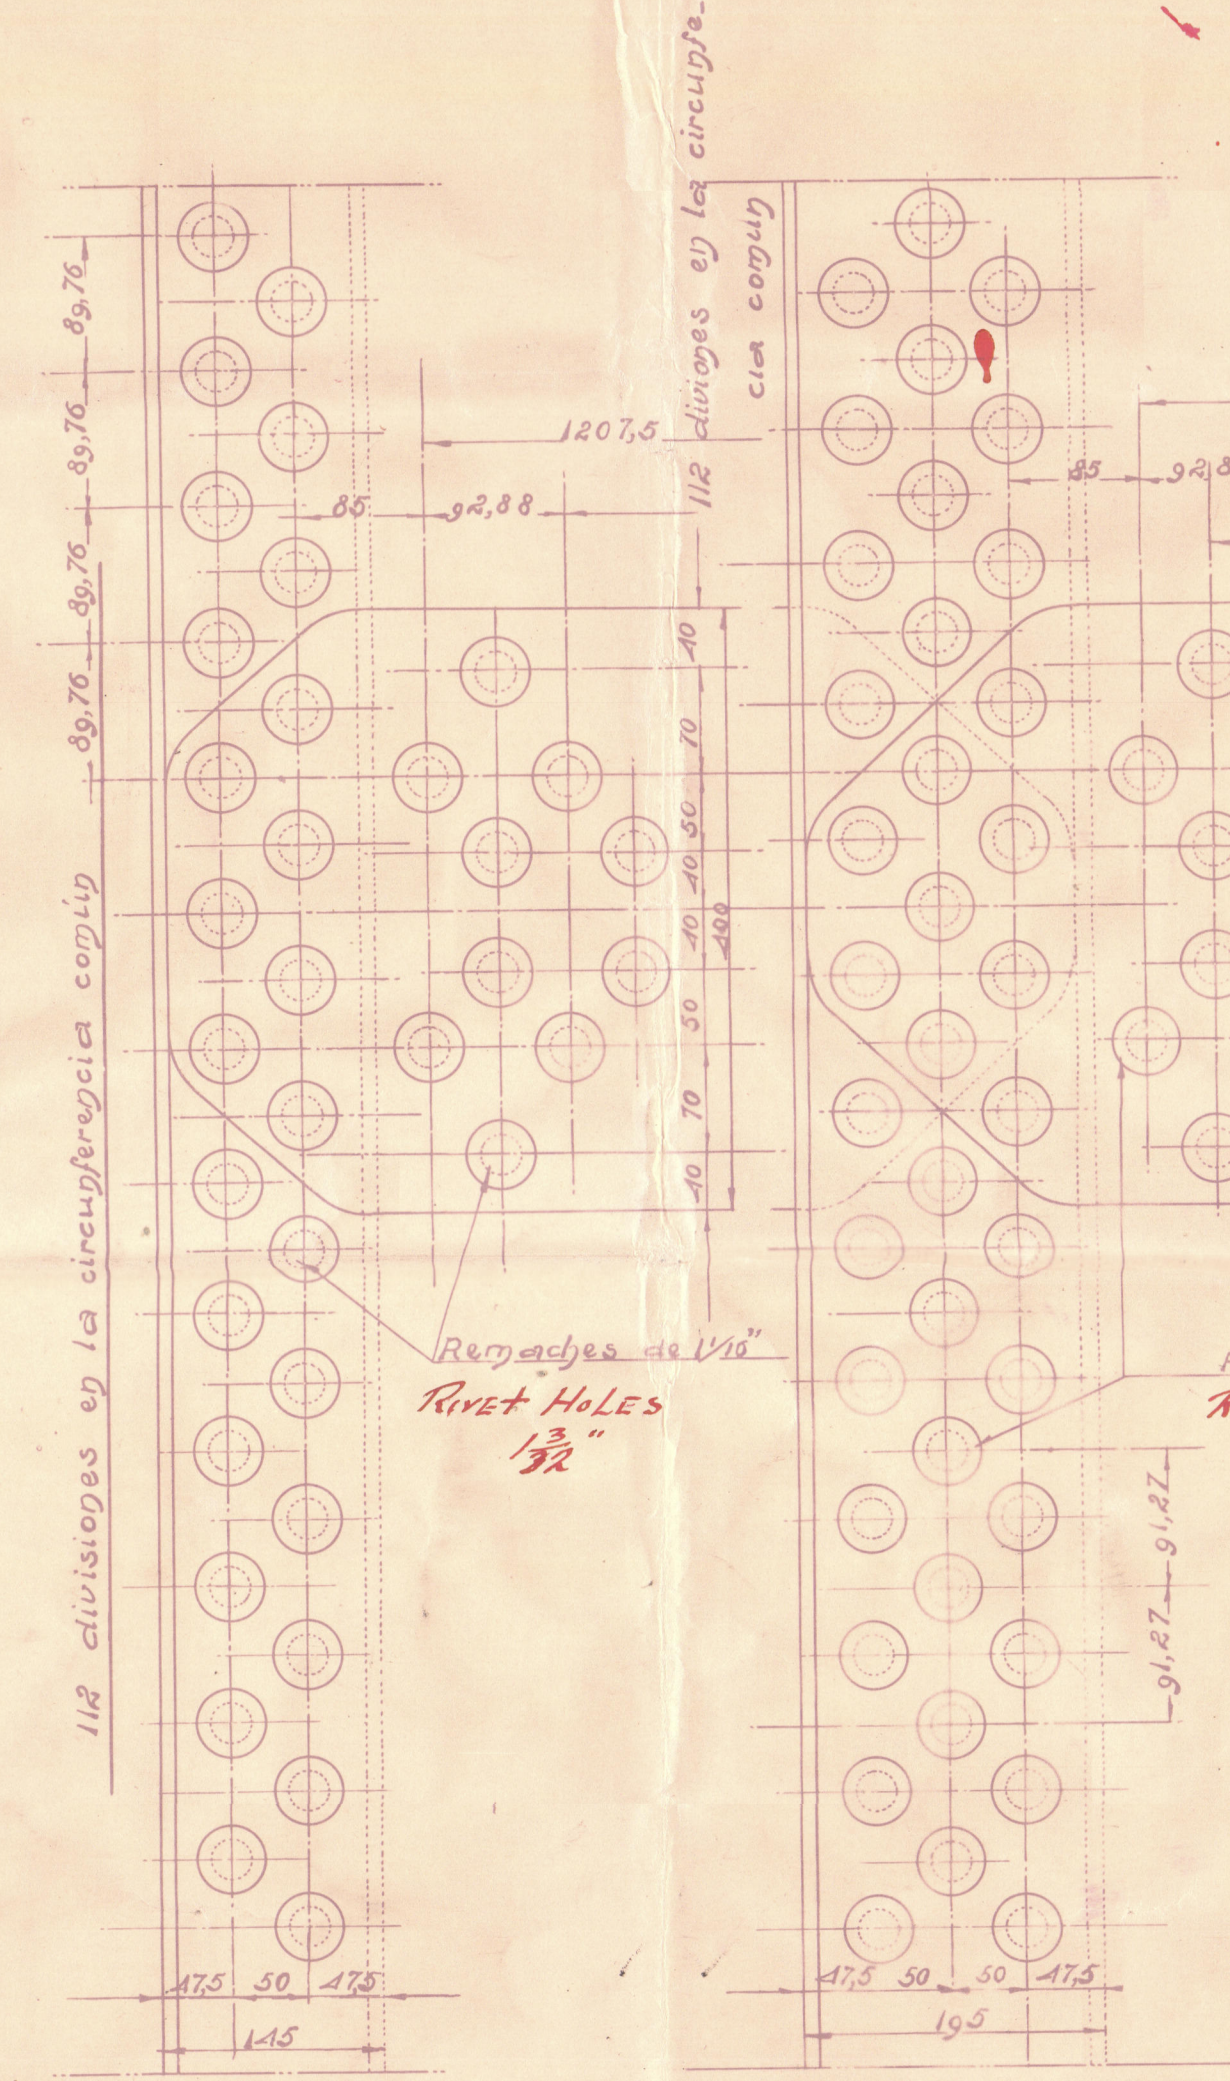


SHELL PLATES  
UNION DE LAS ENVOLVENTES A LAS PLACAS Y ENTRE SI  
BETWEEN THEM.

ESCALA de 1:85

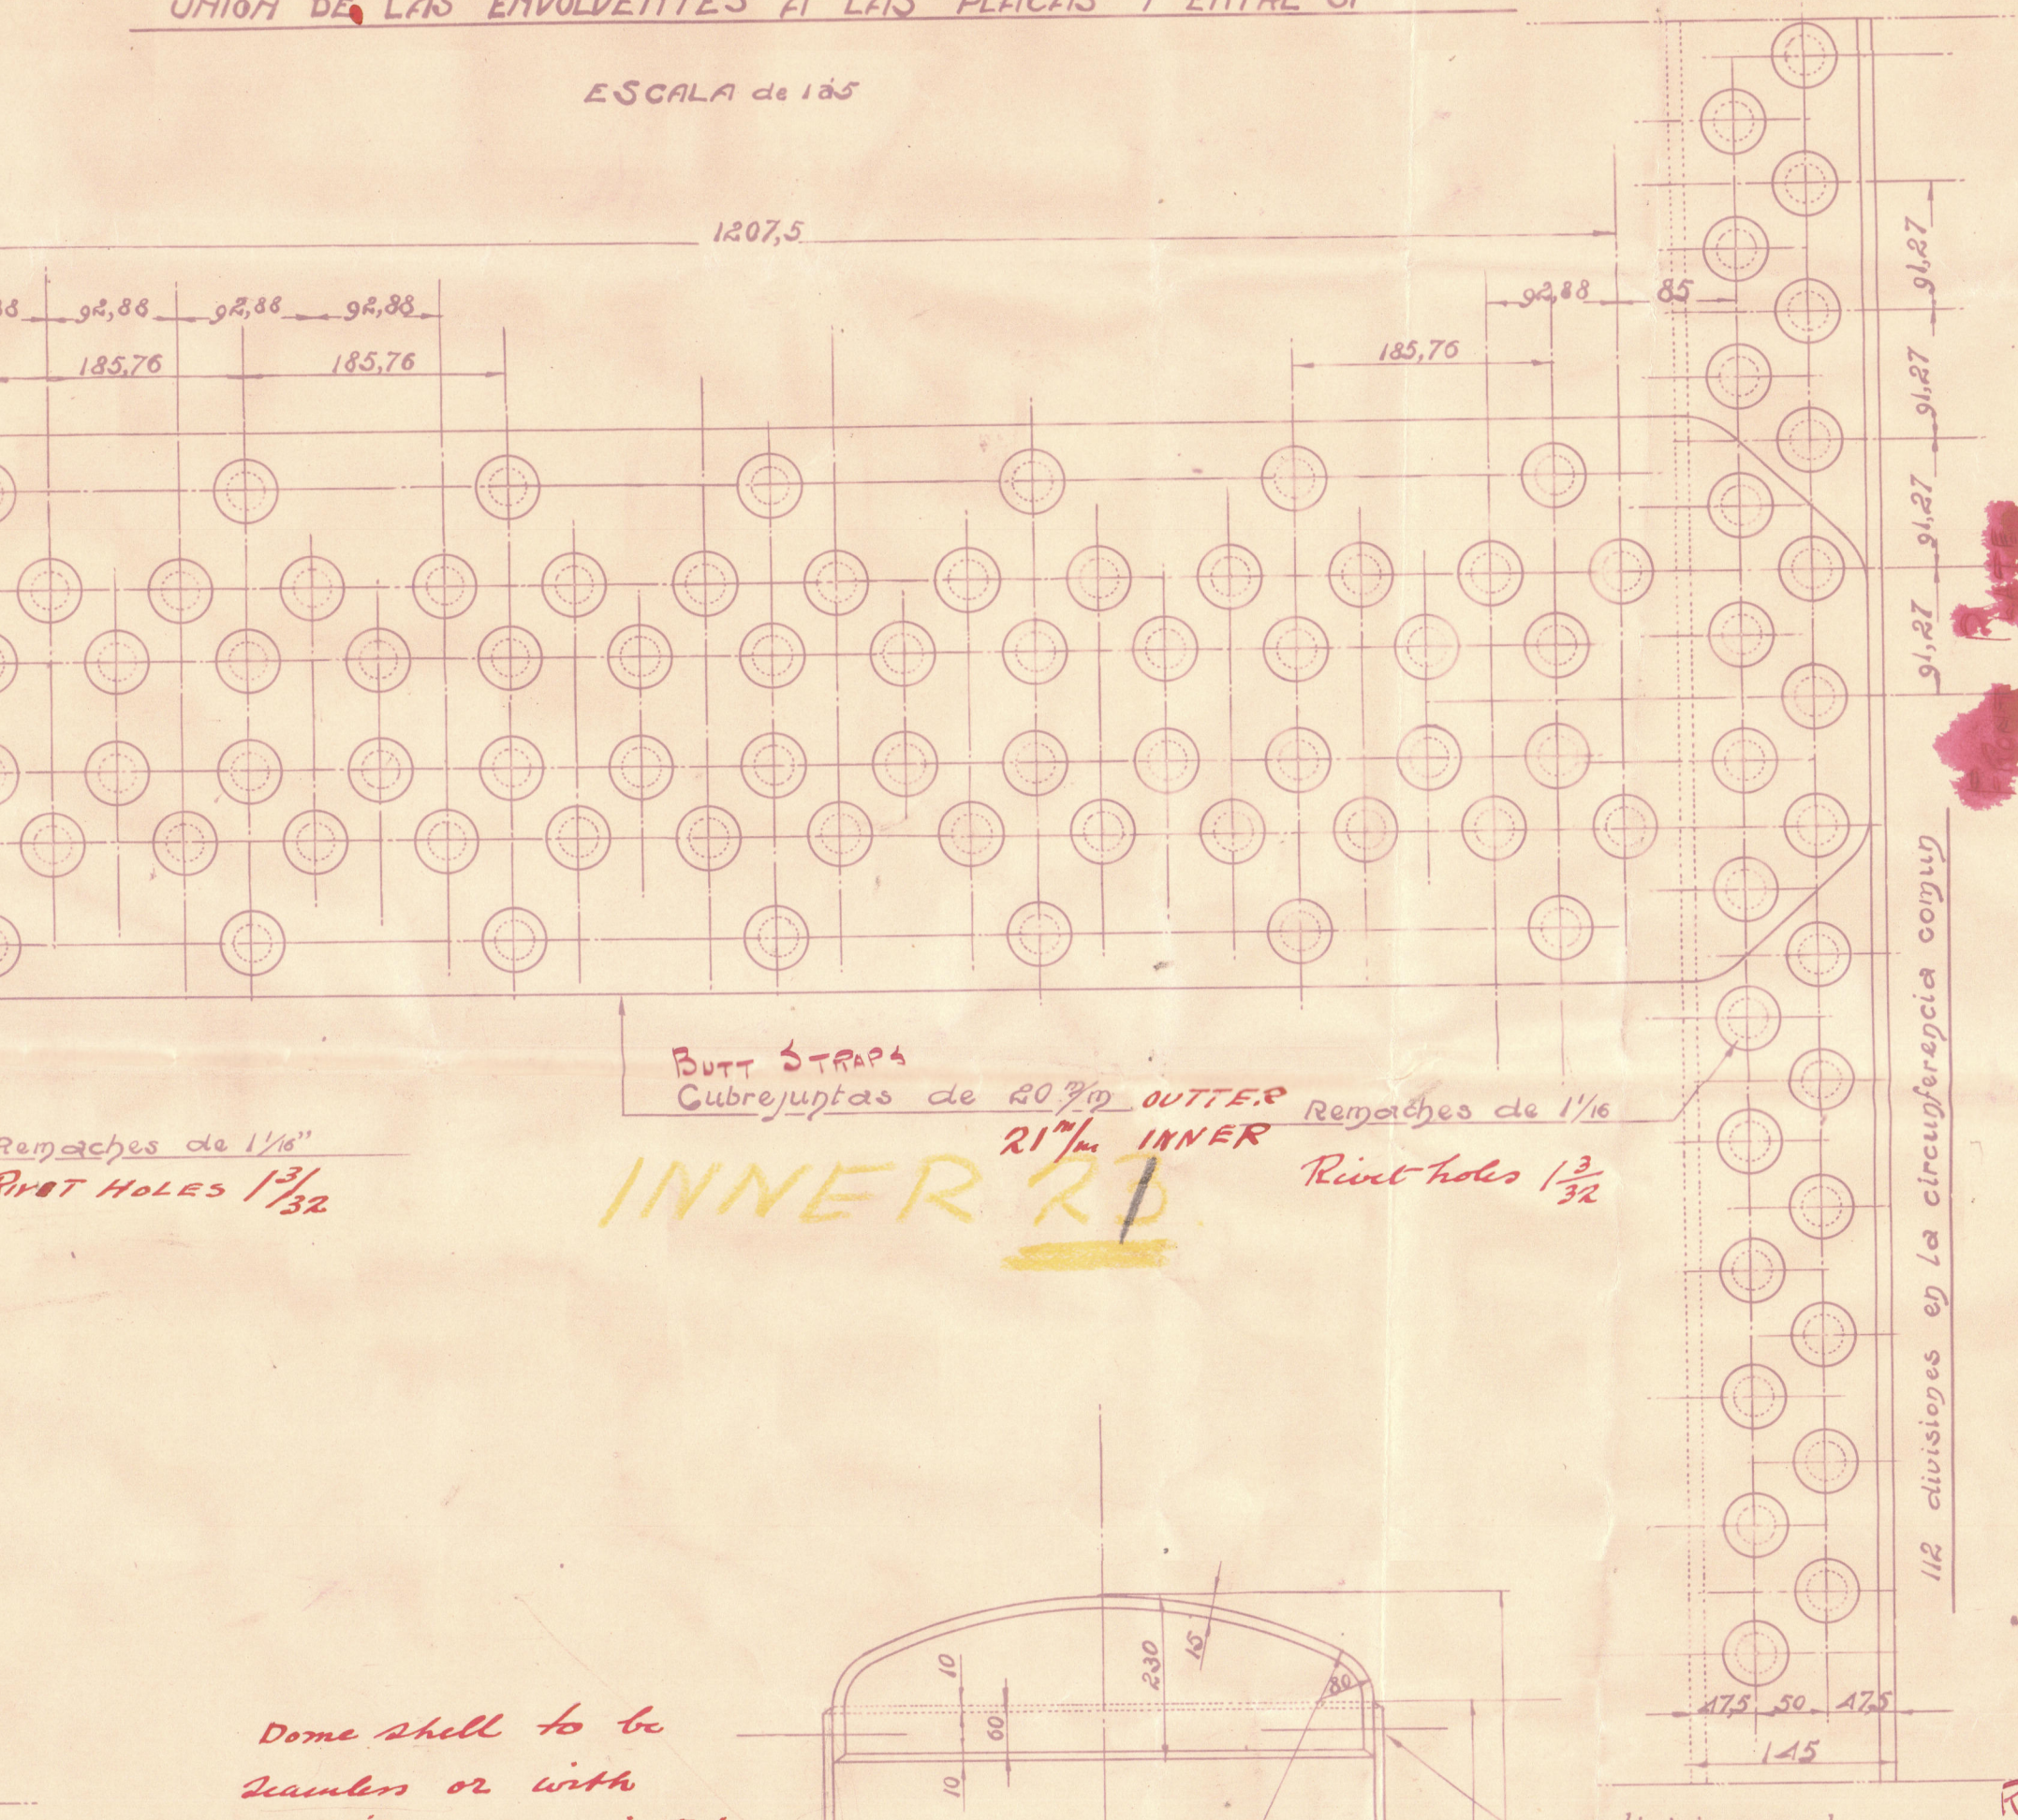

Butt STRAPS  
Cubrepuntas de 20 3/4" W.T.T.P.  
21 1/2" INNER  
Rivet holes 1 3/32"

41.2%

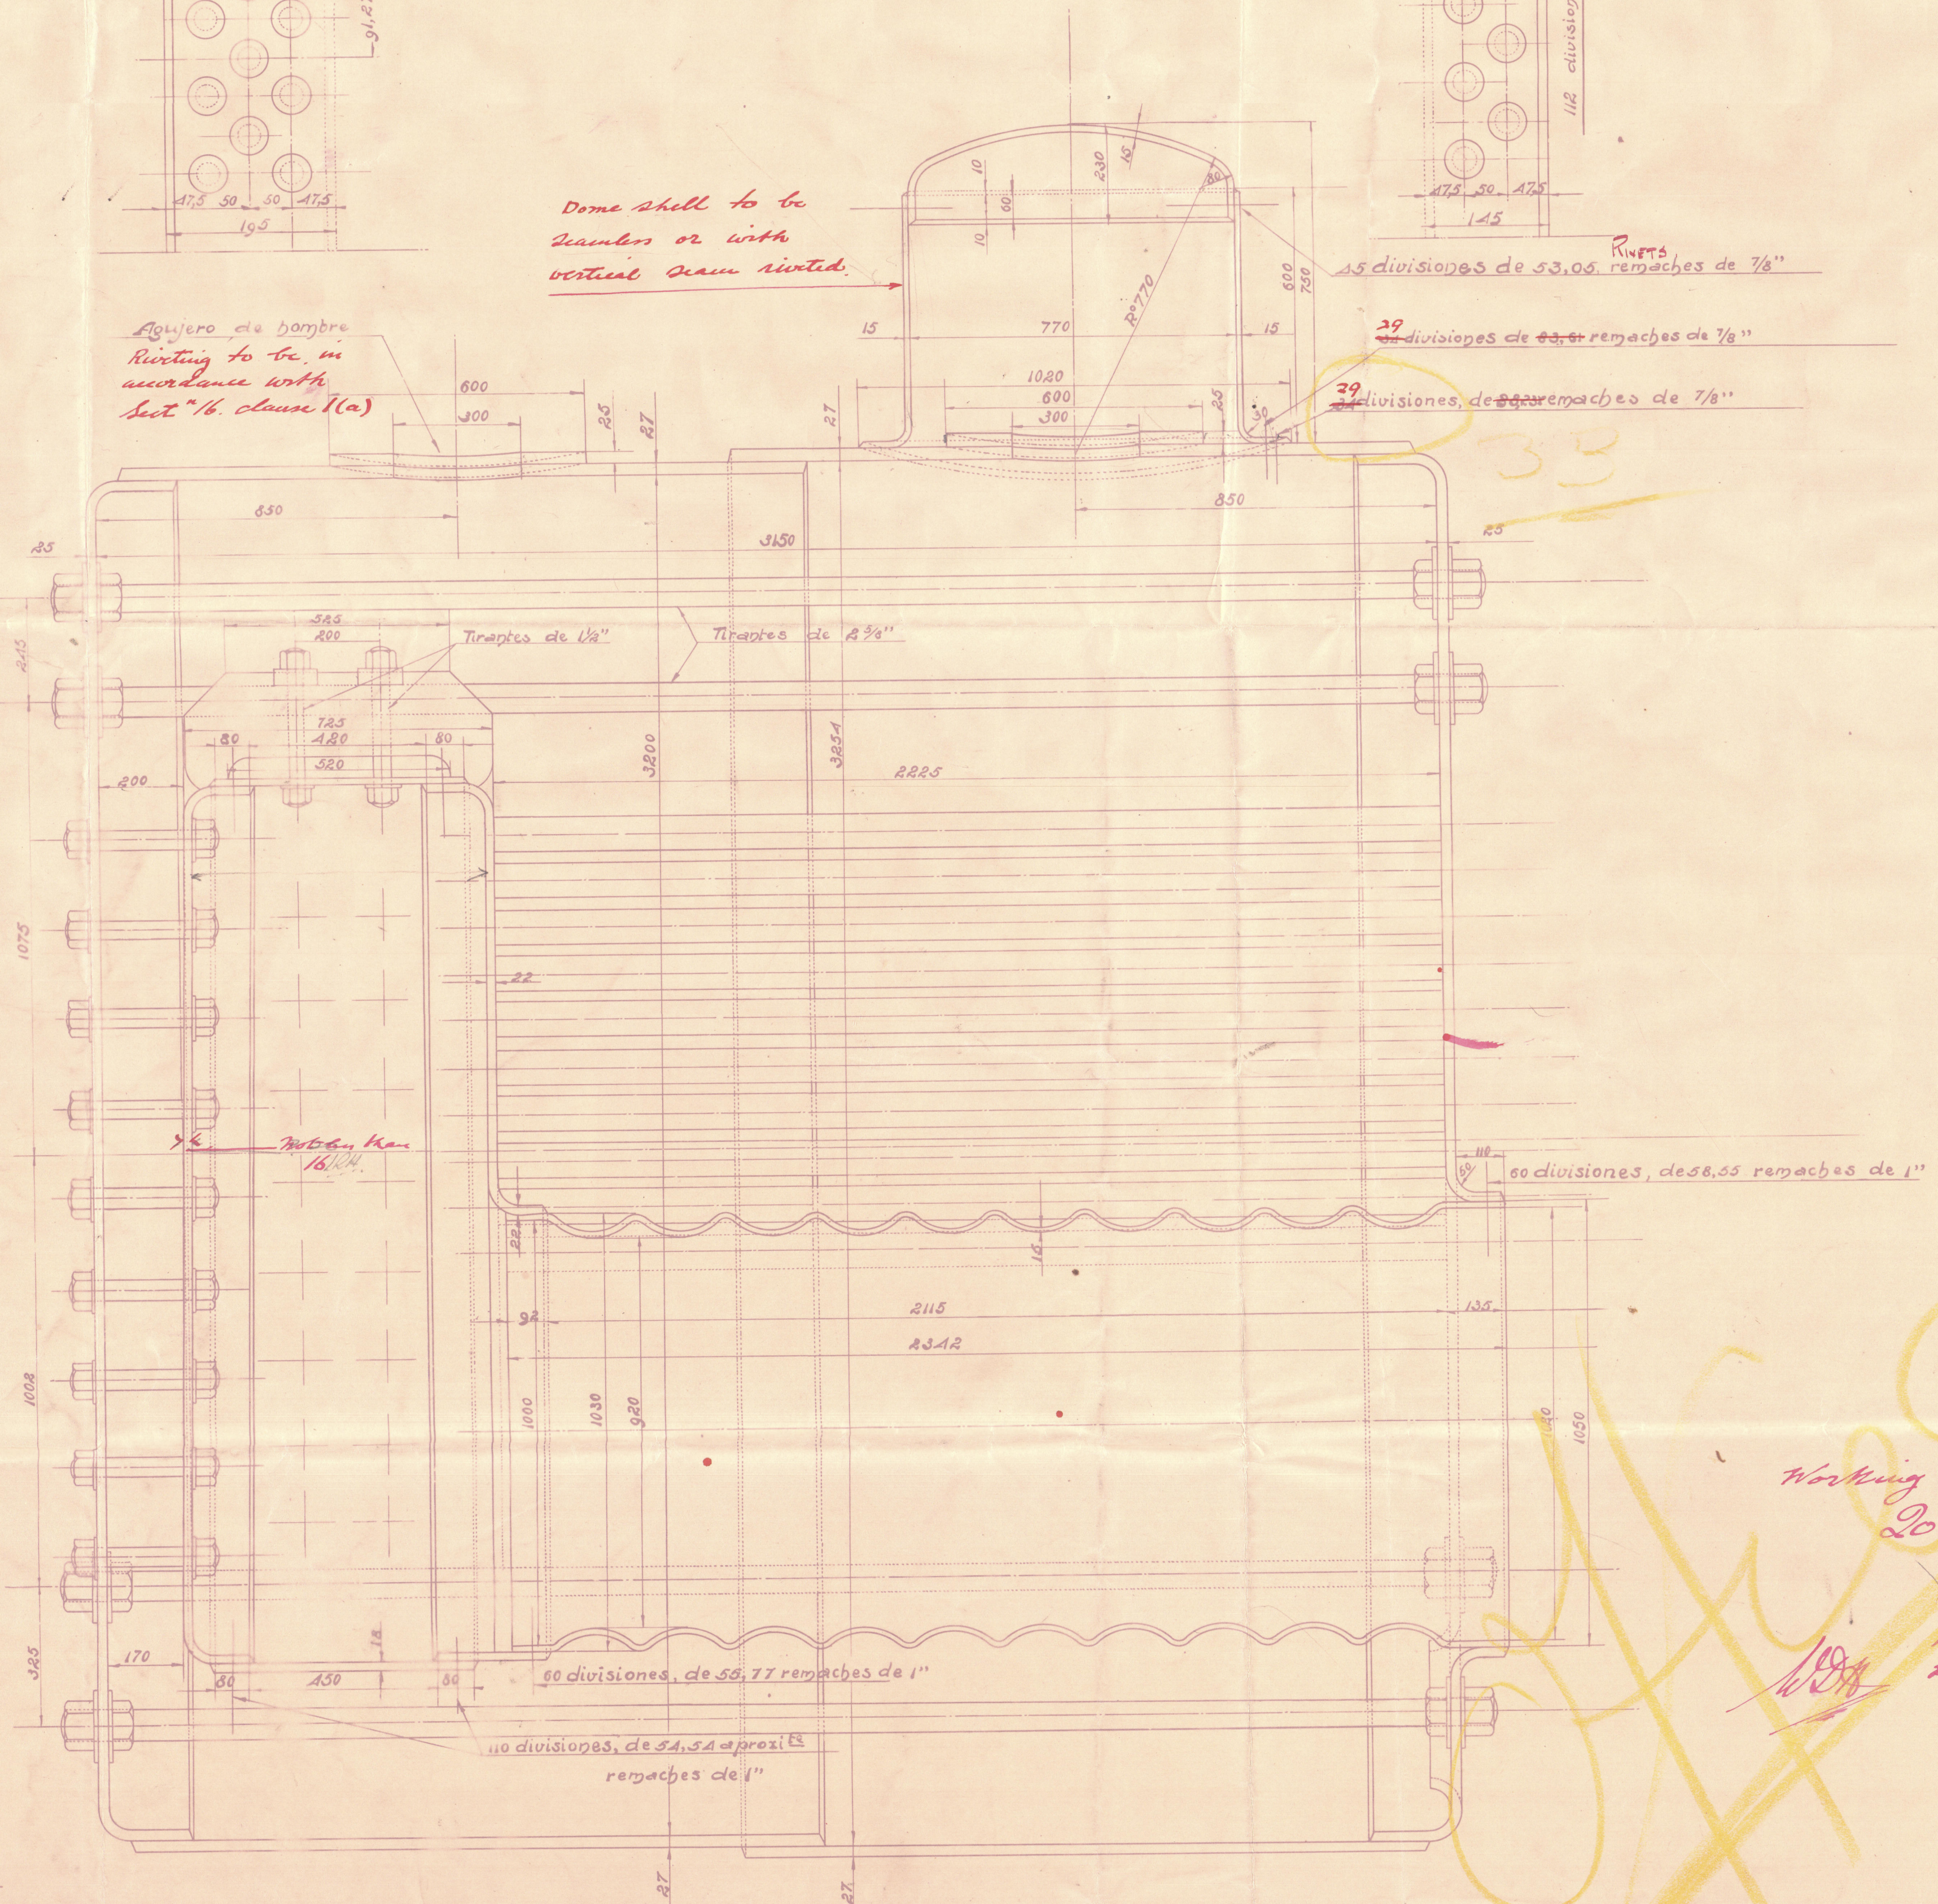

Working Pressure  
200 lb./sq. in.

1884  
27.1.28.



Sr. Dpto de J. Barreras. Vigo.

S.S. No. 454

main Boiler

CADIZ

CADIZ

958

GEN. BOX NO

~~444~~

RETAIN



© 2020

Lloyd's Register  
Foundation

W1251-0064

W1251-0064