

N.º 2,066-3

ASTILLEROS BARRERAS

VAPOR PARA EL GOBIERNO PORTUGUES

MINISTERIO DAS FINANÇAS

Sección longitudinal.

Escala 1 a 20


Wrote, undid - steering gear
Supported to Surgeon's satisfaction

Dimensione.

Eslera entre pp.....28 m^{ts}
Manga.....6 m^{ts}
Puntal.....3,10 m^t

Plated

Changes 4x3x32 fraction & 27 int plates

Paul Leeson

$\perp 75 \times 75 \times 6,5 - 9,0$ D.v

Chapa 10,5 en D.C.


Chapter 10-9

Mamparo estero

W.J.
29.9.27
© 2020
Lloyd's Register
Foundation
1251-0065

Profile

GEN. BOX NO 958

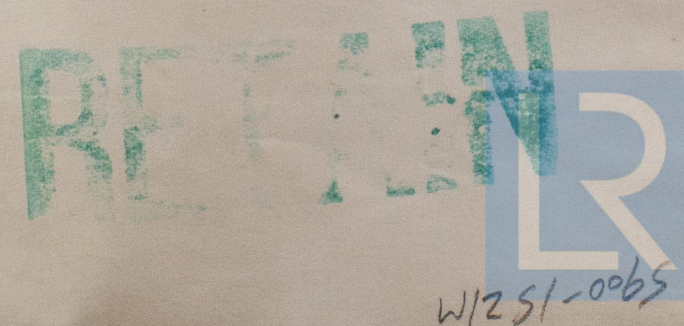

© 2020

Lloyd's Register
Foundation