


STRINGER PLAN

SCALE 1/2" = 1 FOOT

S/185 ORDINARY ANGLE
BULB ANGLE 5" x 2 1/2" x 5/16"

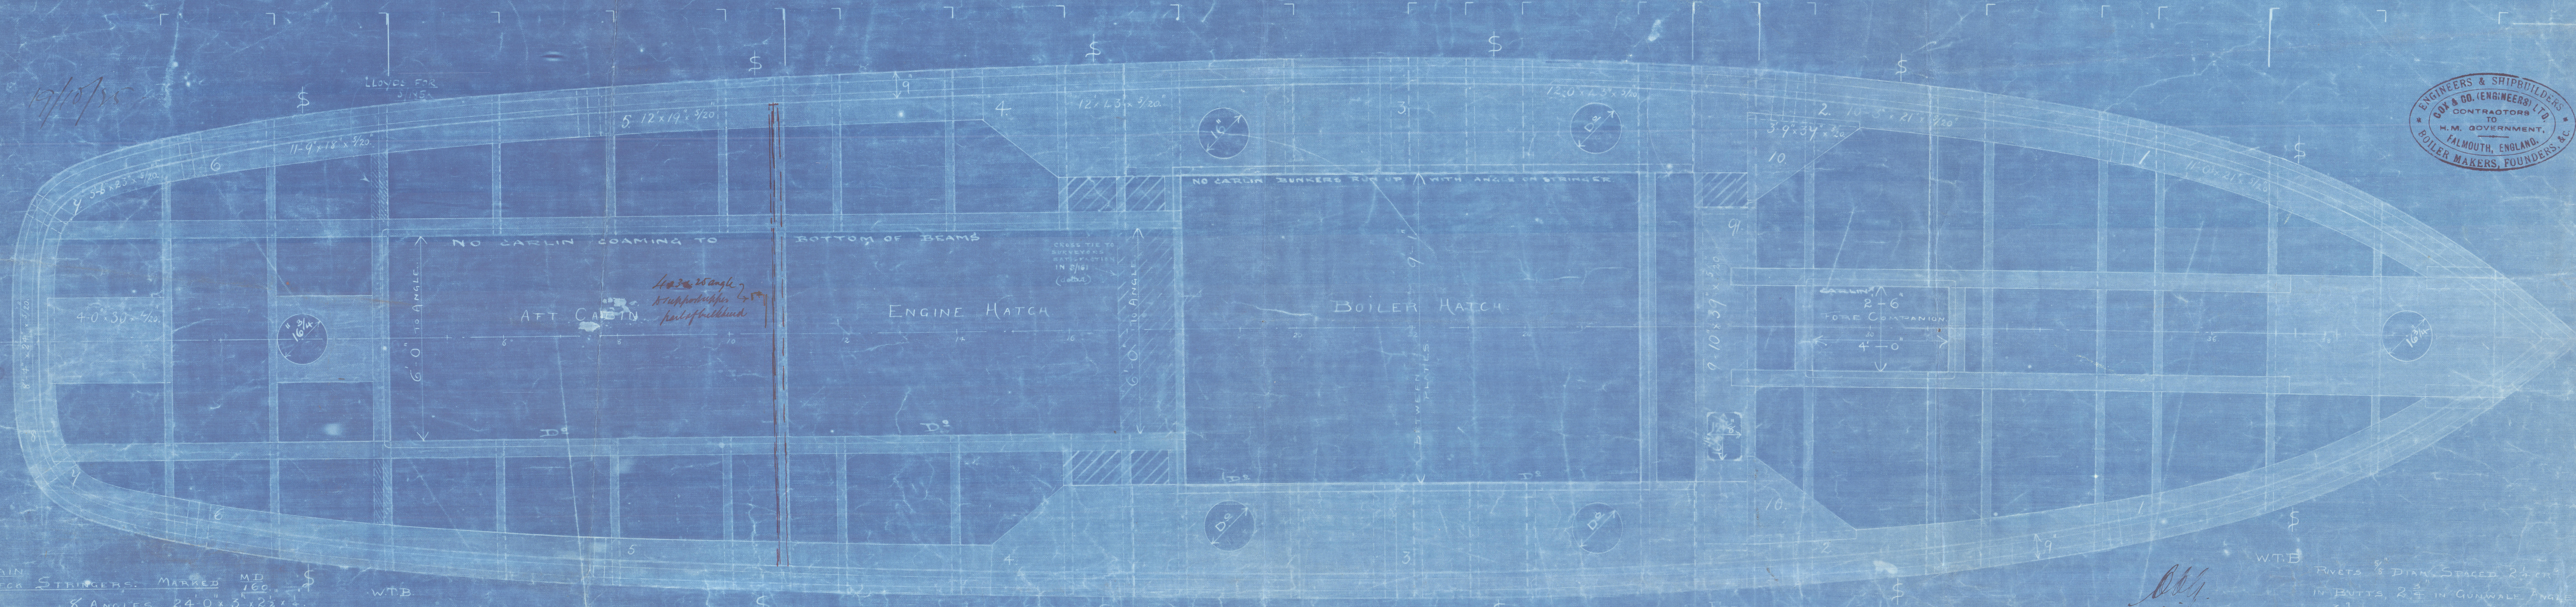


MAIN STRINGERS: MARKED MD 160
8 ANGLES 24-0 x 3 x 2 3/4
WATERWAY ANGLES: MARKED WA 160
8 ANGLES 24-0 x 2 x 2 1/4
COAMINGS MARKED CA 160
5 ANGLES 24-0 x 2 1/2 x 2 1/4

DECK TIE PLATES: MARKED MD 160
6 PLATES 14-0 x 6 x 1/4

BEAMS 4" x 3" x 5/20
MAIN BEAM BULB ANGLE S/185
5" x 2 1/2" x 5/16

RIVETS 5/8" DIAM. SPACED 2 1/2" IN BUTTS, 2 3/4" IN GUNWALE ANGLE 3 1/4" IN BEAMS.
BUTTS STRAPS DOUBLE RIVETED 5/8" 2020

SHIP NO 190.

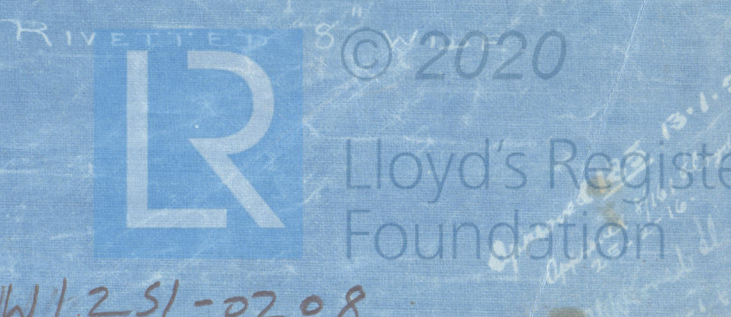


Cox + Co's 190

1/5 Theydon

Deck plan

Strongens

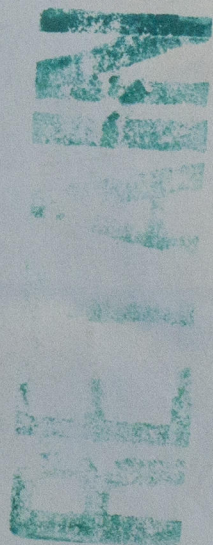

© 2020

Lloyd's Register
Foundation

W1251-0208