

6.8.15









Nº 386

CONSTRUCTION PROFILE & DECKS.

SCALE 1/8" = 1 FT.

NUMERAL FOR W.S.P. PILARS					
FR POS	(13)	(25)	(65)	(86)	
S	17.63	22.52	13.71	29.38	26.44
B	12	12.5	13.75	13.75	13.75
H	5	5	7.5	5	5
M ₂	10.6	14.6	25.7	18.2	
LENGTH	UNDER 17'	UNDER 19'	UNDER 18'	UNDER 19'	

NUMERAL FOR GIRDER AT TOP OF W.S.P.					
FR POS	(7-13)	(13-25)	(25-36)	(56-65)	(65-86)
S ²	11.75	23.5	21.55	17.6	41.13
B	11.5	12.25	12.65	13.75	13.75
H	5	5	5	(12.5x13.71)+(5x3.92)	5
M ₂	7.4	3.41	3.71	4.55	11.6

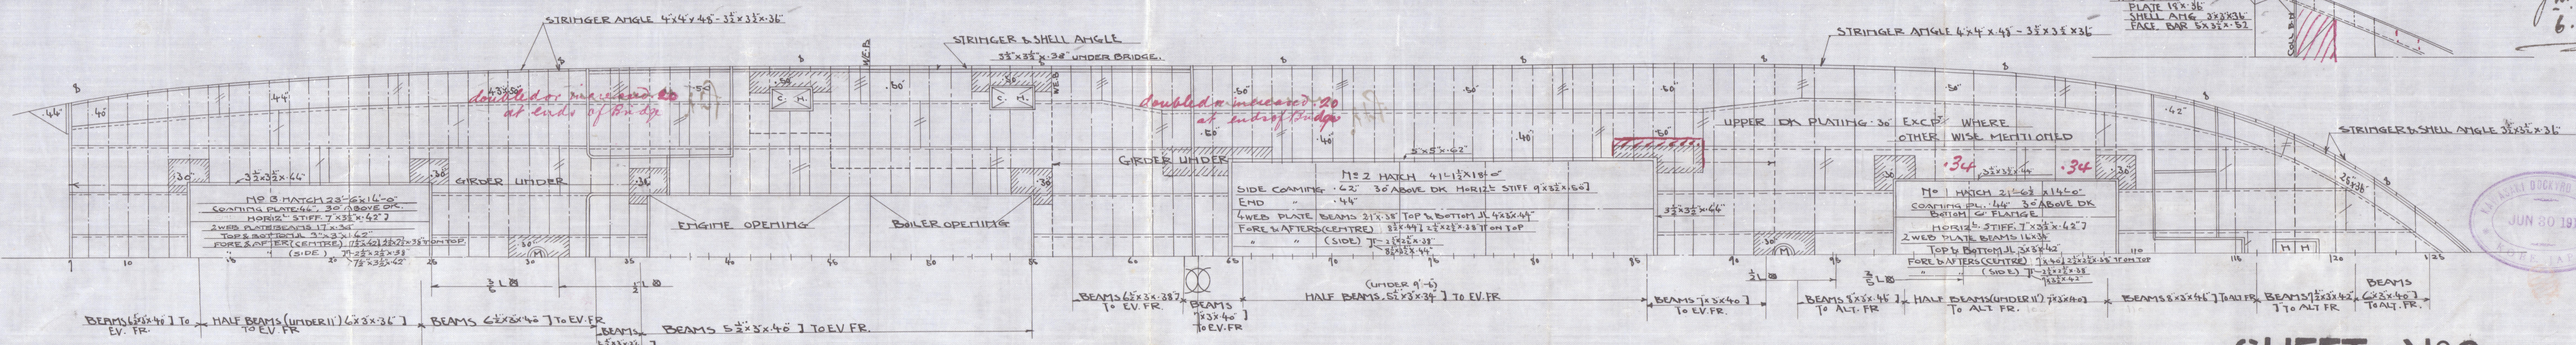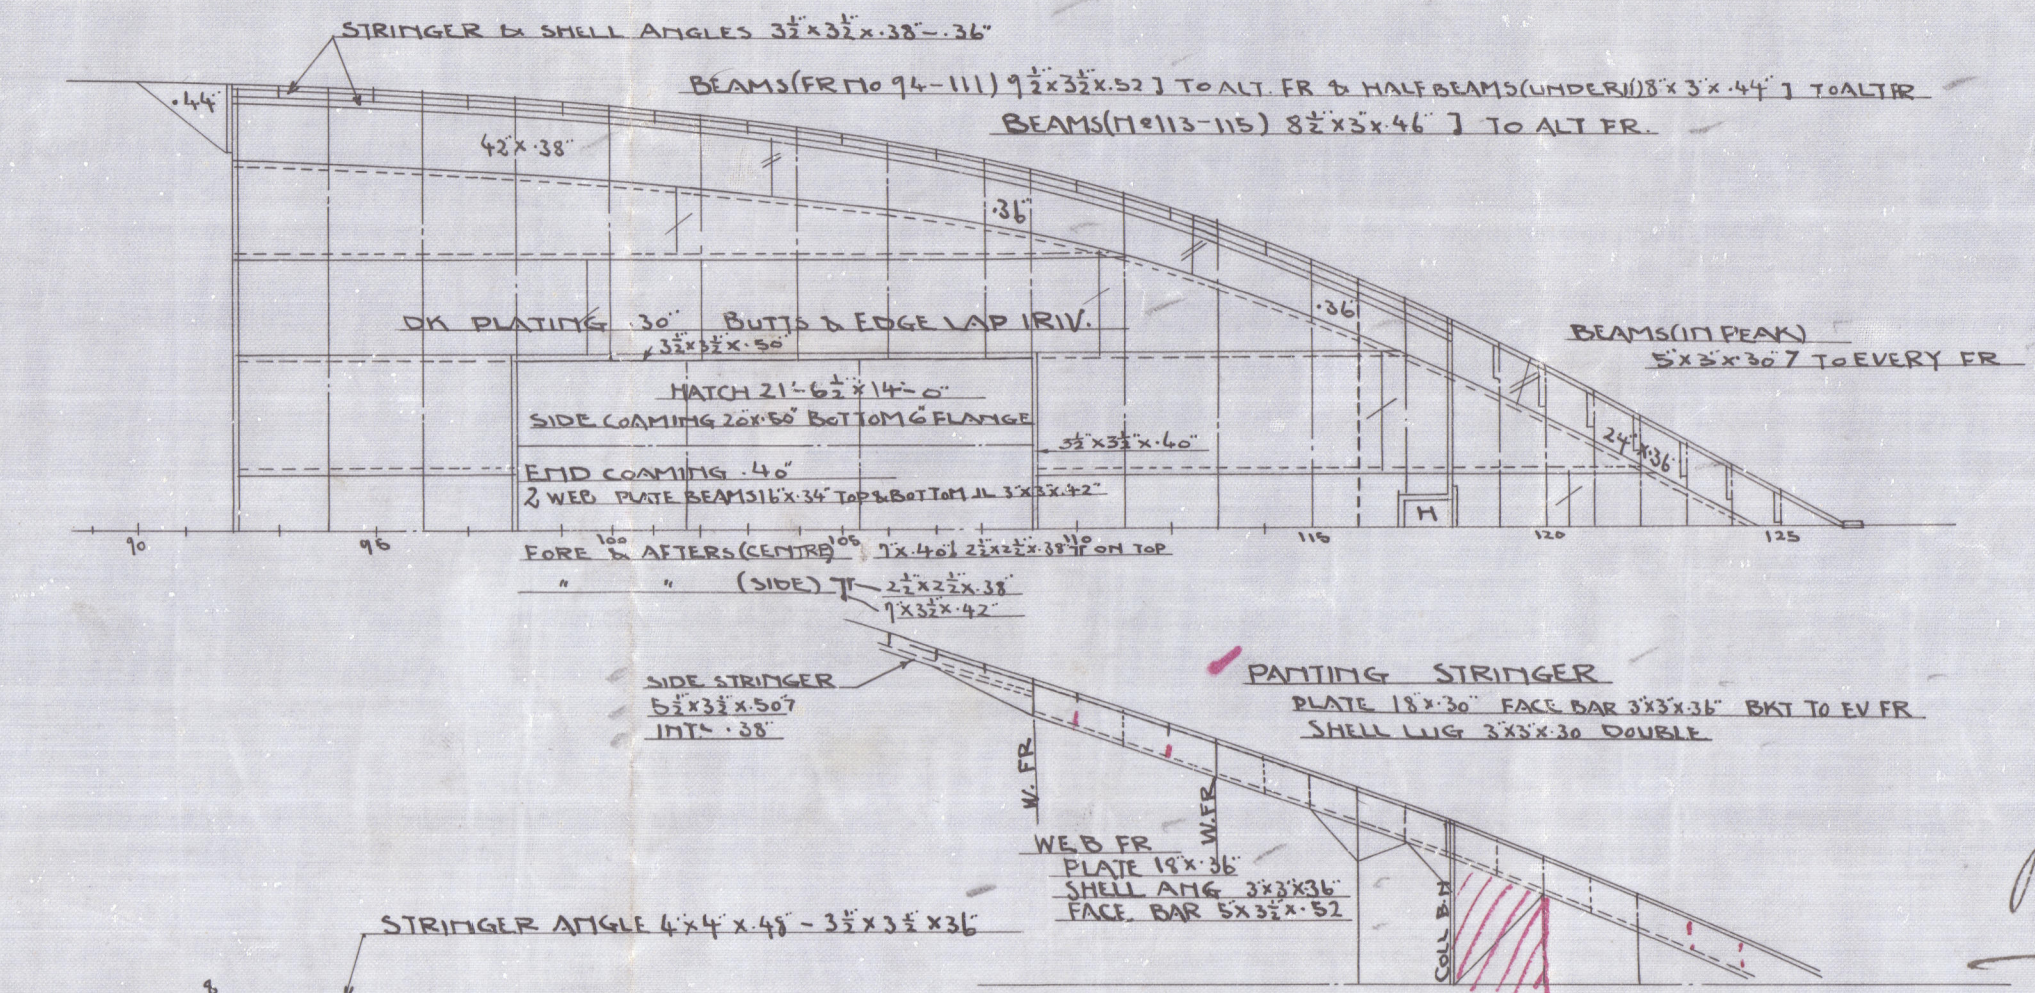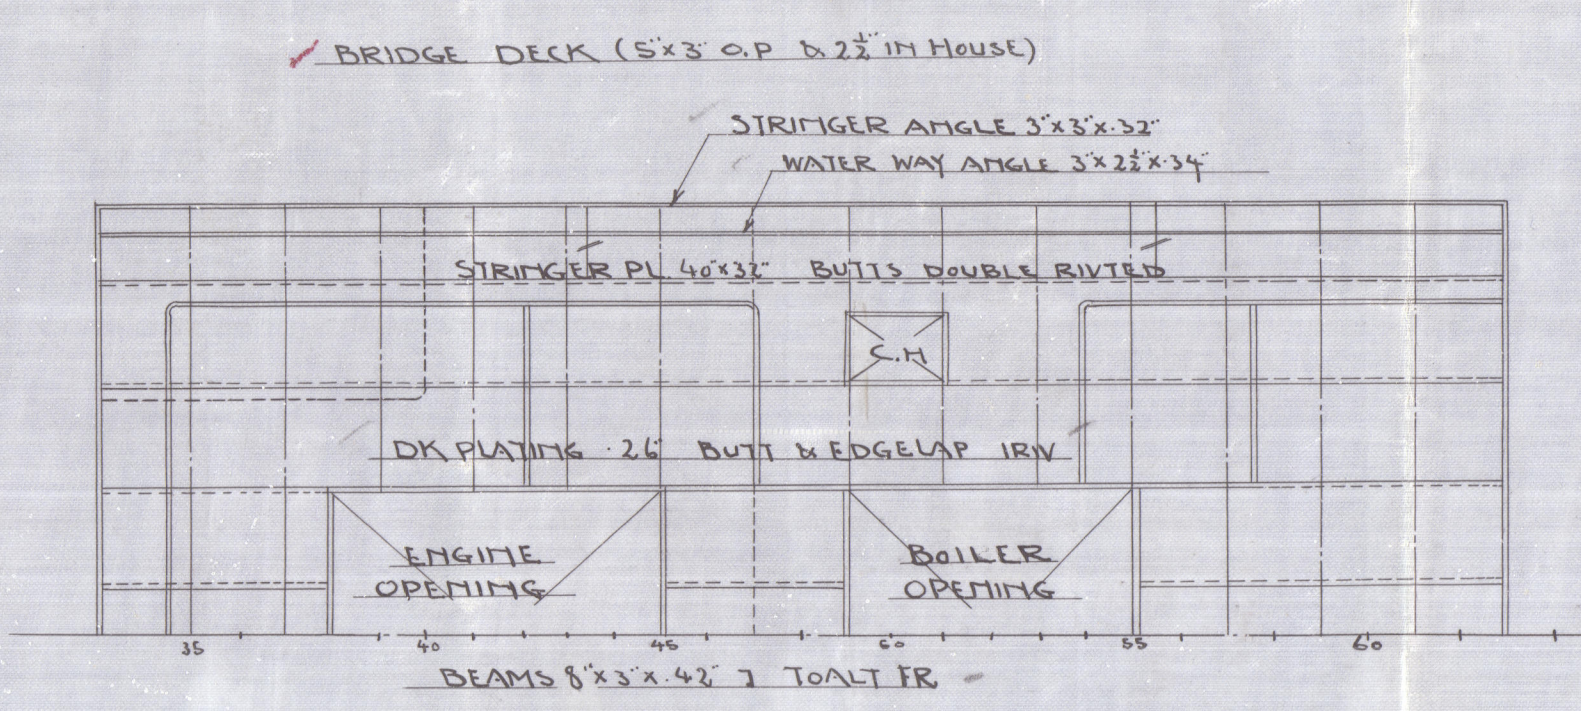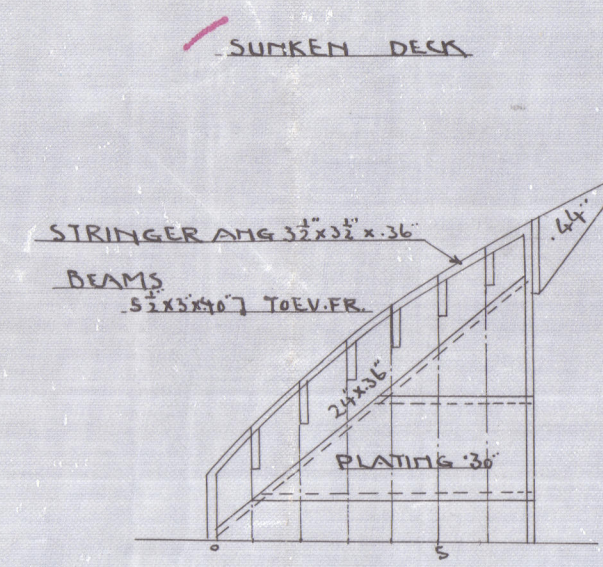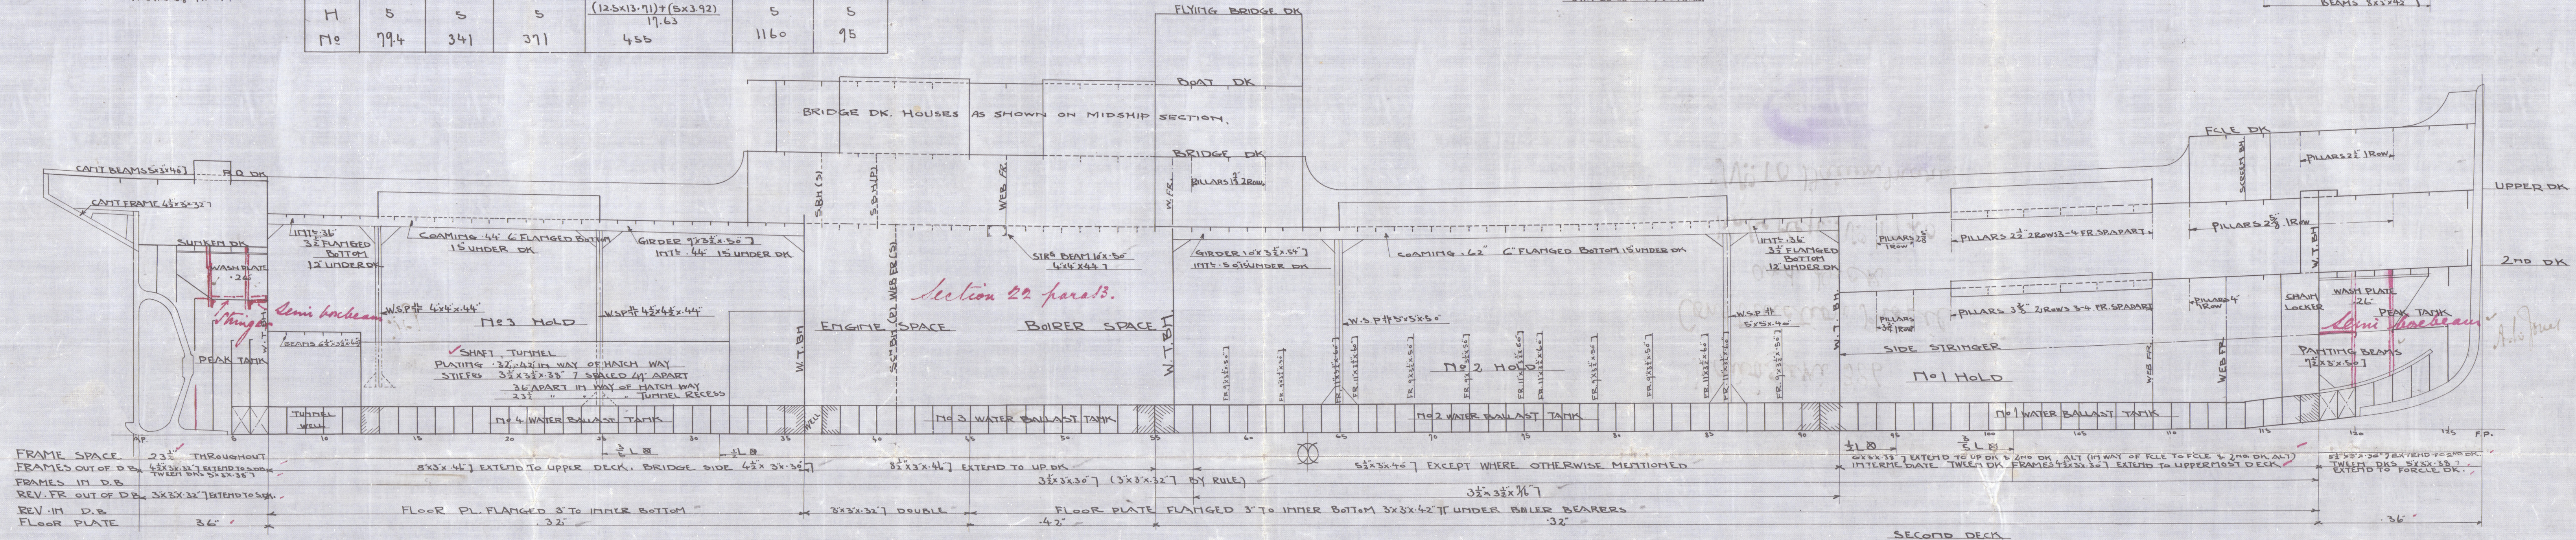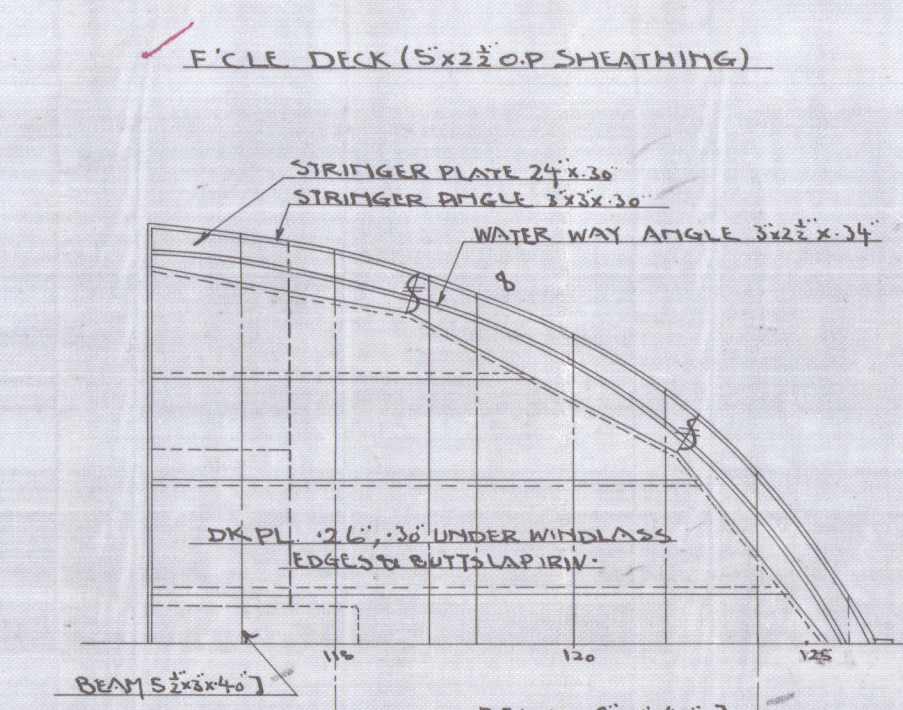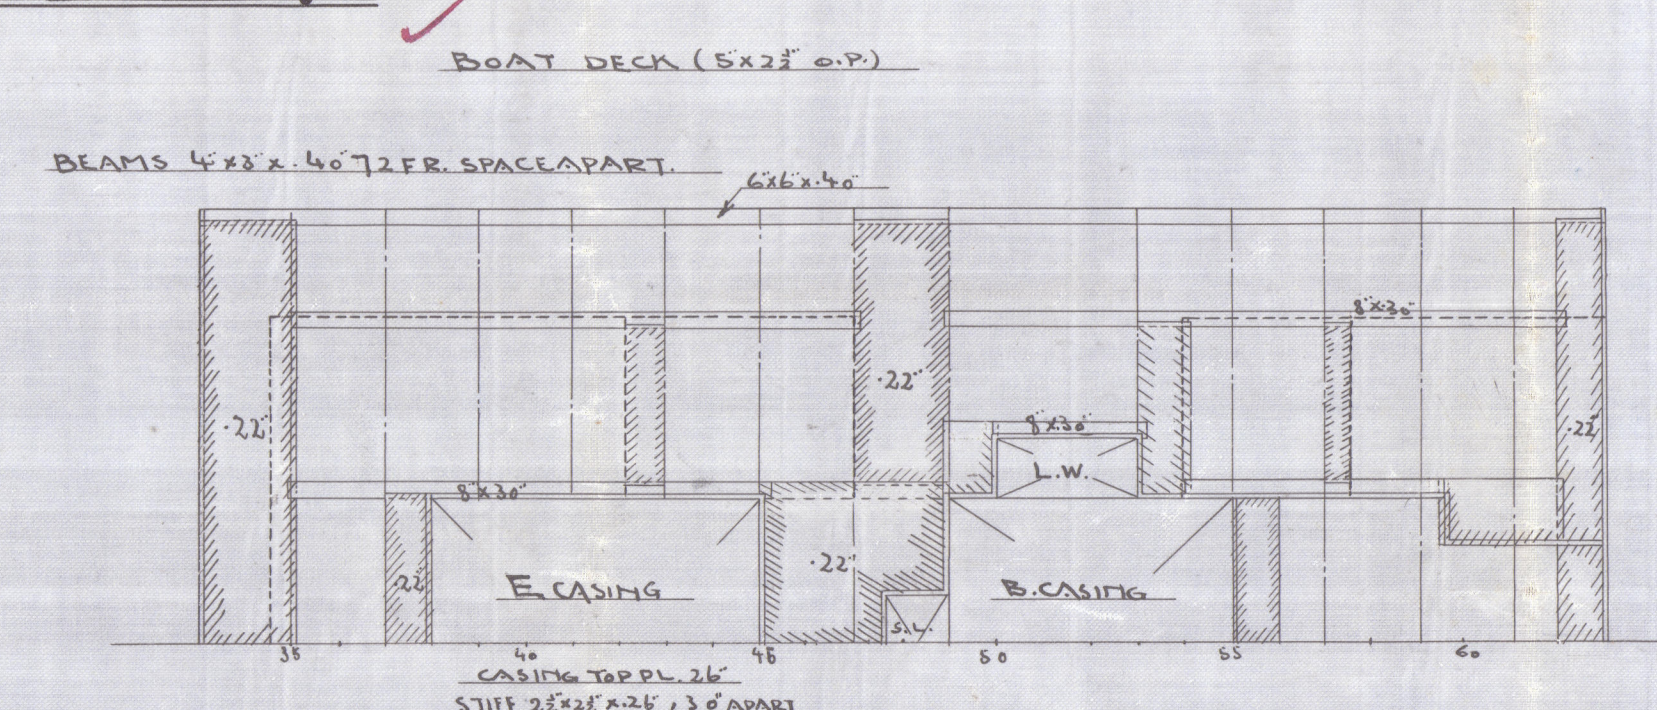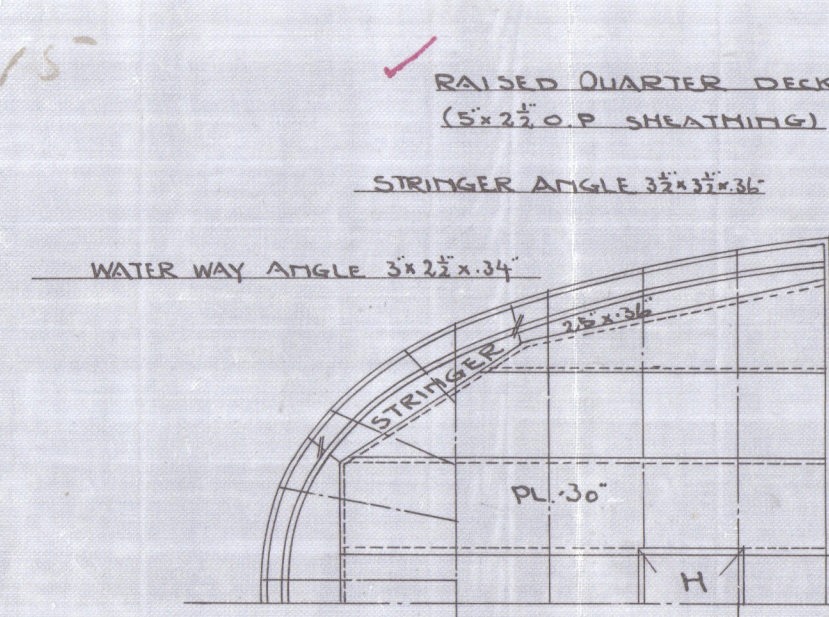

SHEET Nº3

JUN 30 1916


W1252-0239

Kawasaki 386

Construction Profile
and Deck

Kobe Rep. No. 1720

No. 10 Daiun Maru?

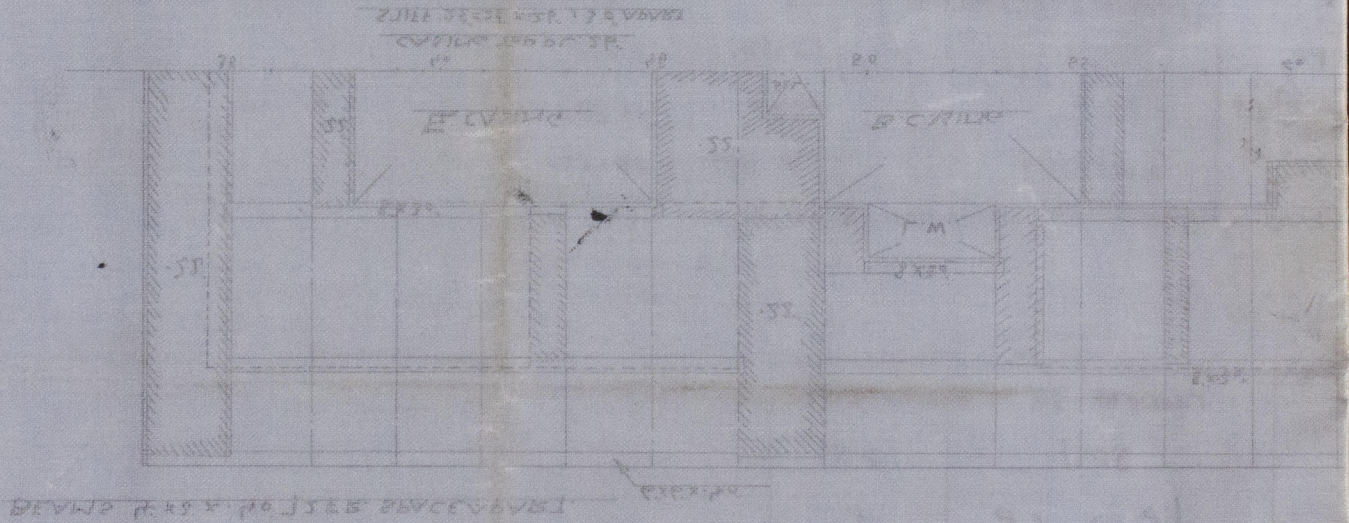

DECKS



© 2020

Lloyd's Register
Foundation