


THE RIO DE JANEIRO CITY IMPROVEMENTS CO. LTD.

LAUNCH MARIA.

SHELL EXPANSION.

SCALE $\frac{3}{8}" = 1'$.

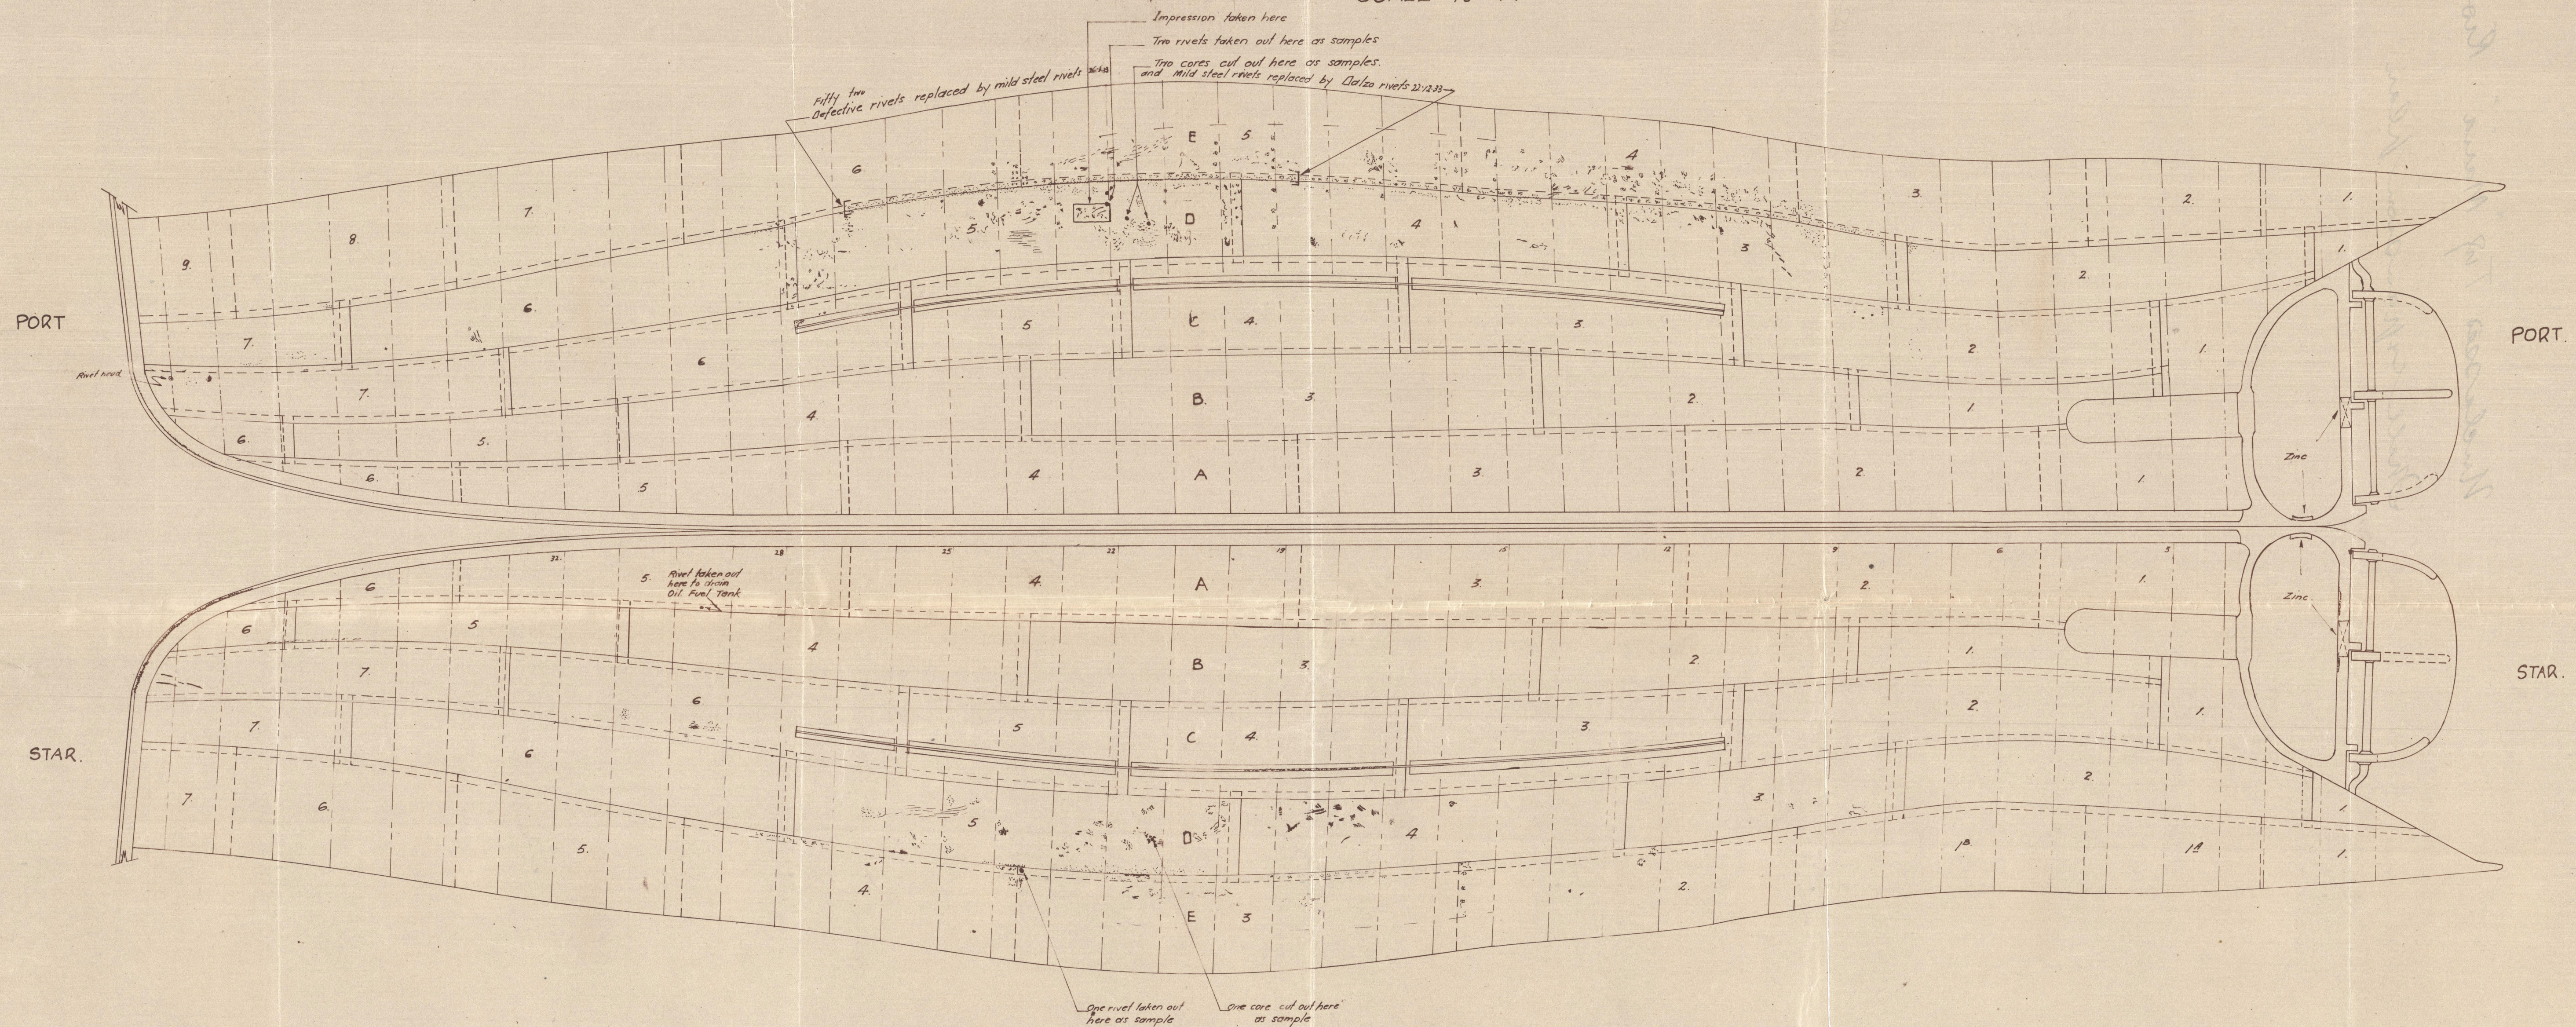

R.I.C. No. 4423 V
EXP. 30765
DATA 21.12.33
ARCH. 21.12.33

Unclassified Tug "Maria" Rio Rept. No. 2490

Shell expansion plan.



© 2020

Lloyd's Register
Foundation

W1253-0016