

Nº 803 SHIP

Dimensions

Half breadth = 53.12
 Depth = 51.83
 Half breadth = 53.34
 109.82
 Depth = 7.00
 1st Dimension = 102.82
 2nd Dimension = 383.166
 3rd Dimension = 39.394

Length - Depth = 13.23
 Length - Breadth = 7.55
 L
 D
 15.9

Section

through Oil Compartments

Moulded Dimensions 385' 0" x 50' 7" x 30' 2"

Scale 1/2" = 1 Foot

Class - 100 A. 1. Lloyd's 3 Deck Rule

No reduction from Moulding Dimensions to be made

Oil Tanks Nos 2, 3, 4, 5, 6, 7

Equipment



Riveting Notes

all butts and seams to be lap joints except butts of Upper Deck Sheerstrake outside of Bridge and Bridge Deck Sheerstrake, which are double straps, butts riveted for 1/2 length amidships
 Butts of Sheerstrake at ends quadruple riveted laps
 Remainder of shell butts below Sheerstrake quadruple riveted laps for 1/2 length amidships, butts riveted at ends
 Keel plate butts quadruple riveted laps
 Butts of Prop and Forecastle and double riveted laps throughout
 Butts of Bridge Sides (excluding Sheerstrake) quadruple riveted laps
 Butts of Bridge Sides riveted at ends of Bridge, single elsewhere
 Butts of Upper Deck Stringer quadruple riveted for 1/2 length amidships, butts riveted at ends
 Butts of Main Deck Stringer Plate butts riveted all fore and aft
 Butts of Main Deck Plating double riveted in way of oil for 1/2 length amidships, and single at ends
 Butts of Upper Deck Plating to be double riveted for 1/2 length amidships, remainder double riveted
 Butts of Bridge Stringer Plate quadruple riveted
 Butts of Bridge Deck Plating double riveted and seams single riveted
 Butts of Central Bulkhead and Expansion Transverse Bulkhead Plating double riveted
 Butts and seams of Transverse Bulkheads double riveted in Hold, single riveted in Tween Decks
 Butts & seams of double bottom (See Section through Engine & Boiler Rooms)

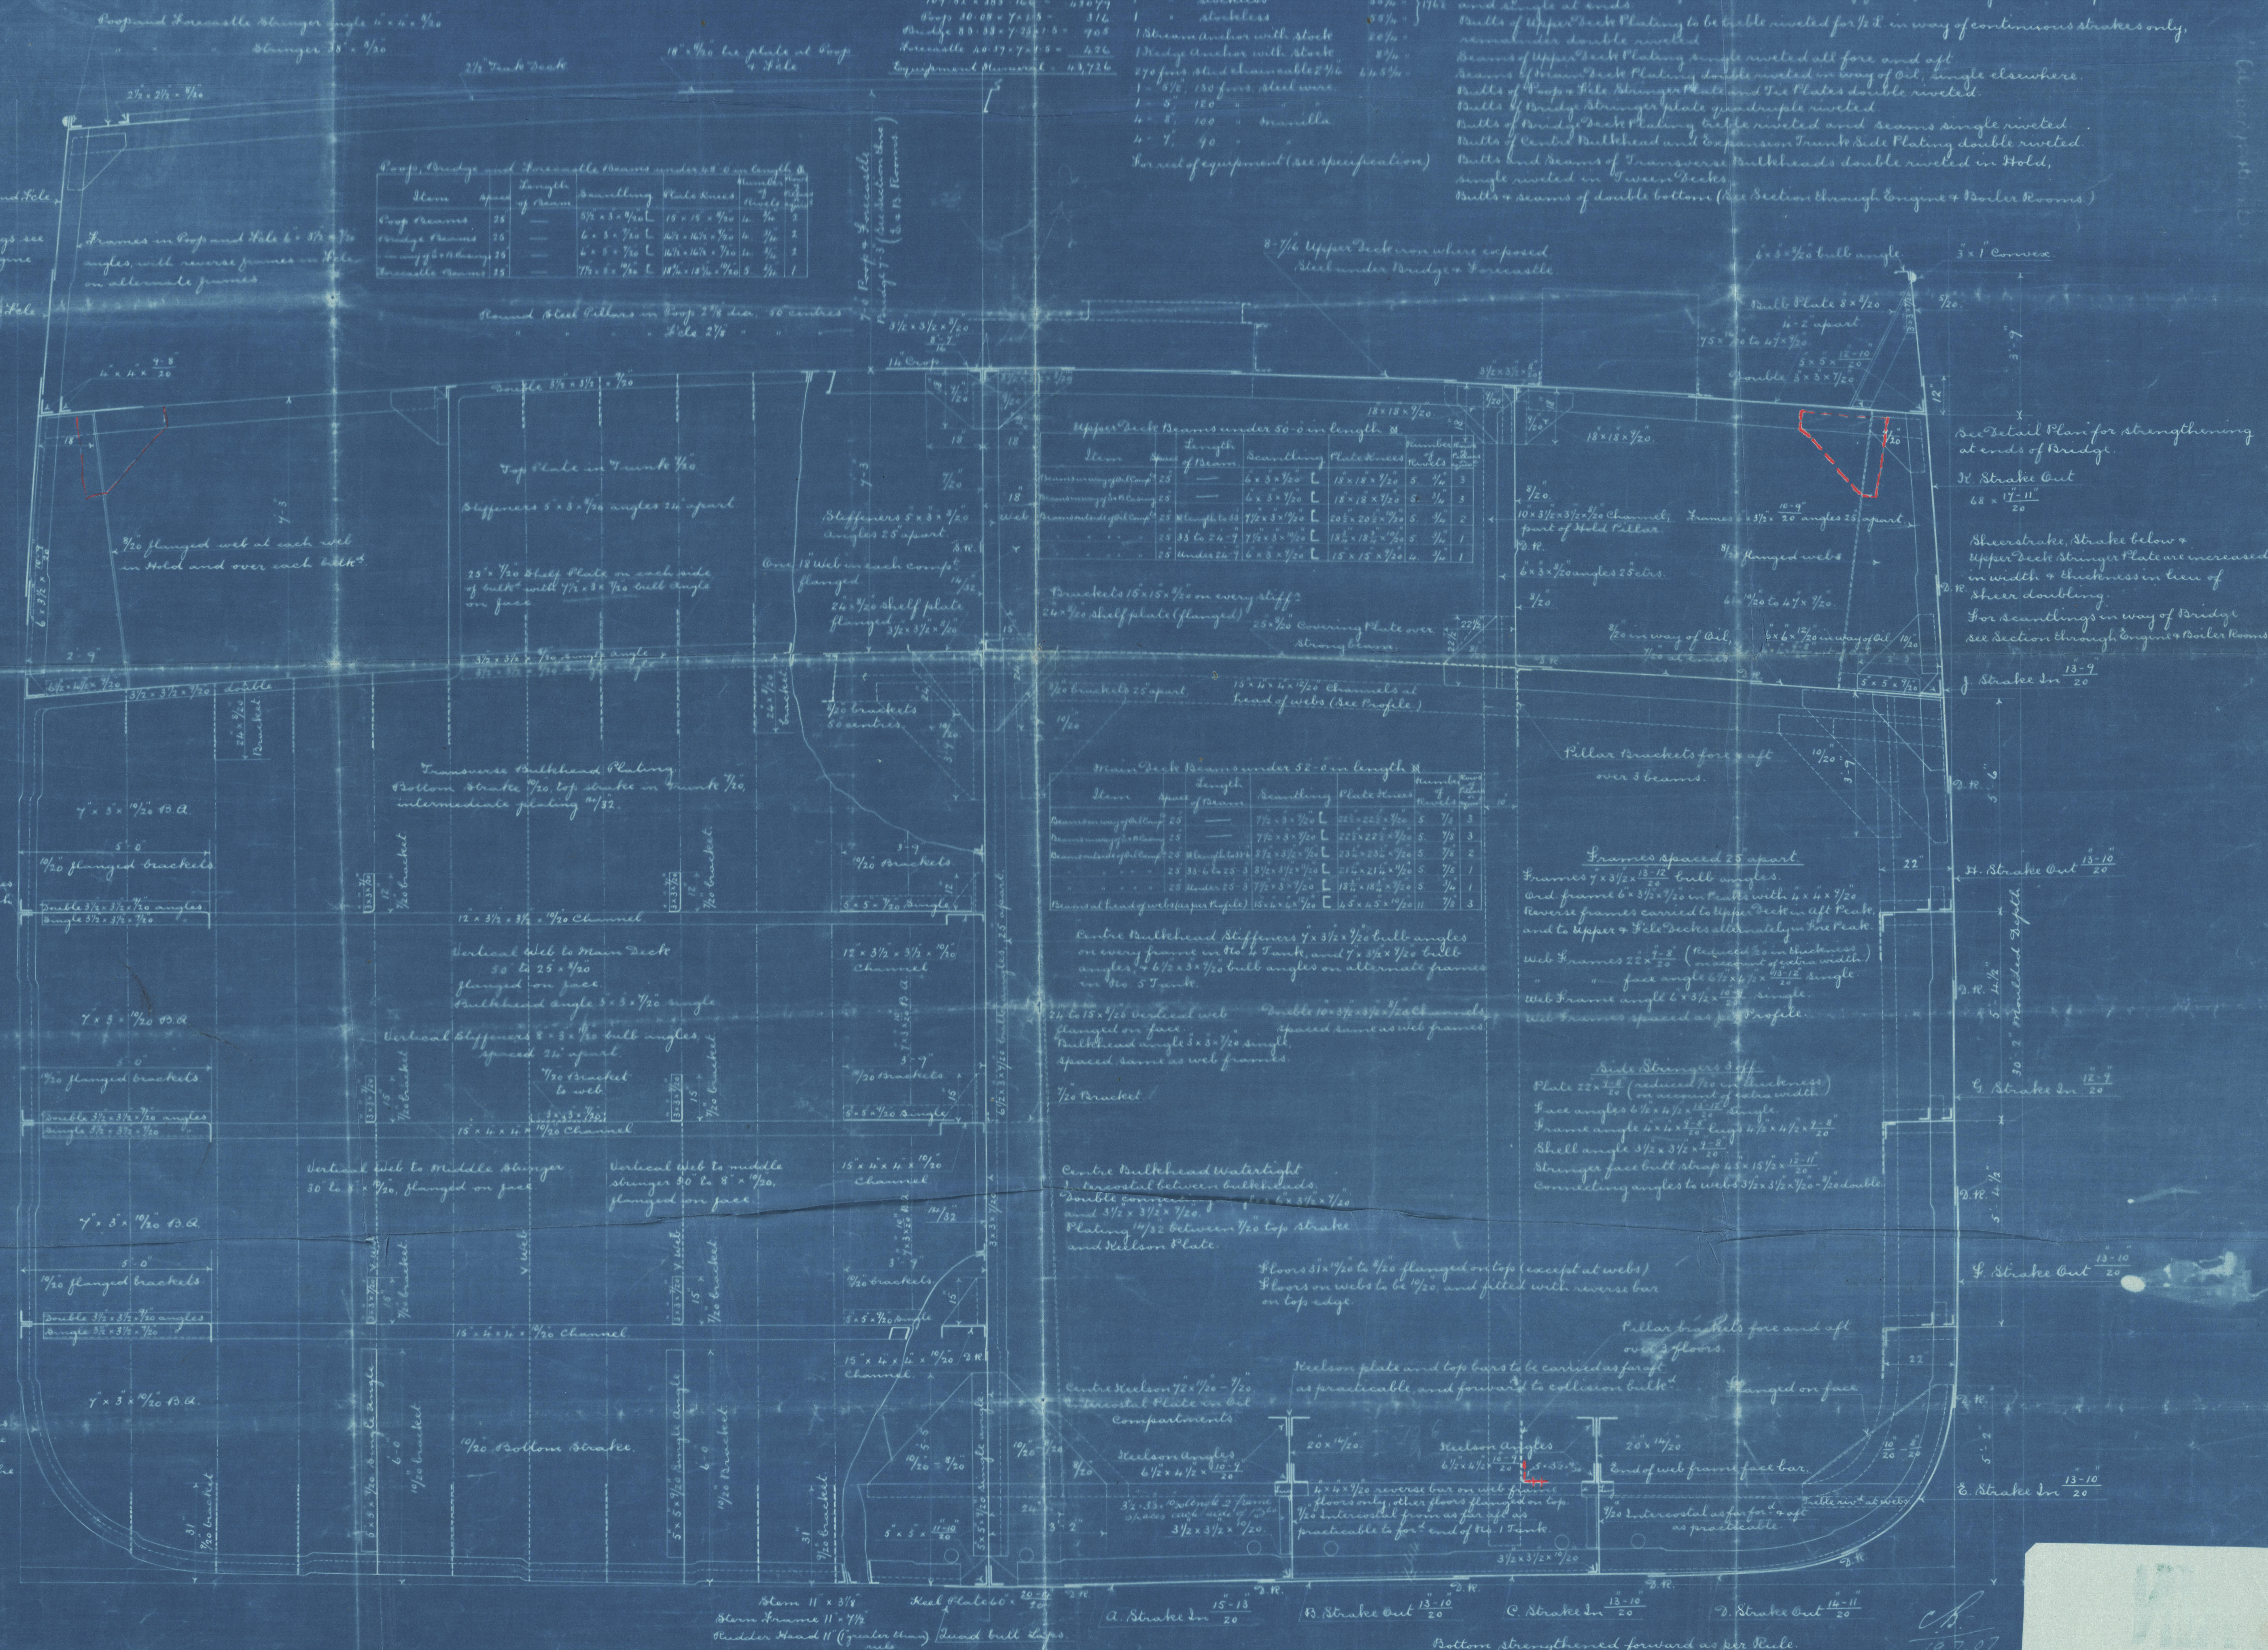

19.7.07

Midship Section
S.S. No. 803

Romanian
Armstrong Whitworth

Duplicate of
S.S. Carpathian
Kwv Rep^r 55167

"
S.S. "Romanian"

Newcastle Report

AP^o 55378

W1254-0080

REMAIN