

Rpt. 6.

For the information of Surveyors and the Committee only.



Received at _____ Office, _____

Lloyd's Register of British & Foreign Shipping.

(Report on Vessel No. 19850 Port Hull
1/3 Ardent)

No. 1669A SHIP FORGINGS OR CASTINGS.

The records FORGINGS or CASTINGS, IRON or STEEL, should be struck out as may be required.

I have to report that the undermentioned Iron or Steel Forgings or Castings, manufactured by Messrs T.S. Forster & Sons of Sunderland for the Vessel No. 112, being built by Goole Shipbuilding Co of Goole have been inspected by me as set forth below and found to be, so far as can be seen, Sound.

Mark on Forgings.


Lloyd's
No. 1669A
J.D.

Jervis Dale


Sunderland
7-11-07

	STERN FRAME.	RUDDER FRAME.	STEM.
Material*	<u>Scrap iron</u>	<u>Scrap iron</u>	/
How made	<u>Forged & smithed</u>	<u>Forged & built</u>	
Dimensions	<u>6 X 2 1/2</u>	<u>4 1/2 Stack</u>	
Progress on Inspection	<u>Forging & smithing</u>	<u>Forging & machining</u>	
Date when Inspected	<u>21/8/07</u> <u>30/8/07</u>	<u>11/10/07</u> <u>6/11/07</u>	

SKETCHES OF FRAMES SHOWING POSITION AND DESCRIPTION OF WELDS OF FORGINGS, OR PARTICULARS OF TESTS APPLIED TO CASTINGS.

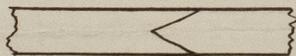

Welds

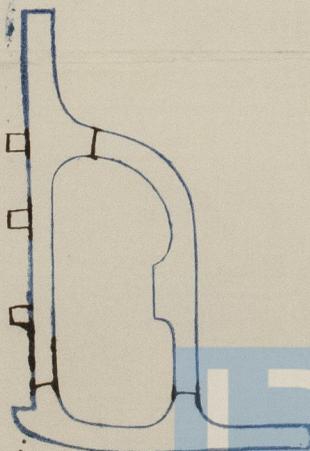

Fee (if any chargeable) £ :

To be paid at _____

* If of Iron, state whether scrap or puddled Iron.