


22.8.07.

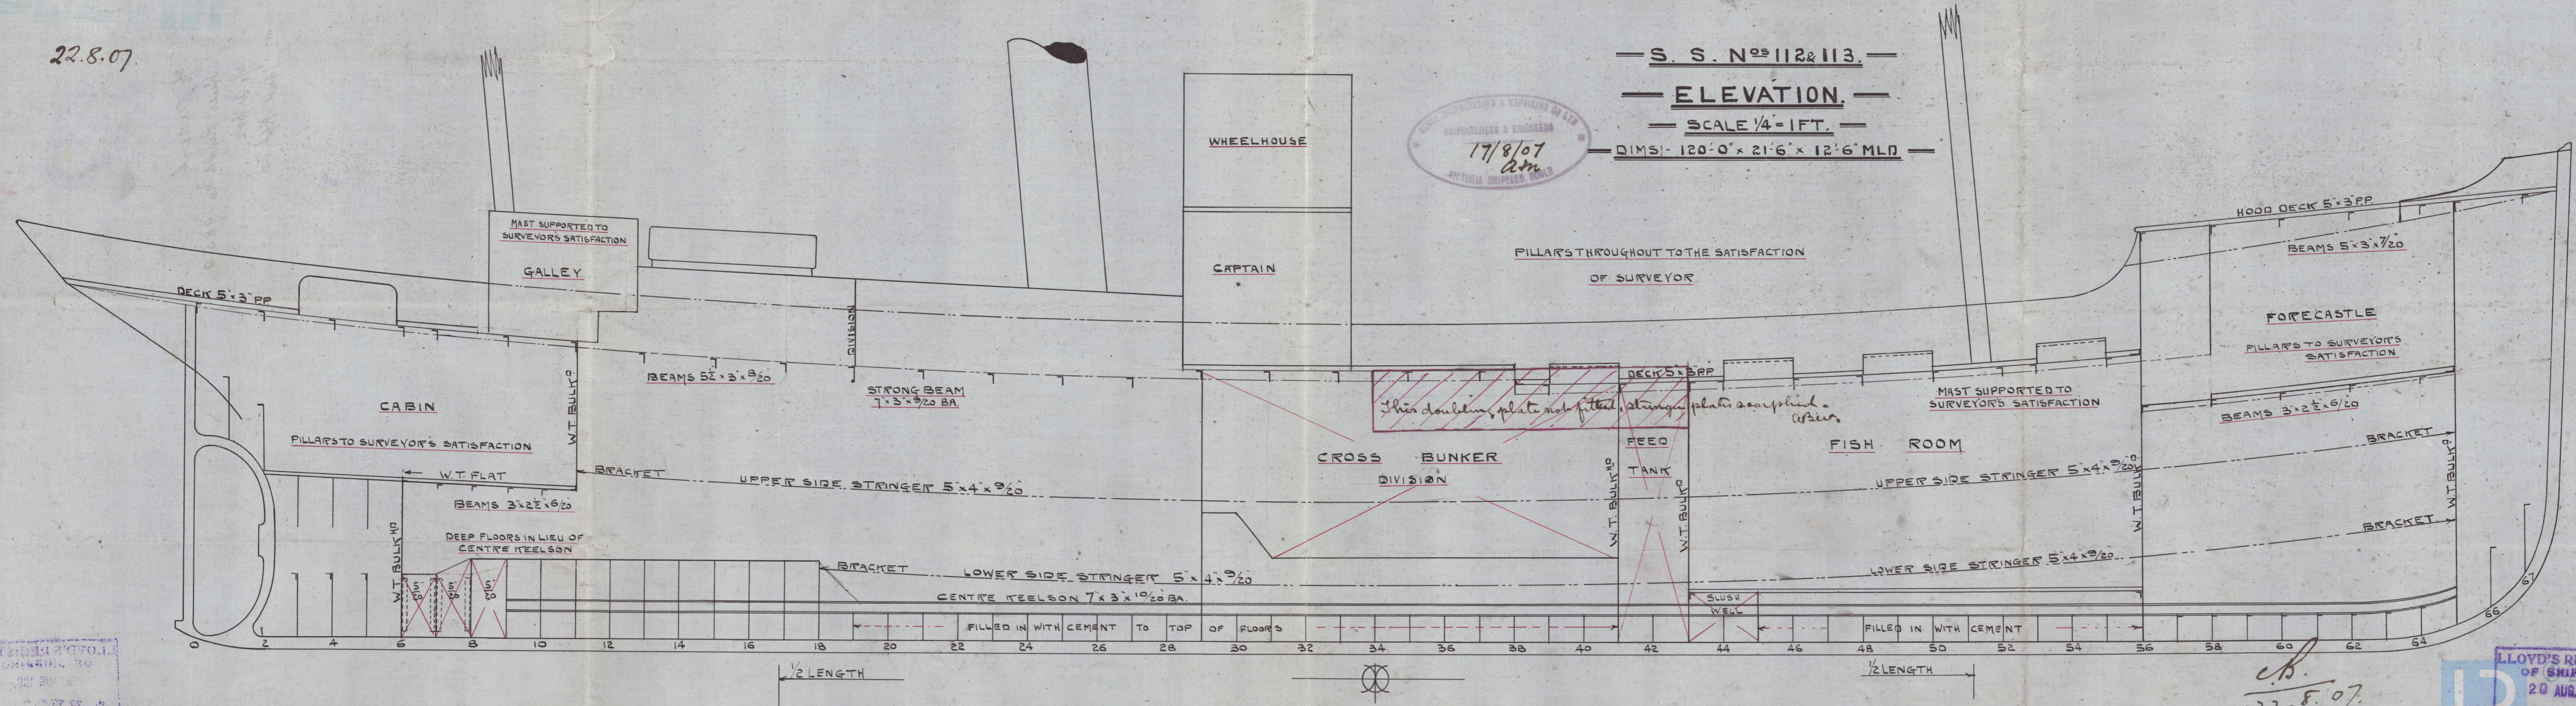

S. S. N^{os} 112 & 113.

ELEVATION.

SCALE 1/4" = 1 FT.


17/8/07
A.M.
VICTORIA SHIPYARD, B.C.

NOTED BY 10701
20 AUG 1907
22.8.07

22.8.07.

LLOYD'S REGISTER
OF SHIPPING
20 AUG 1907
W1255-0039

Book S. R. C. Sin
N^o 112 + 113
Profile.



S/s Ardent
Hull Report No 19850
S/s Arbor
Hull Rpt No



© 2021

Lloyd's Register
Foundation

W1255-0039