

SCALE $\frac{1}{2}$ IN = 1 FT.


<u>NUMERALS.</u>	
HALF BIRTH	19.00
" BREADTH	10.75 ✓
DEPTH	¹²⁻⁹⁴ 13.00
1 ST NO.	42.75 69
LENGTH	118.87 ✓
2 ND NO.	⁷⁴ 508.69

$$\frac{L}{B} = 5.52.$$

$$\frac{L}{D} = 9.14^8$$

EQUIPMENT No. 5084.

✓	1	ANCHOR	6 CWT	2 QR.	7 LBS	STOCKLESS.
✓	1	"	4 3/4	CWTS	EX	STOCK.
✓	1	"	2 1/2	"	"	"
✓	90	FATHOMS	1"	STUD	LINK	CHAIN.
✓	60	"	6"	HAWSER.		
✓	60	"	4 1/2	WARP		

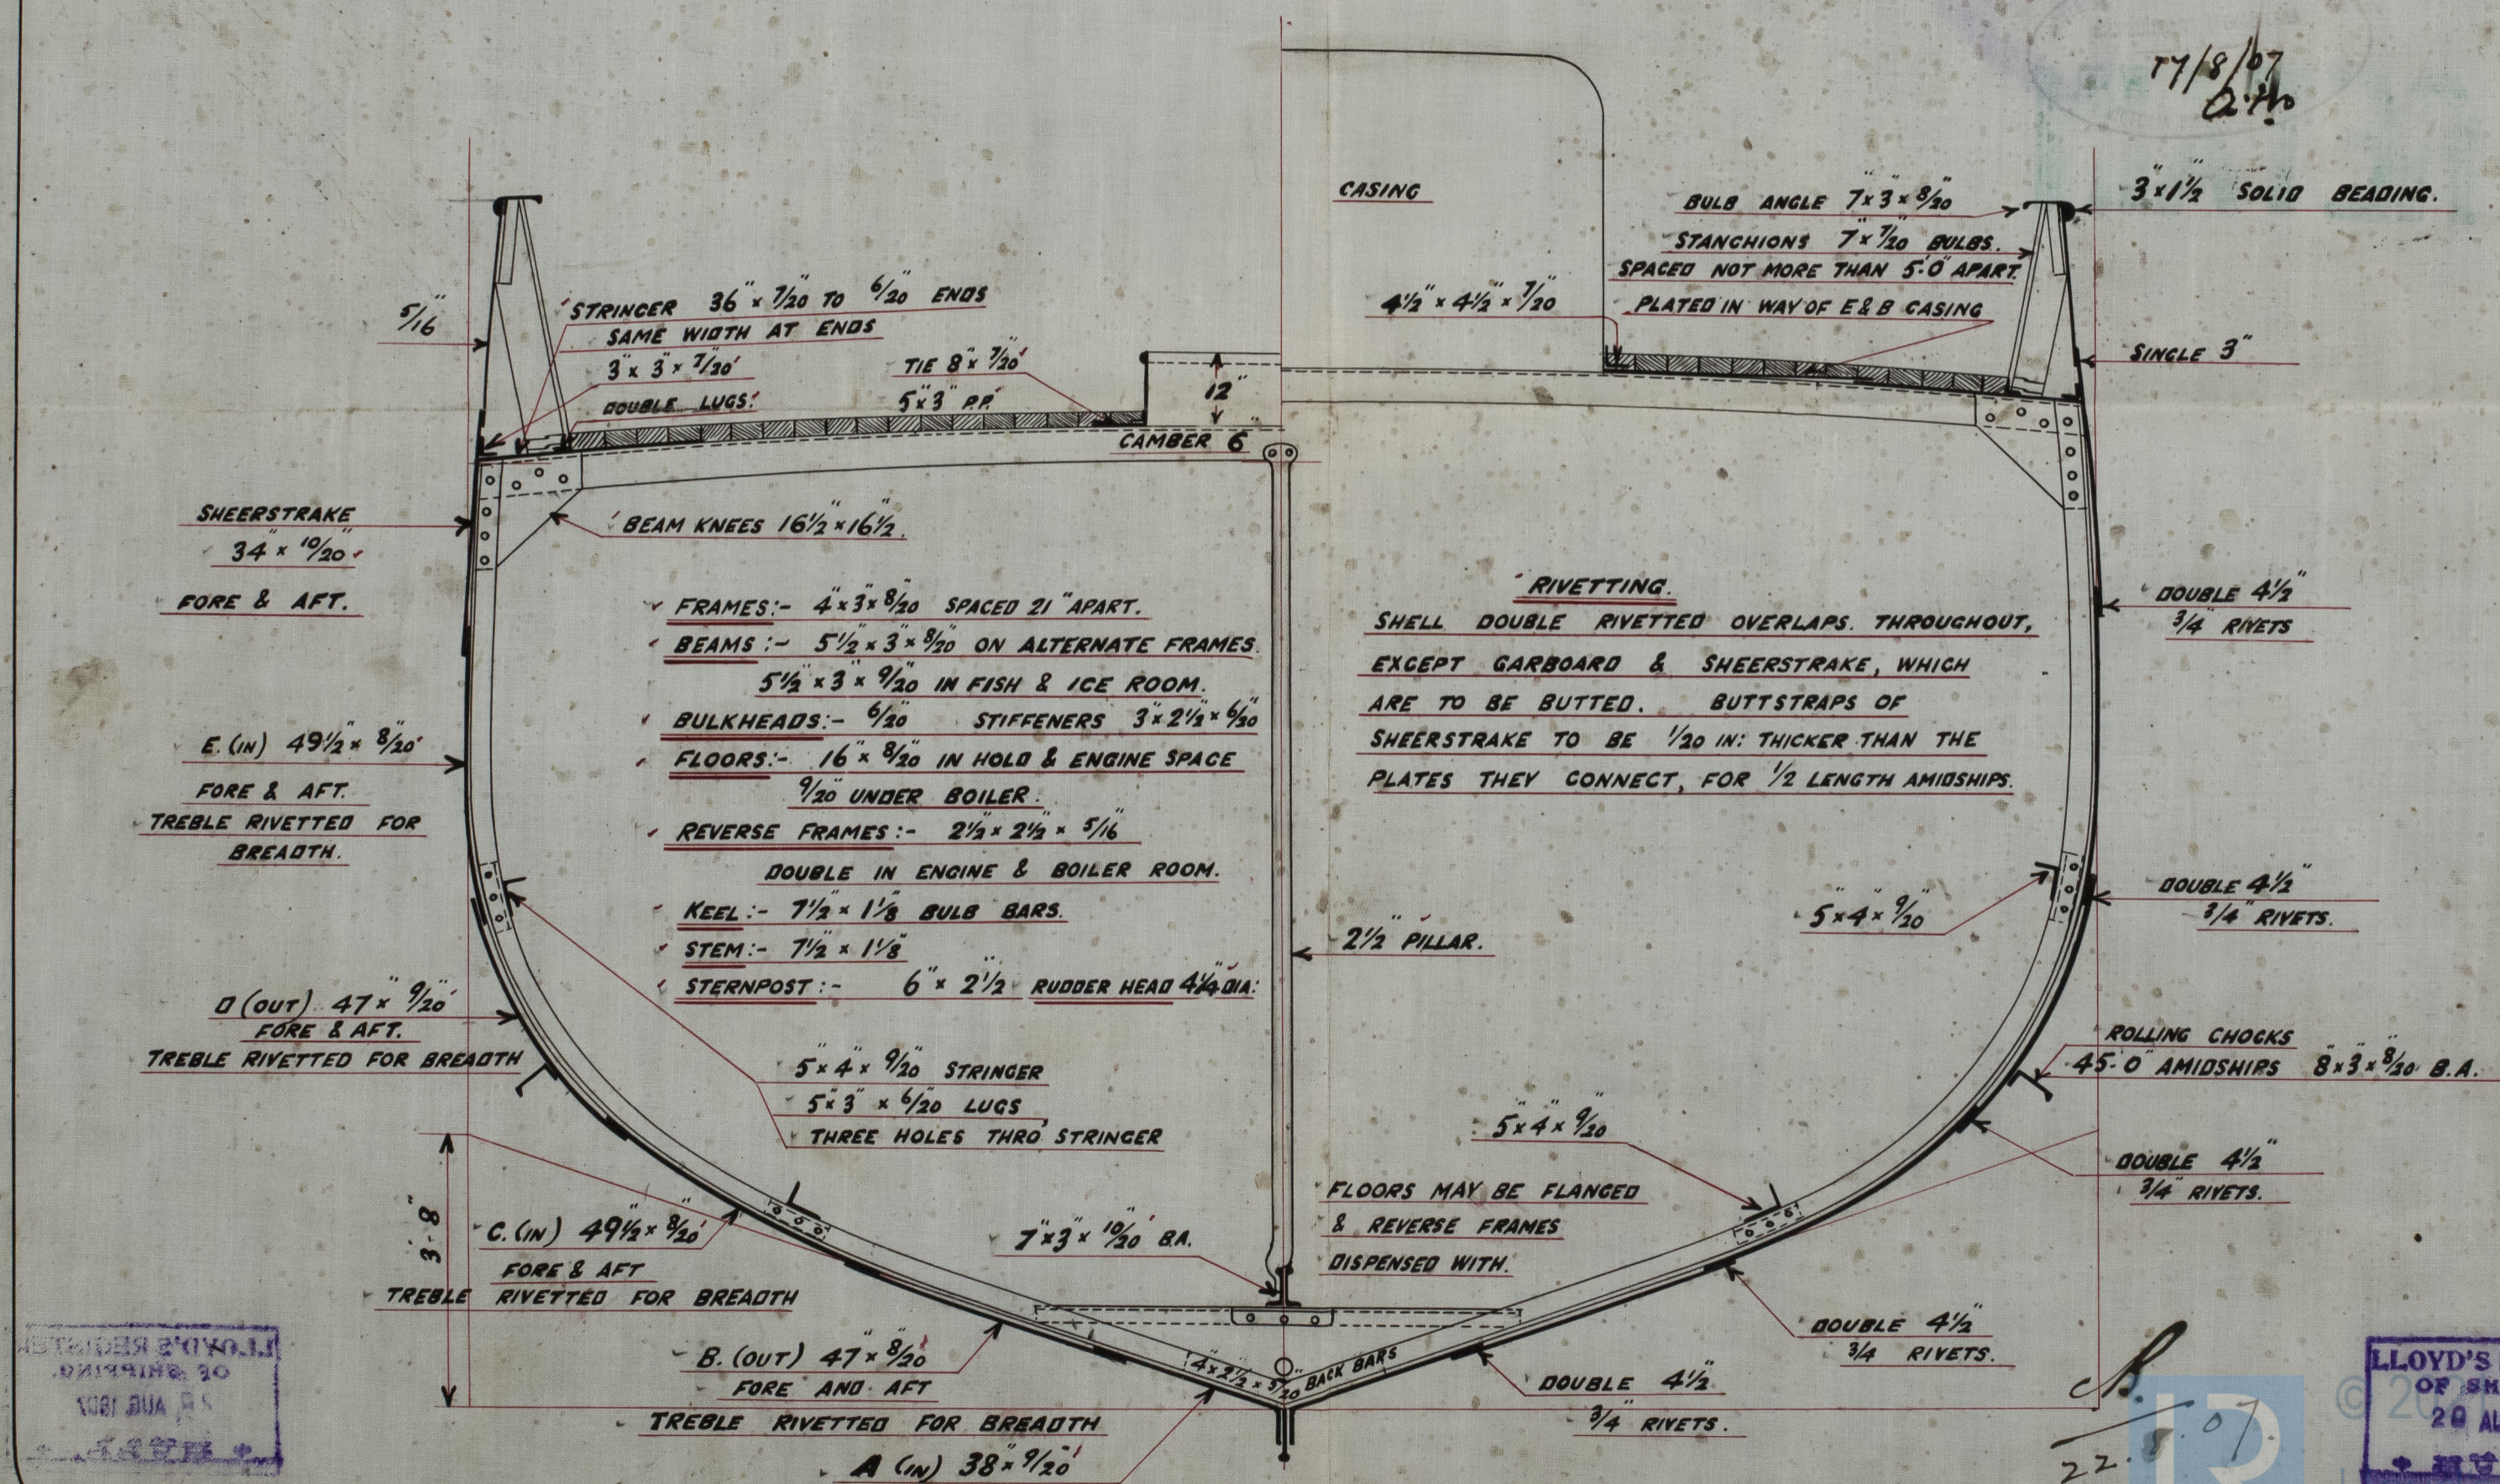

LLOYD'S REGISTER
OF SHIPPING.
20 AUG. 1907

Lloyd's Register
Foundation

W1255-0040

Book S. + R. C. - Sim

Nº 112 + 113.

Midship Section.

Nº 112 "Ardent".

Nº 113 "Arzon".

25




RETAILED



© 2021

Lloyd's Register
Foundation