

20.6.13.

# MIDSHIP SECTION

N<sup>OS</sup> 581, 2, 3, & 4.



STEEL SCREW TRAWLERS

DIMS 121'-8" B.P. x 22'-0" E.H. x 13'-0" M.L.P.

SCALE 1/2 INCH = 1 FOOT

TO CLASS 100 A1 LLOYDS STEAM TRAWLER

DECK PLATED OVER IN WAY OF  
MACHINERY SPACE. E. & B. CASING  
AS PREVIOUSLY APPROVED

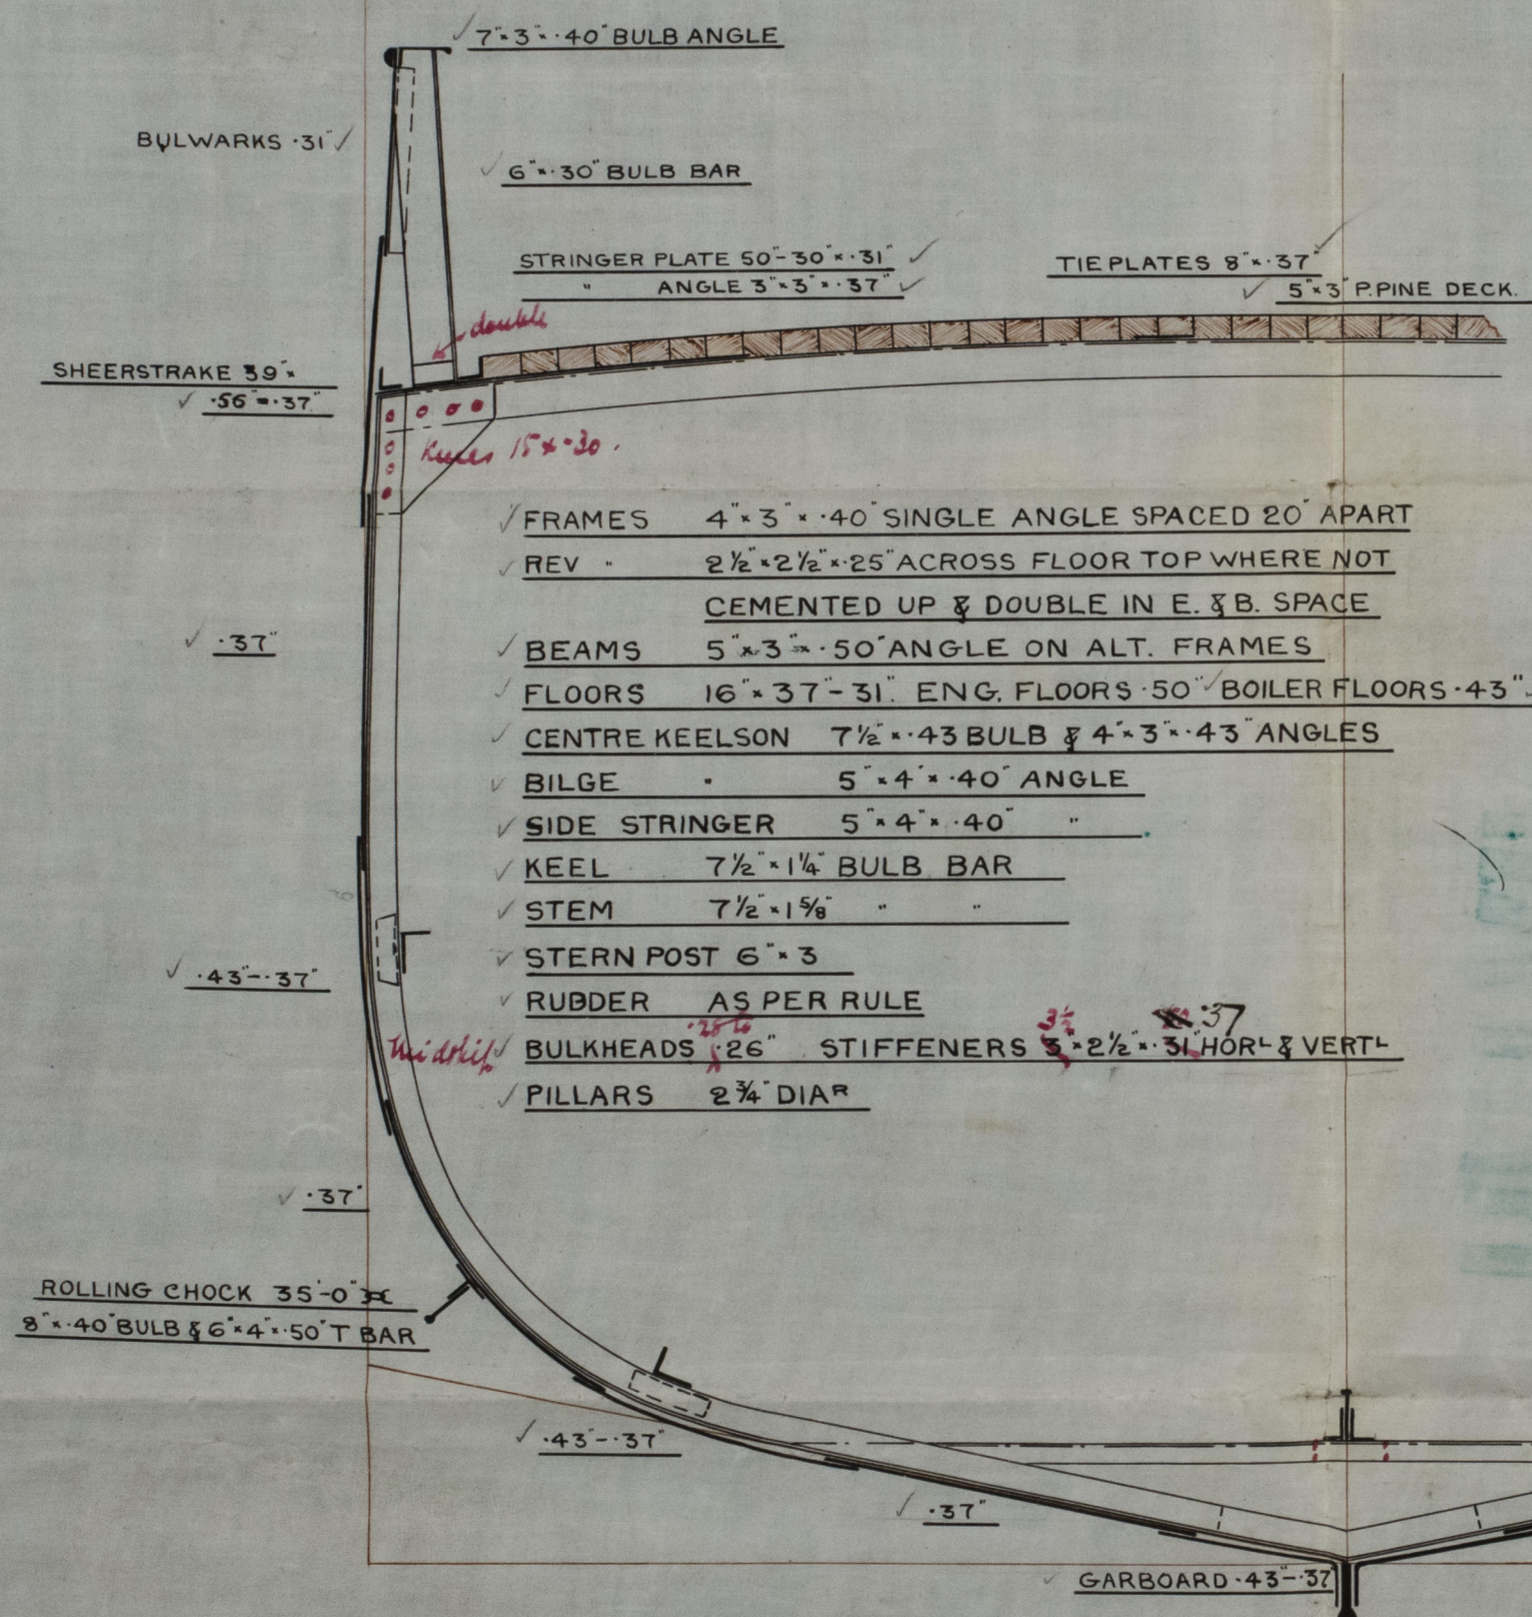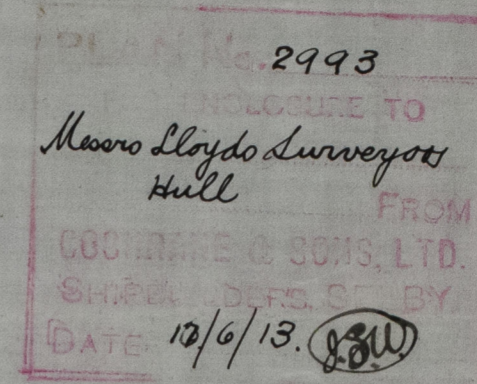

## NUMERALS

B+D ----- 34.85 ✓  
L x (B+D) ----- 4239.85 ✓

## PROPORTIONS

L/D ----- 9.35 ✓  
B/D ----- 5.56 ✓

## EQUIPMENT

✓ 1 <sup>ST</sup> BOWER ANCHOR	5 1/4 CWTs EX STOCK
✓ 2 <sup>ND</sup> "	4 3/4 " " "
✓ KEDGE "	2 1/2 " " "
✓ 90 FATHOMS	1" CABLE
✓ 60 "	6" HAWSER
✓ 60 "	4 1/2" WARP

## RIVETING

✓ LANDINGS DOUBLE RIVETED BULWARKS SINGLE RIVETED  
✓ BUTTS TO BE LAPPED & DOUBLE RIVETED EXCEPT GARBOARD  
✓ & SHEERSTRAKE WHICH ARE TO BE STRAPPED & DOUBLE RIVETED

C.F.  
20/6/13

Cochrane & Sons, Ltd

No 581. 582. 583 and 584

Midship Section.

Dimension

121.66 x 21.85 x 13.0




7. Blyth Hull Hgt No: 27083

Agate

27127

Beryl

27185

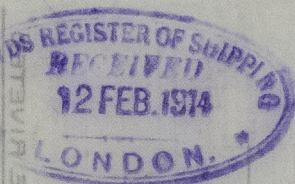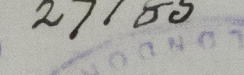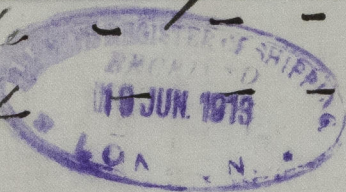



















© 2021

Lloyd's Register Foundation  
W12 55-0248