


~~No 507~~ 509

# MIDSHIP SECTION.

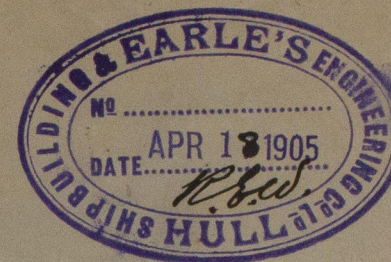

20.4.05

DIMS. 130' B.P. x 22'-1" M<sup>LD</sup> x 12'-10" M<sup>LD</sup> - 12'-0" H<sup>LD</sup>.

STEEL - CLASS 100 A.1. (FOR FISHING PURPOSES.)

SCALE 1/2" = 1 FOOT.

1/2 GIRTH. 20.16

1/2 BREADTH. 11.04

DEPTH. 13.33  
44.53 1<sup>st</sup> N<sup>o</sup>

128.792 LENGTH PER RULE.

8906

40077

31171

35624

8906

4453

5735.10776 2<sup>nd</sup> N<sup>o</sup>

$\frac{L}{B} = 5.83$   $\frac{L}{D} = 9.64$

## EQUIPMENT.

ONE ANCHOR 5 3/8" CNTS EX. STOCK



5 1/4"

3"

105 FTHMS 1 1/2" CHAIN.

60 -- 6" HANSE.

60 -- 5" WARP.

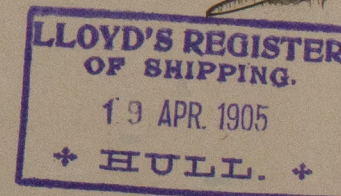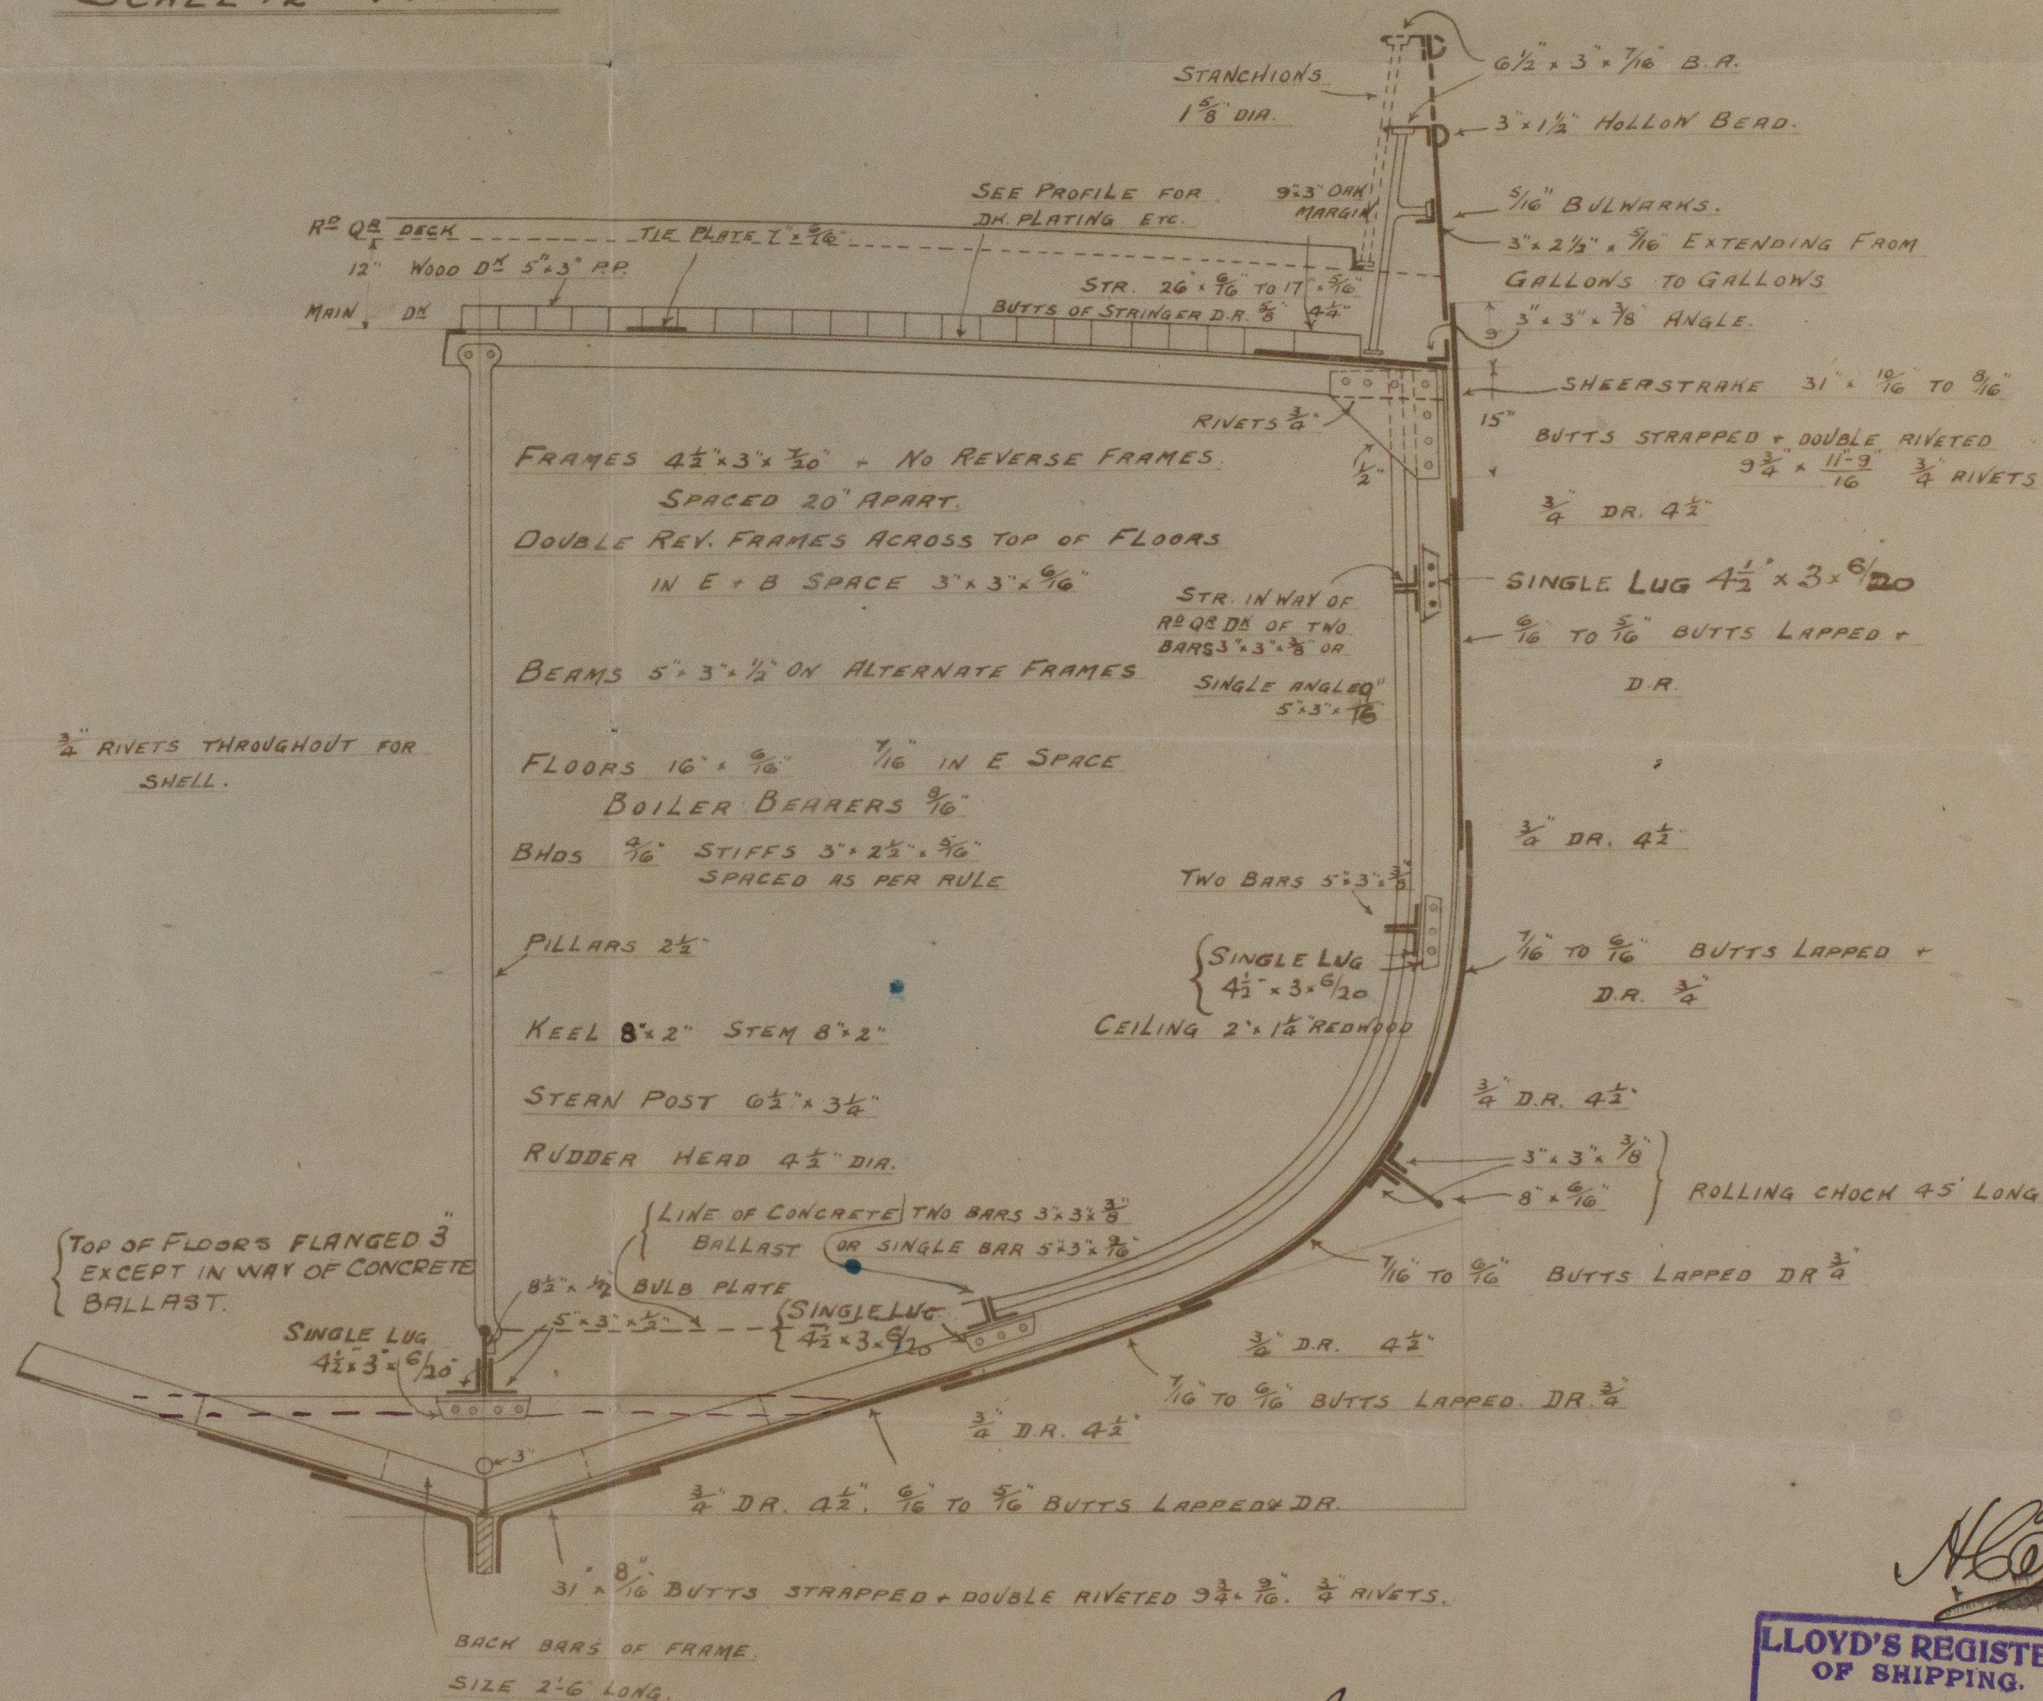

C.B.  
20.4.05.



© 2020

Lloyd's Register  
Foundation


W1256-0369



Earle's S & E. Co Ltd


No 509

Midship Section

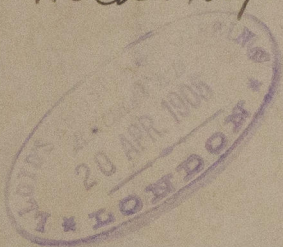

of "Marshal Oyama"

Hull Report No. 17282

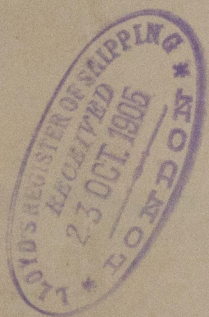

WELAIN

© 2020

Lloyd's Register  
Foundation

W1256-0369