

20.4.05



202 1111 N^o 509

PROFILE & DECK PLAN.

130.0 BP x 22.1 M² x 12.10 MLD.

TO CLASS 100 A.1 STEEL
FOR FISHING PURPOSES.

SCALE 1/4" = ONE FOOT.

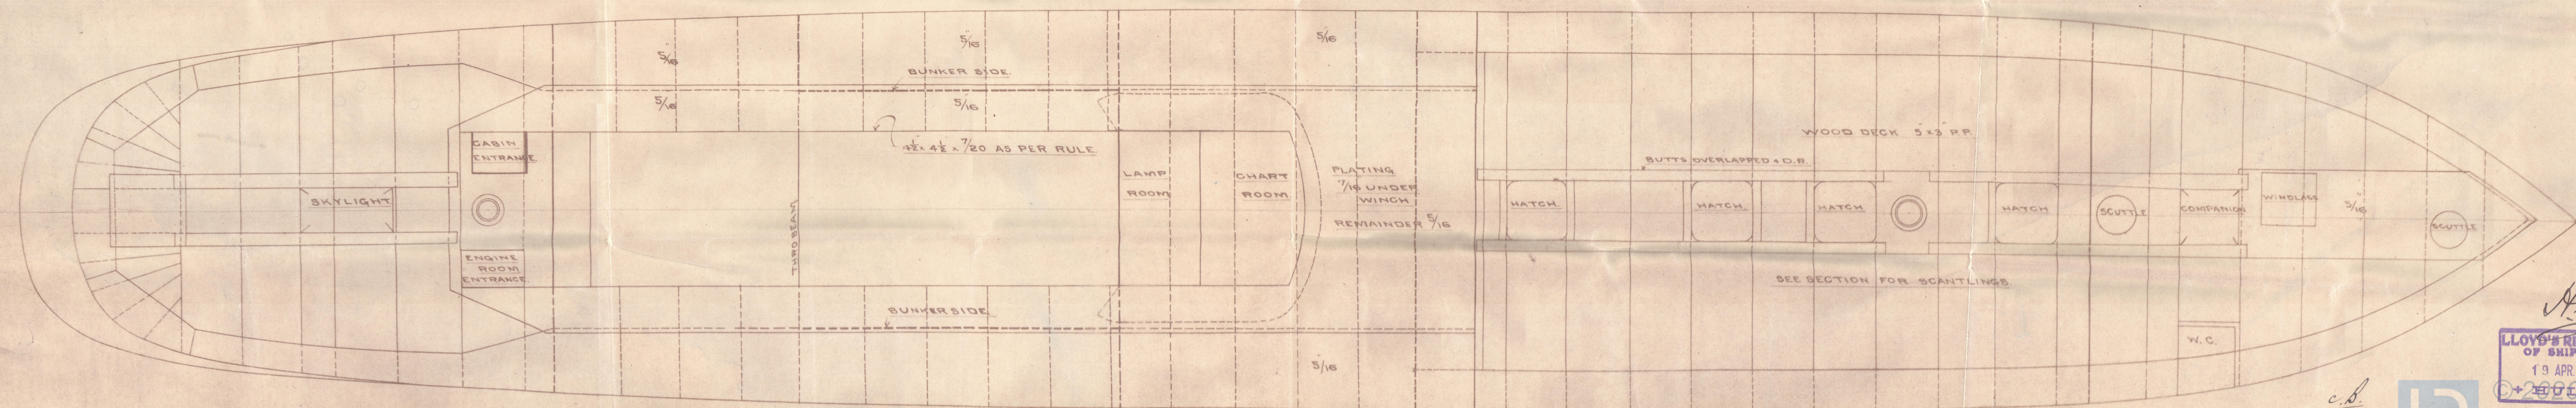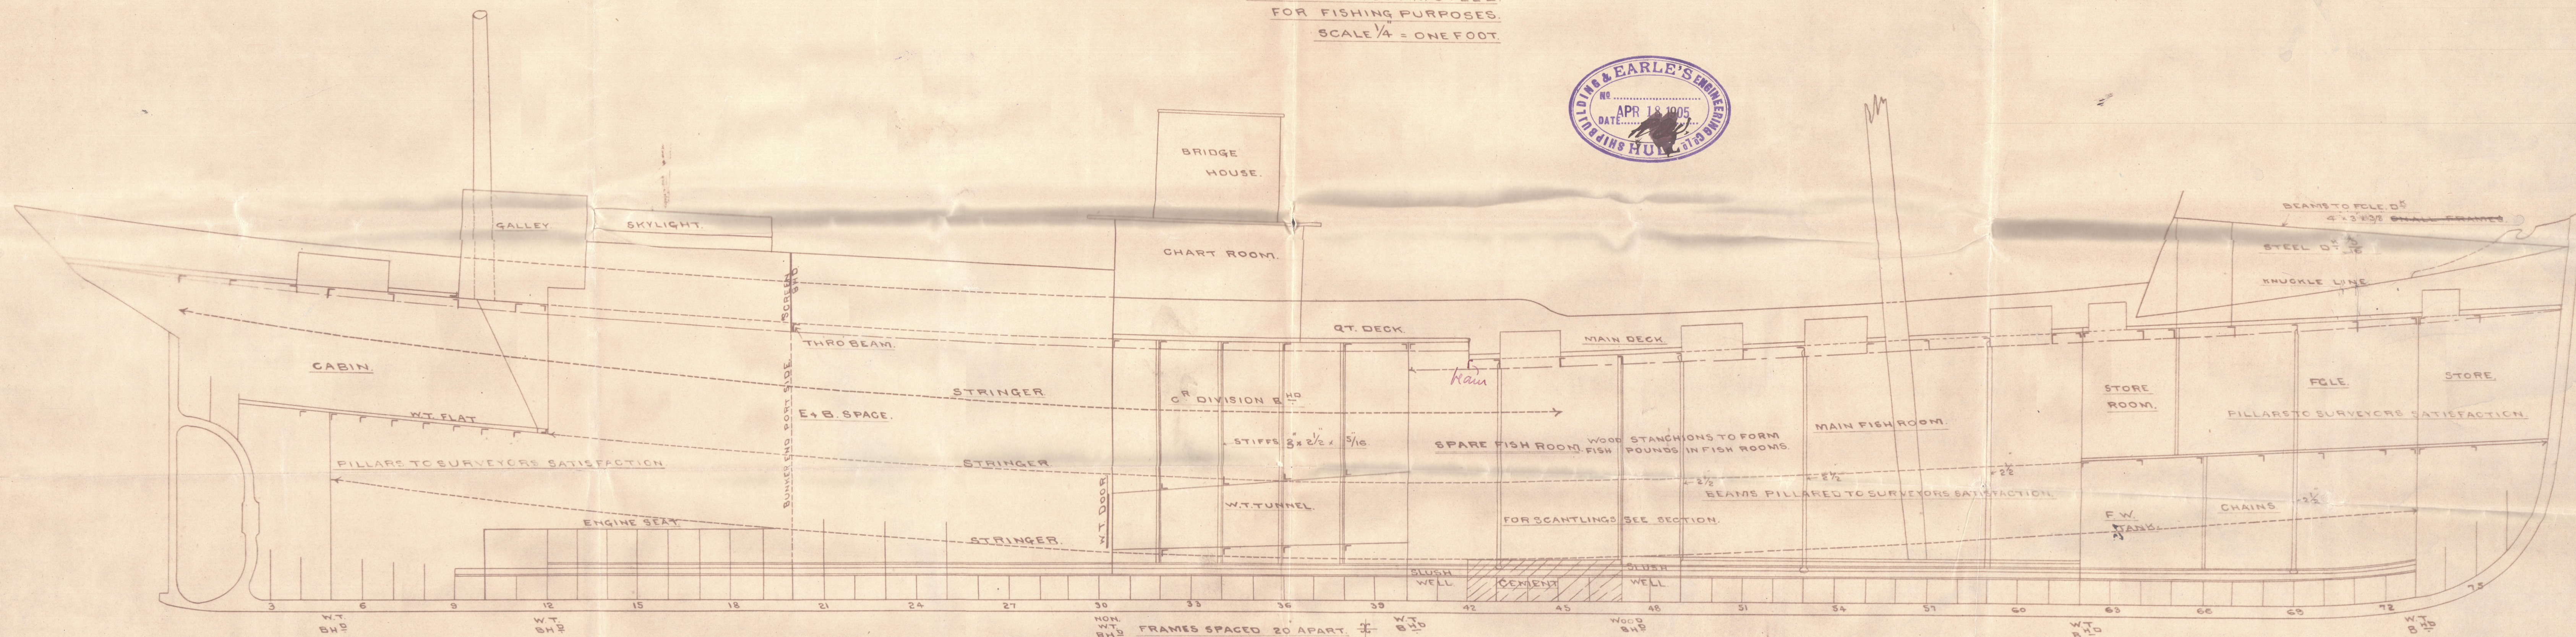

20.4.05



Lloyd's Register
Foundation
W1256-0370


Earle's S+E boks

— No 509 —

Profile & Deck Plan.

of Marshal Oyama

Hull Report No. 17282

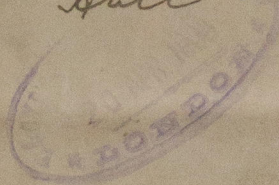

© 2020

Lloyd's Register
Foundation

W1256-0370