

# S.S. N<sup>o</sup> 65 & 66 Steamtrawlers

## Midshipsection.

Scale 1"=1'-0".

### PRINCIPAL DIMENSIONS


LENGTH.....120'-0"  
LENGTH BETWEEN PERPENDICULARS.....126'-10 1/2"  
BREADTH MOULDED.....22'-0"  
DEPTH.....12'-0"  
ROUND OF BEAM.....0'-6"  
HALF GIRTH.....19'-2"

### NUMBERS FOR DETERMINING THE SCANTLINGS FOR CLASS 100 A1 LLOYDS.

FIRST NUMBER.....42.86.  
SECOND.....5413.  
LENGTH:DEPTH.....10.5.. LENGTH:BREADTH 3.76.

### EQUIPMENT

1 ANCHOR EXC STOCK 5.5 CWT.....105 FATHOM 1 1/8" CHAIN CABLE.  
1 " " " 5 " " 60 " 6" HAWSER.  
1 " " " 2.75 " 60 " 4 1/2" WARP.

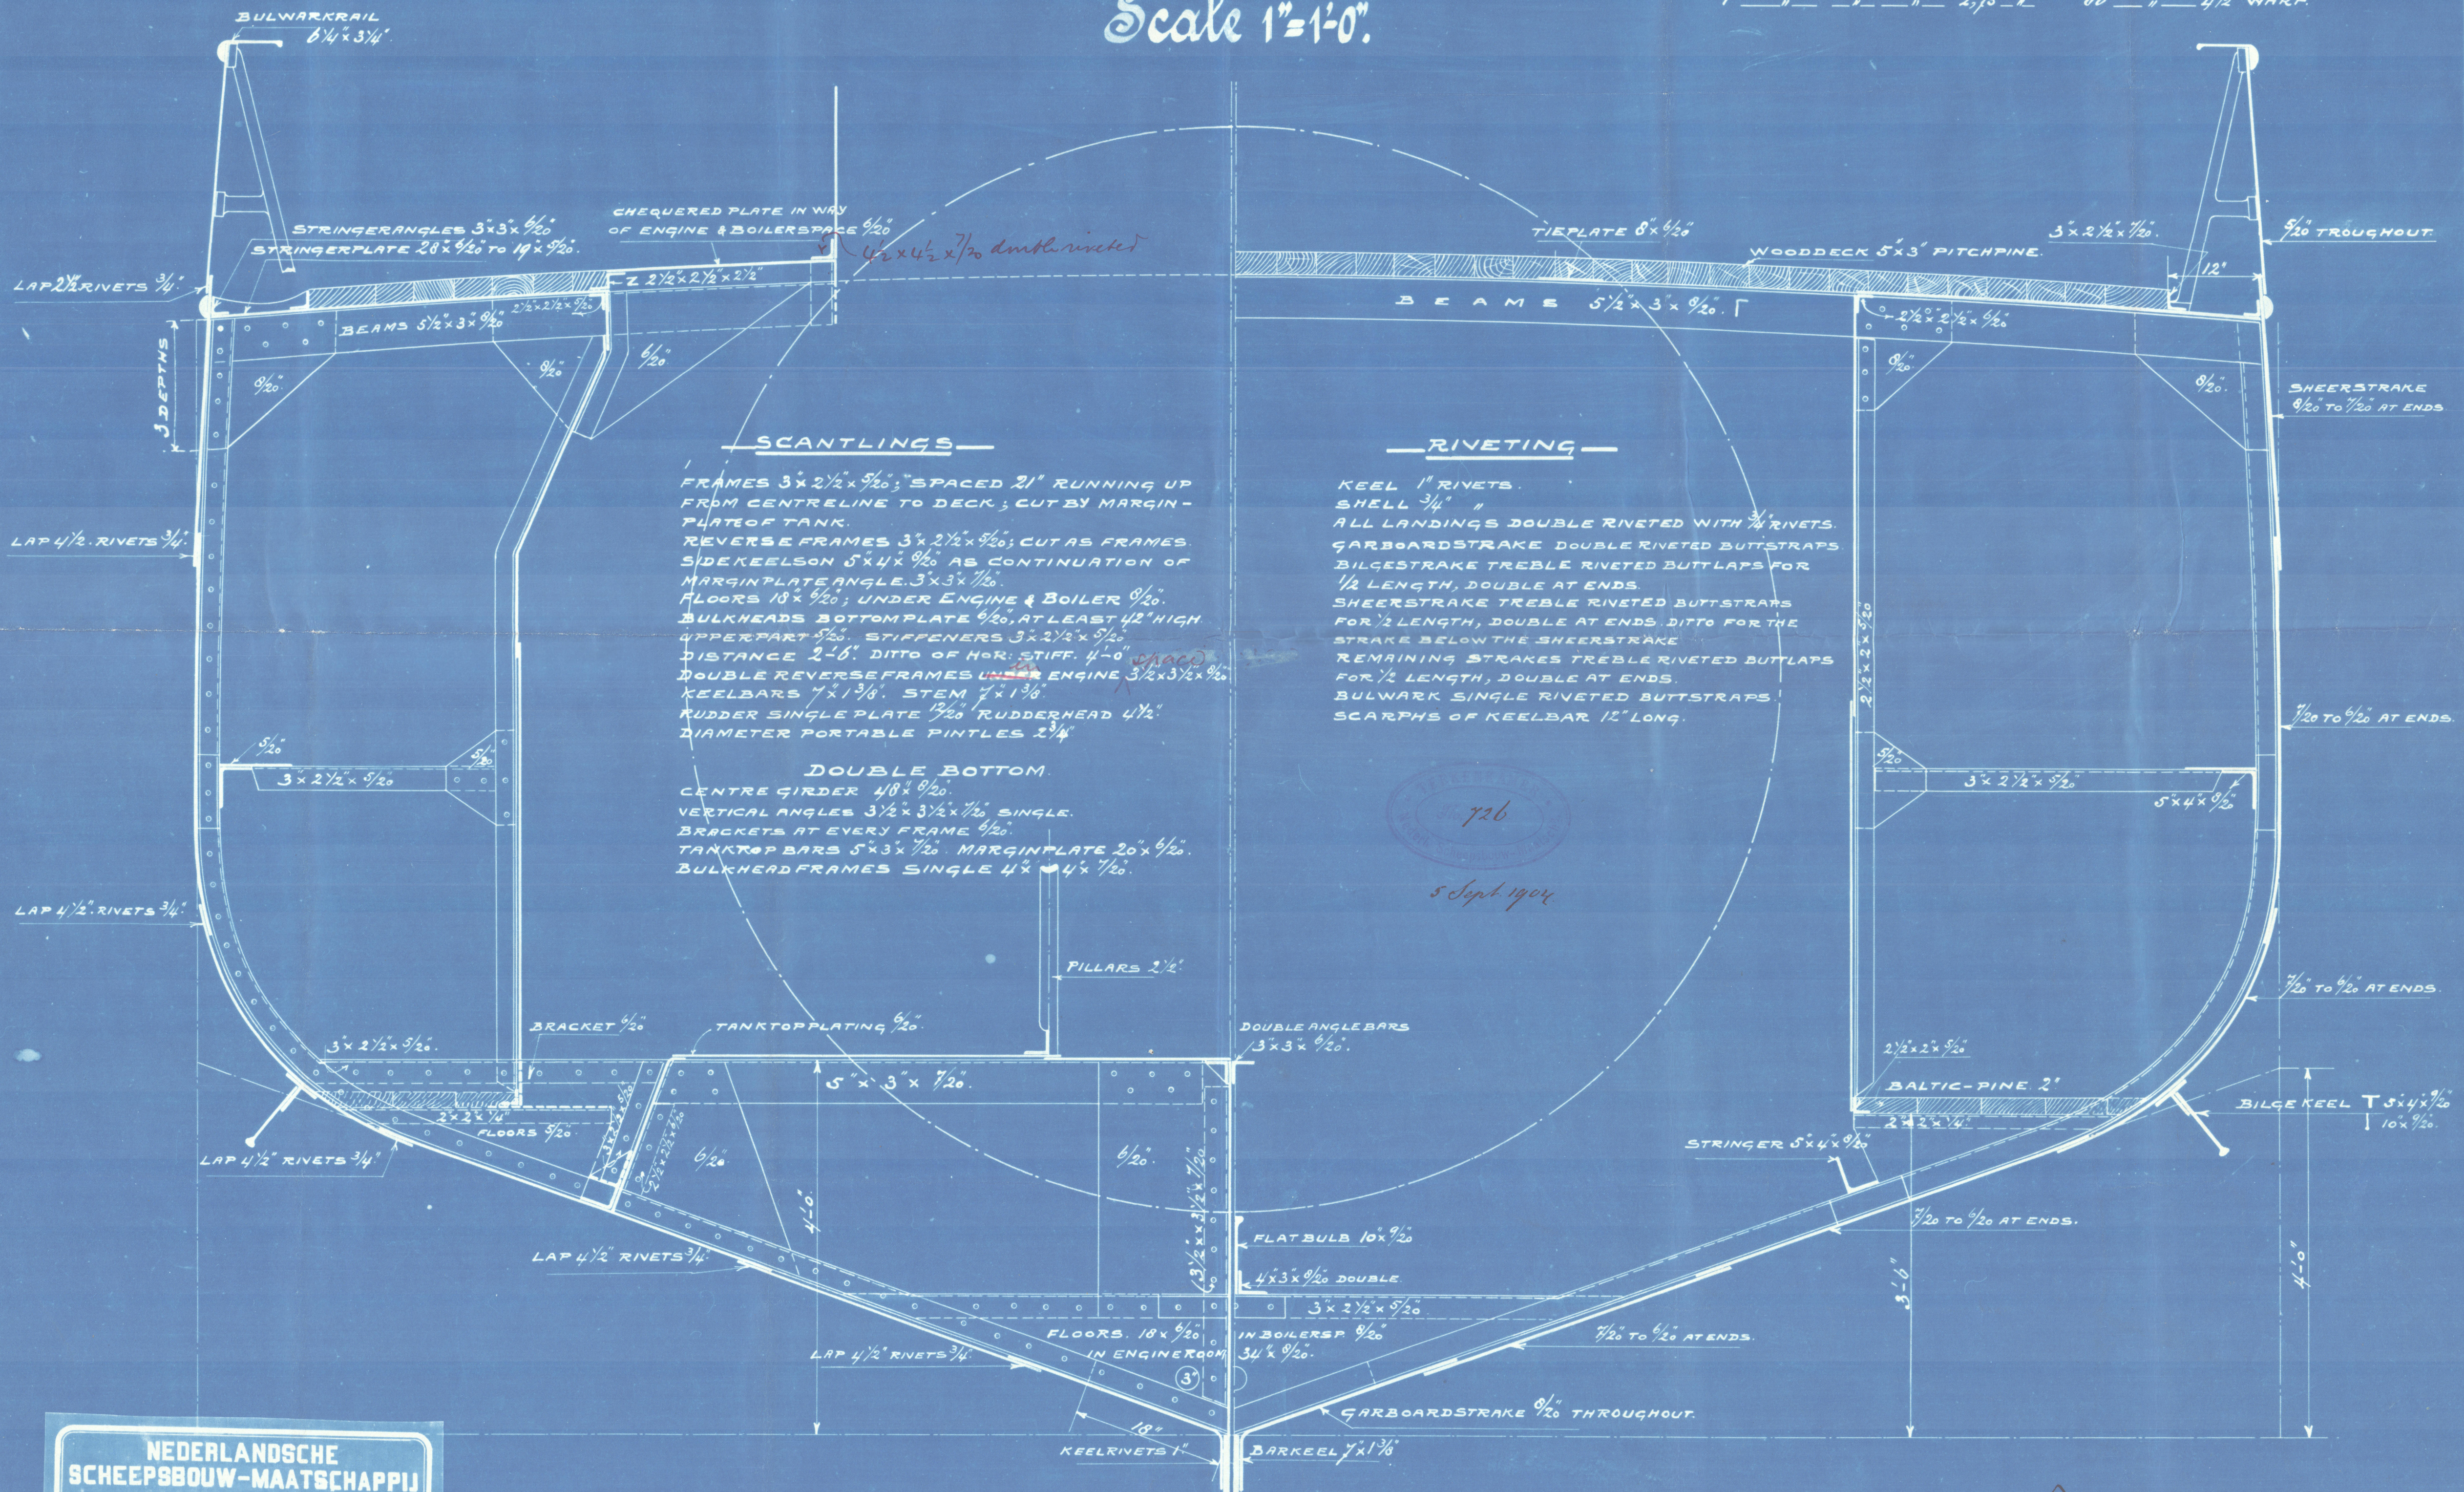

NEDERLANDSCHE  
SCHEEPSBOUW-MAATSCHAPPIJ  
AMSTERDAM

J. 26  
5 Sept 1904




✓ *Shipping Section*



*6566*

---

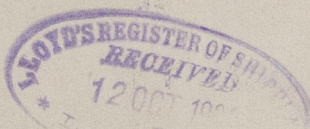

*"Kies en Trans"*

*Ans 3185.*

---

RETAIN



© 2020

Lloyd's Register  
Foundation

W1257-0035