

# PROFILE & DECK PLAN.

T.S.TUG. No 438

Scale 1/4" = 1 Foot

To class LLOYDS A for Towing


APPROVED  
LLOYDS REGISTER OF SHIPPING

*Managers for Lloyd*


DATE 26. 11. 25

CASING TOP .20"  
STIFFEN 2 1/2 x 2 1/2 x .20" SPACED 21" APART  
BEAMS 3 1/2 x 2 1/2 x .25"  
SIDES .30"

CANT FRAMES 3 x 2 1/2 x .26"  
" BEAMS 3 x 2 1/2 x .26"  
TRANSOM FLOOR W.T. .34"  
TRANSOM FRAME & BEAM 2 1/2 x 2 1/2 x .36"  
CANT "C" CORR. TO TRANSOM REVERSED  
TO GIVE ROOM FOR W.T. PLATE COVER.  
ACCESS TO COUNTER ON STAR. ONLY.

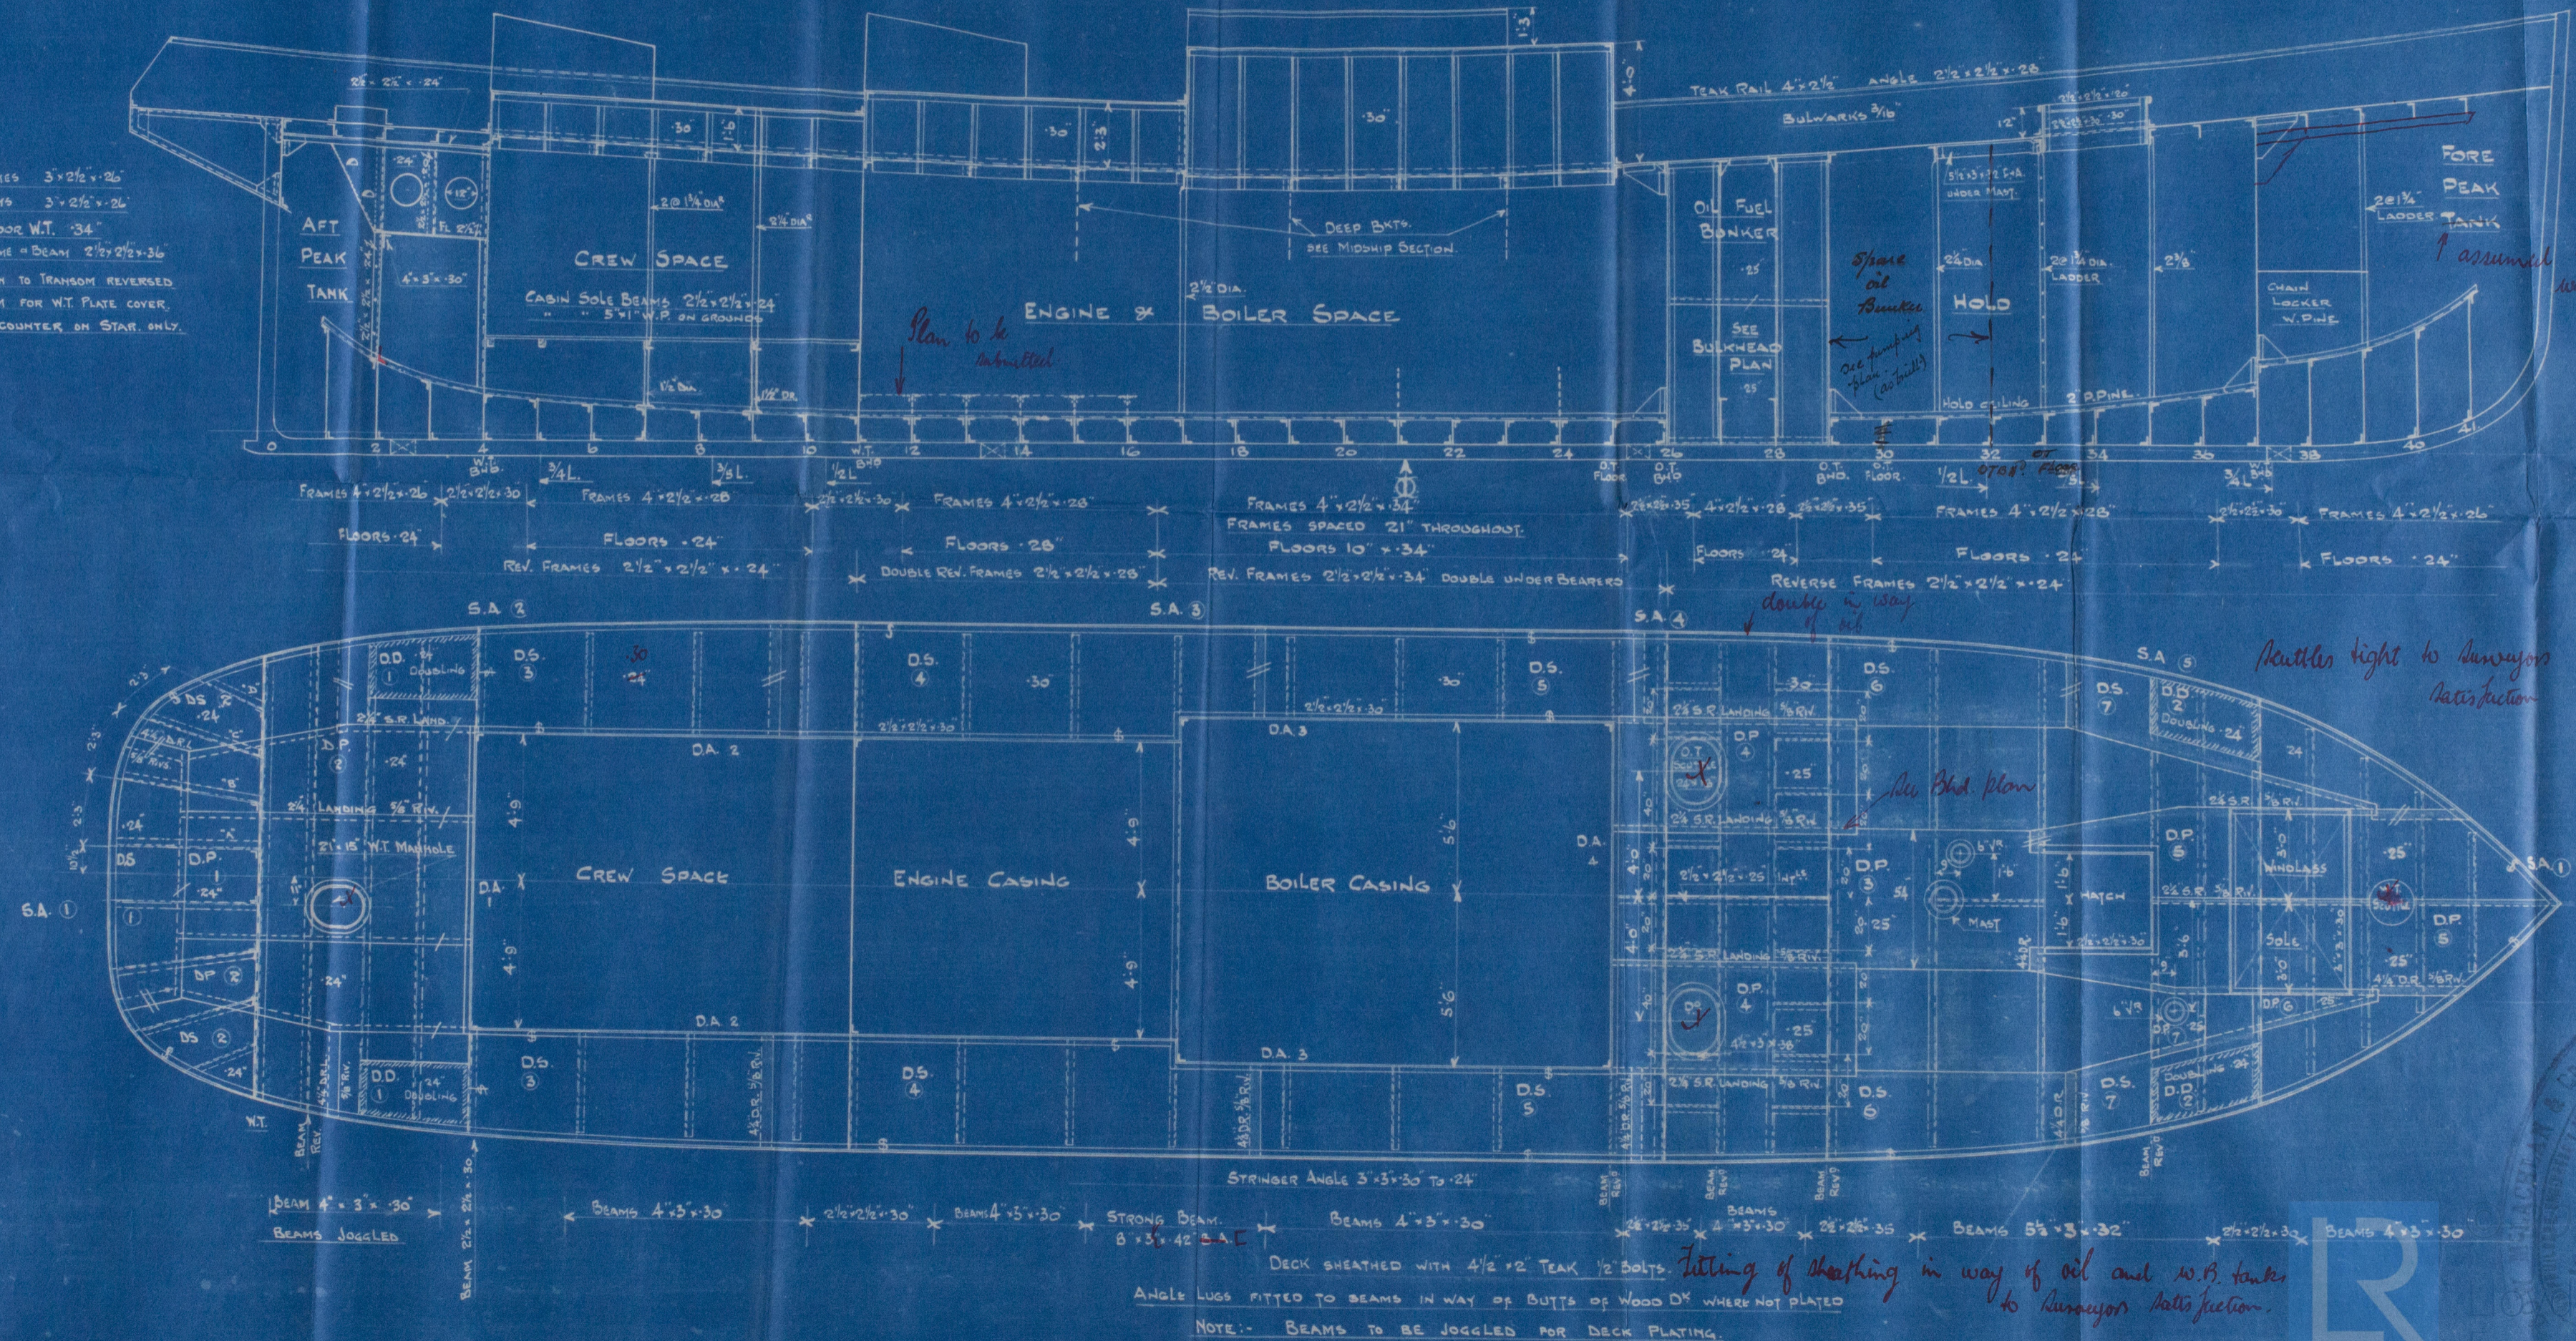

W1257-0146

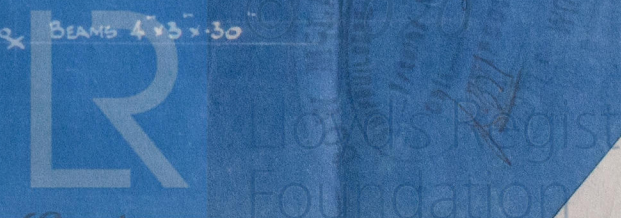

BOW McLACHLAN & CO.  
PROFILE & DECK PLAN  
No. 438  
"KERALA"

GLASGOW REPORT No 45170

© 2020

Lloyd's Register  
Foundation

W1257-0146