

22.11.06
7.12.06
13.12.06

HEILWA
20128 N° 3 3 110


See special sketch of
bridge and strengthening.

S.S. N° 459 & 460.

LENGTH B.P. 378.0
RULE LENGTH 376.0
BREADTH MLD. 51.11 1/2
DEPTH MLD. 27.0
RULE DEPTH 28.0 1/2

AMENDED PLAN.

See special sketch of strengthening
at bridge ends.

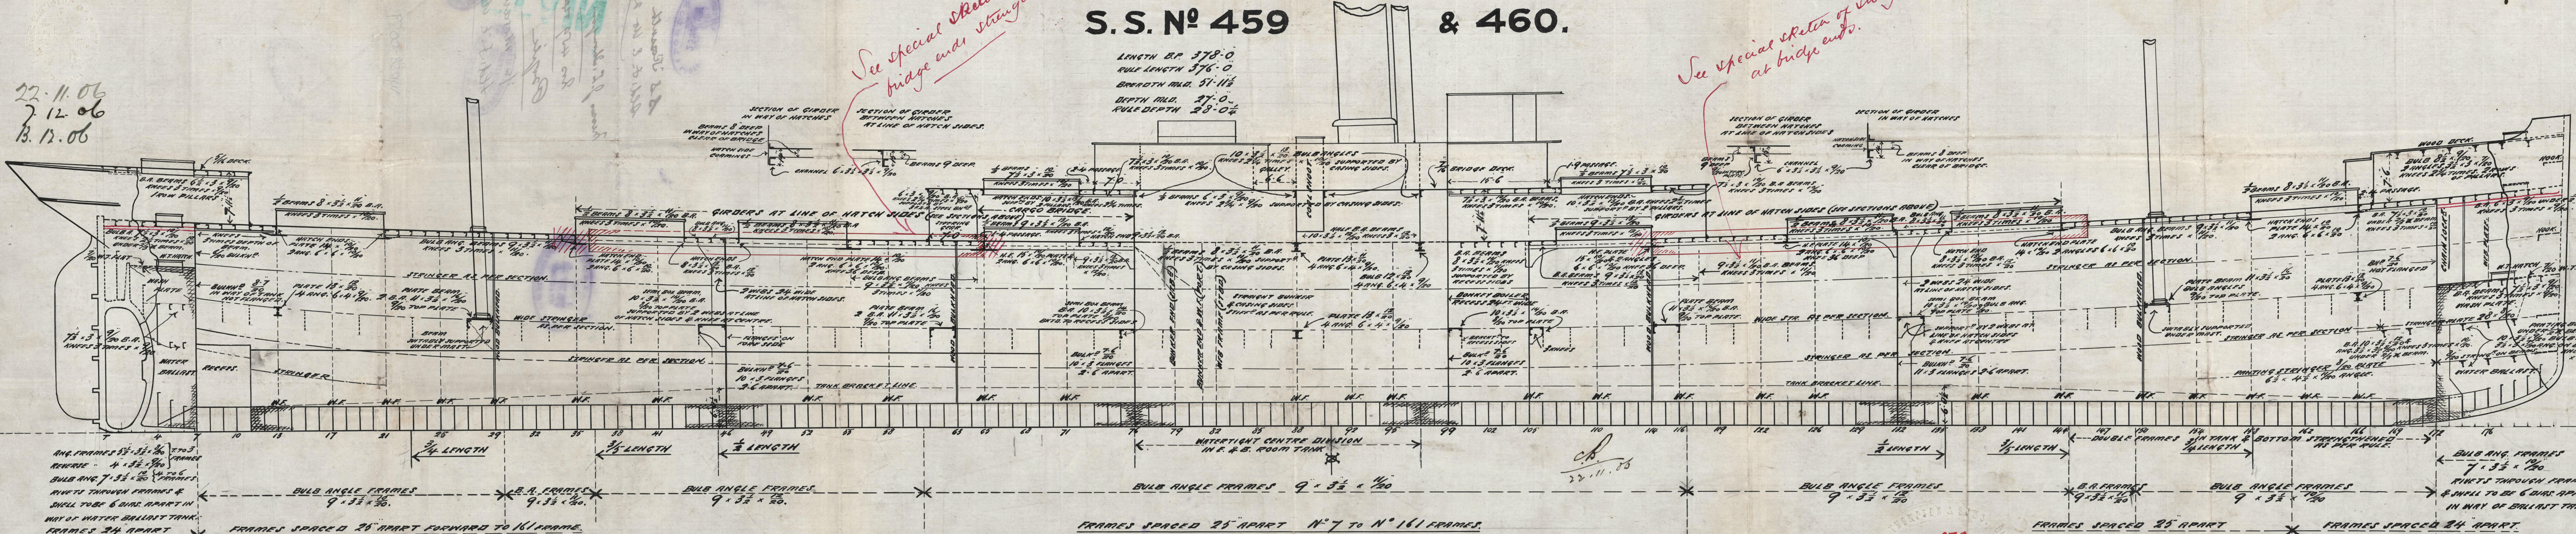

ANG. FRAMES 5 1/2 x 3 1/2 x 1/20
REVERSE 4 1/2 x 3 1/2 x 1/20
BULB ANG. 7 1/2 x 3 1/2 x 1/20
RIVETS THROUGH FRAMES &
SHELL TO BE 6 INCHES APART IN
WAY OF WATER BALLAST TANK.
FRAMES 24 APART

FRAMES SPACED 25 APART FORWARD TO 161 FRAME.

BULB ANGLE FRAMES 9 x 3 1/2 x 1/20

B.A. FRAMES 9 x 3 1/2 x 1/20

BULB ANGLE FRAMES 9 x 3 1/2 x 1/20

BULB ANGLE FRAMES 9 x 3 1/2 x 1/20

BULB ANGLE FRAMES 9 x 3 1/2 x 1/20

B.A. FRAMES 9 x 3 1/2 x 1/20

BULB ANGLE FRAMES 9 x 3 1/2 x 1/20

FRAMES SPACED 25 APART N° 7 TO N° 161 FRAMES.

FRAMES SPACED 25 APART

FRAMES SPACED 24 APART

3870
459460
21.11.06



S.S. "Rosuth Ferencz"
Ald. F. E. No 25505



Mrs. J. L. Thompson & Co
No 459 7460

Proje

Is "Morawitz"
Ald. F. E. No 25355



© 2020
Lloyd's Register
Foundation

W258-0059