


ARRANGEMENT OF DECK PLATING

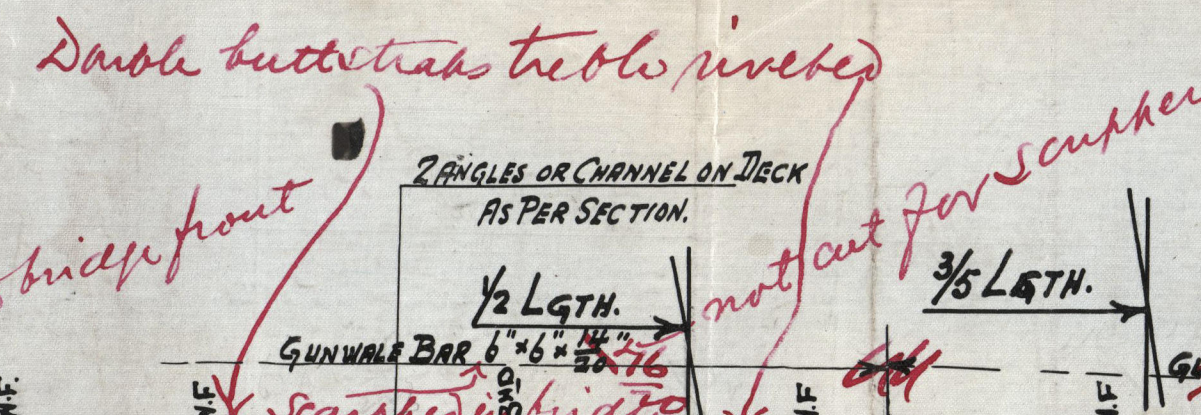

See plans annexed 6/12/08
in way of ends of bridge.

3872
459-460
21.11.06.
Lloyd's Register
Foundation
W1258-0060

Mrs J.L. Thompson Lms

459 1460


ss "Gossuth Terrace"
sld. F. & No 23505

Dear Plm


ss "Morawitz"

sld. F. & No 23558


Committed

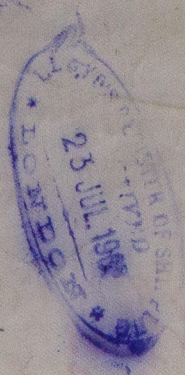

0900-8500

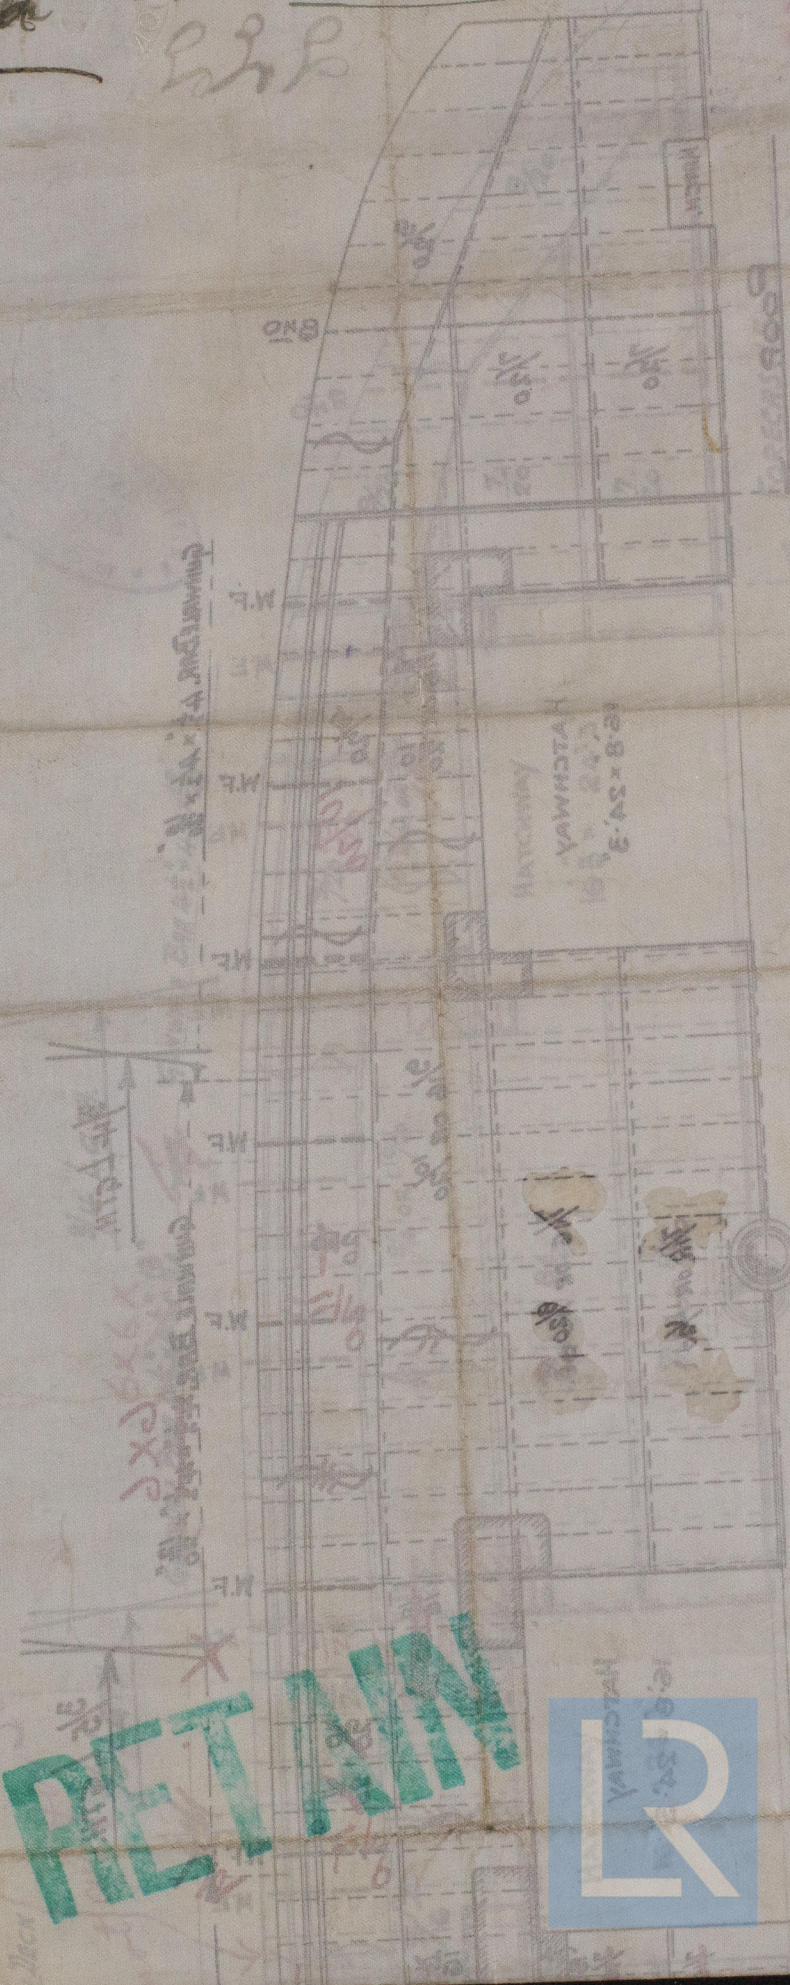

RETAIN

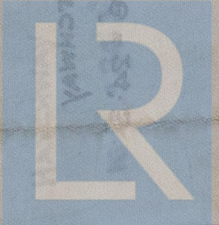

© 2020

Lloyd's Register Foundation