

5a.

# REPORT ON BOILERS.

No. 41602

27 OCT 1933

Received at London Office

Writing Report 24/10/33 When handed in at Local Office 24/10/33 Port of Oslo

Survey held at of pressboilers at Larvik Date, First Survey 13/1/31 Last Survey 22/1/31

on the Ss. "SVEND FOYN" (Number of Visits 3) Tons {Gross 14596 Net 8032

Built at Haaverton By whom built Furness S.B. Co. C. Yard No. When built 1931

made at Harlepool By whom made Richardson, Woodgate & Co. L. Engine No. When made 1931

made at Larvik By whom made Alf. Andersen Nordstad Boiler No. When made 1931

Horse Power Owners St. Helin Shipowner Co. Port belonging to London.

## Press boilers

### TITUBULAR BOILERS—MAIN, AUXILIARY, OR DONKEY.

Manufacturers of Steel approved marks. (Letter for Record)

Heating Surface of Boilers Is forced draught fitted Coal or Oil fired

Description of Boilers 15 press boilers Working Pressure 60 lb.

by hydraulic pressure to 120 lb. Date of test 13/1/31 No. of Certificate Can each boiler be worked separately

Firegrate in each Boiler No. and Description of safety valves to each boiler

of each set of valves per boiler {per Rule as fitted Pressure to which they are adjusted Are they fitted with easing gear

of donkey boilers, state whether steam from main boilers can enter the donkey boiler

Manuf distance between boilers or uptakes and bunkers or woodwork Is oil fuel carried in the double bottom under boilers

st distance between shell of boiler and tank top plating Is the bottom of the boiler insulated

internal dia. of boilers 9'-0 1/4" Length 12'-9" Shell plates: Material S.M. steel Tensile strength 28-35

Are the shell plates welded or flanged and fl. flanged Description of riveting: circ. seams {end single riveted inter. 50 mm. 67 mm.}

ams double riveted lap Diameter of rivet holes in {circ. seams 15/16 long. seams 15/16} Pitch of rivets {plate 56 rivets 65}

Percentage of strength of circ. intermediate seam {plate rivets} Working pressure of shell by Rules 67

age of strength of longitudinal joint {plate 66 rivets 66 combined} Working pressure of shell by Rules 67

age of butt straps {outer inner} No. and Description of Furnaces in each Boiler

Tensile strength Smallest outside diameter

of plain part {top bottom} Thickness of plates {crown bottom} Description of longitudinal joint

sions of stiffening rings on furnace or c.c. bottom Working pressure of furnace by Rules

plates in steam space: Material S.M. steel Tensile strength 26-30 Thickness top 21.5 mm. bottom 18.5 mm. Pitch of stays

are stays secured Working pressure by Rules

plates: Material {front back} Tensile strength Thickness

pitch of stay tubes in nests Pitch across wide water spaces Working pressure {front back}

s to combustion chamber tops: Material Tensile strength Depth and thickness of girder

Length as per Rule Distance apart No. and pitch of stays

Working pressure by Rules Combustion chamber plates: Material

Thickness: Sides Back Top Bottom

of stays to ditto: Sides Back Top Are stays fitted with nuts or riveted over

Working pressure by Rules Front plate at bottom: Material Tensile strength

Lower back plate: Material Tensile strength Thickness


of stays at wide water space Are stays fitted with nuts or riveted over

Working Pressure Main stays: Material Tensile strength

At body of stay, or Over threads No. of threads per inch Area supported by each stay

Working pressure by Rules Screw stays: Material Tensile strength

At turned off part, or Over threads No. of threads per inch Area supported by each stay

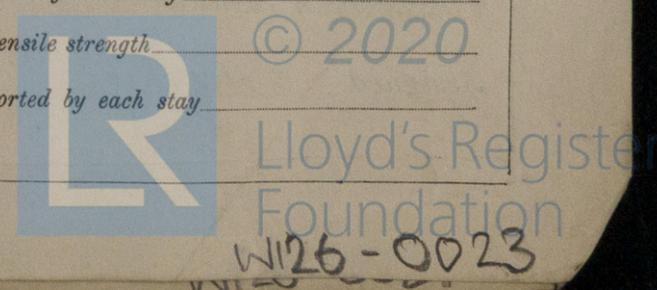

Working pressure by Rules \_\_\_\_\_ Are the stays drilled at the outer ends \_\_\_\_\_ Margin stays: Diameter { At turned off part, or Over threads \_\_\_\_\_

No. of threads per inch \_\_\_\_\_ Area supported by each stay \_\_\_\_\_ Working pressure by Rules \_\_\_\_\_

Tubes: Material \_\_\_\_\_ External diameter { Plain \_\_\_\_\_ Stay \_\_\_\_\_ Thickness { \_\_\_\_\_ No. of threads per inch \_\_\_\_\_

Pitch of tubes \_\_\_\_\_ Working pressure by Rules \_\_\_\_\_ Manhole compensation: Size of shell plate \_\_\_\_\_ Section of compensating ring \_\_\_\_\_ No. of rivets and diameter of rivet holes \_\_\_\_\_

Outer row rivet pitch at ends \_\_\_\_\_ Depth of flange if manhole flanged \_\_\_\_\_ Steam Dome: Material \_\_\_\_\_

Tensile strength \_\_\_\_\_ Thickness of shell \_\_\_\_\_ Description of longitudinal joint \_\_\_\_\_

Diameter of rivet holes \_\_\_\_\_ Pitch of rivets \_\_\_\_\_ Percentage of strength of joint { Plate \_\_\_\_\_ Rivets \_\_\_\_\_

Internal diameter \_\_\_\_\_ Working pressure by Rules \_\_\_\_\_ Thickness of crown \_\_\_\_\_ No. and dia stays \_\_\_\_\_ Inner radius of crown \_\_\_\_\_ Working pressure by Rules \_\_\_\_\_

How connected to shell \_\_\_\_\_ Size of doubling plate under dome \_\_\_\_\_ Diameter of rivet holes of rivets in outer row in dome connection to shell \_\_\_\_\_

Type of Superheater \_\_\_\_\_ Manufacturers of { Tubes \_\_\_\_\_ Steel castings \_\_\_\_\_

Number of elements \_\_\_\_\_ Material of tubes \_\_\_\_\_ Internal diameter and thickness of tubes \_\_\_\_\_

Material of headers \_\_\_\_\_ Tensile strength \_\_\_\_\_ Thickness \_\_\_\_\_ Can the superheater be shut the boiler be worked separately \_\_\_\_\_ Is a safety valve fitted to every part of the superheater which can be shut off from the boiler \_\_\_\_\_

Area of each safety valve \_\_\_\_\_ Are the safety valves fitted with easing gear \_\_\_\_\_ Working pressure Rules \_\_\_\_\_ Pressure to which the safety valves are adjusted \_\_\_\_\_ Hydraulic test tubes \_\_\_\_\_, castings \_\_\_\_\_ and after assembly in place \_\_\_\_\_ Are drain cocks or valves to free the superheater from water where necessary \_\_\_\_\_

Have all the requirements of Sections 14 to 22 inclusive for boilers been complied with \_\_\_\_\_

The foregoing is a correct description, \_\_\_\_\_

Dates of Survey { During progress of work in shops - - } 13/1, 16/1, 24/1, 1934 \_\_\_\_\_ Are the approved plans of boiler and superheater forwarded herewith (If not state date of approval.) \_\_\_\_\_

while building { During erection on board vessel - - - } \_\_\_\_\_ Total No. of visits 3 \_\_\_\_\_


Is this Boiler a duplicate of a previous case \_\_\_\_\_ If so, state Vessel's name and Report No. \_\_\_\_\_

**GENERAL REMARKS** (State quality of workmanship, opinions as to class, &c.)

These boilers examined during construction and tested by hydraulic pressure to 120 lbs. per sq. inch and found in order. The workmanship found good.

The boilers makes:

3 off:	12 off.
Clyde test	Clyde test
120 lbs.	120 lbs.
W. P. 60 lbs.	W. P. 60 lbs.
13.1.31. P.E.	22.1.31. P.E.

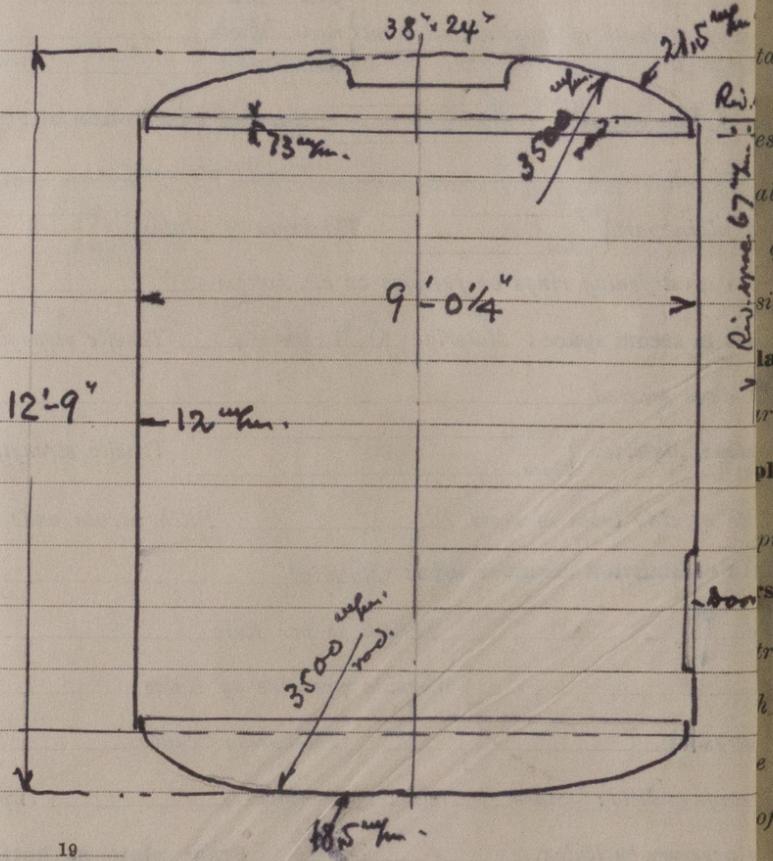

Survey Fee	... .. £	:	:	When applied for,	19
Travelling Expenses (if any)	£	:	:	When received,	19

*Guidé Ferguson-Robert*  
 Engineer Surveyor to Lloyd's Register of Shipping

Committee's Minute **TUE. 12 DEC 1939**

Assigned *See Vol. 4160*