

LONGITUDINAL AND DECK PLANS

S. S. N° 712




DIMENSIONS 385' 0" B.P. x 51' 9" M² - 52' 0" EXT. x 29' 0" M²
TO CLASS 100 A.I. AT LLOYD'S SPECIAL SURVEY
SCALE 3/4" INCH = ONE FOOT

SCANTLING OF HART DETERMINED ON LENGTH
FORE & MAIN MASTS 3-PARTS IN ROUND
BUTTS LAPPED 3" ABOVE DECK
3" AIR BELOW
SEAMS LAPPED & SINGLE RIVETED

SHEER FORWARD	120'
1st	60'





THE SCANTLING & DETAILS OF CONSTRUCTION NOTED HEREON ARE SUBMITTED ON THE UNDERSTANDING THAT THEY ARE THE MINIMUM WHICH WILL BE ACCEPTED FOR CLASS, AND IF NOT THEY ARE TO BE AMENDED ERRORS & OMISSIONS EXCEPTED

DETAILED PLAN OF HATCHWAYS TO BE SUBMITTED

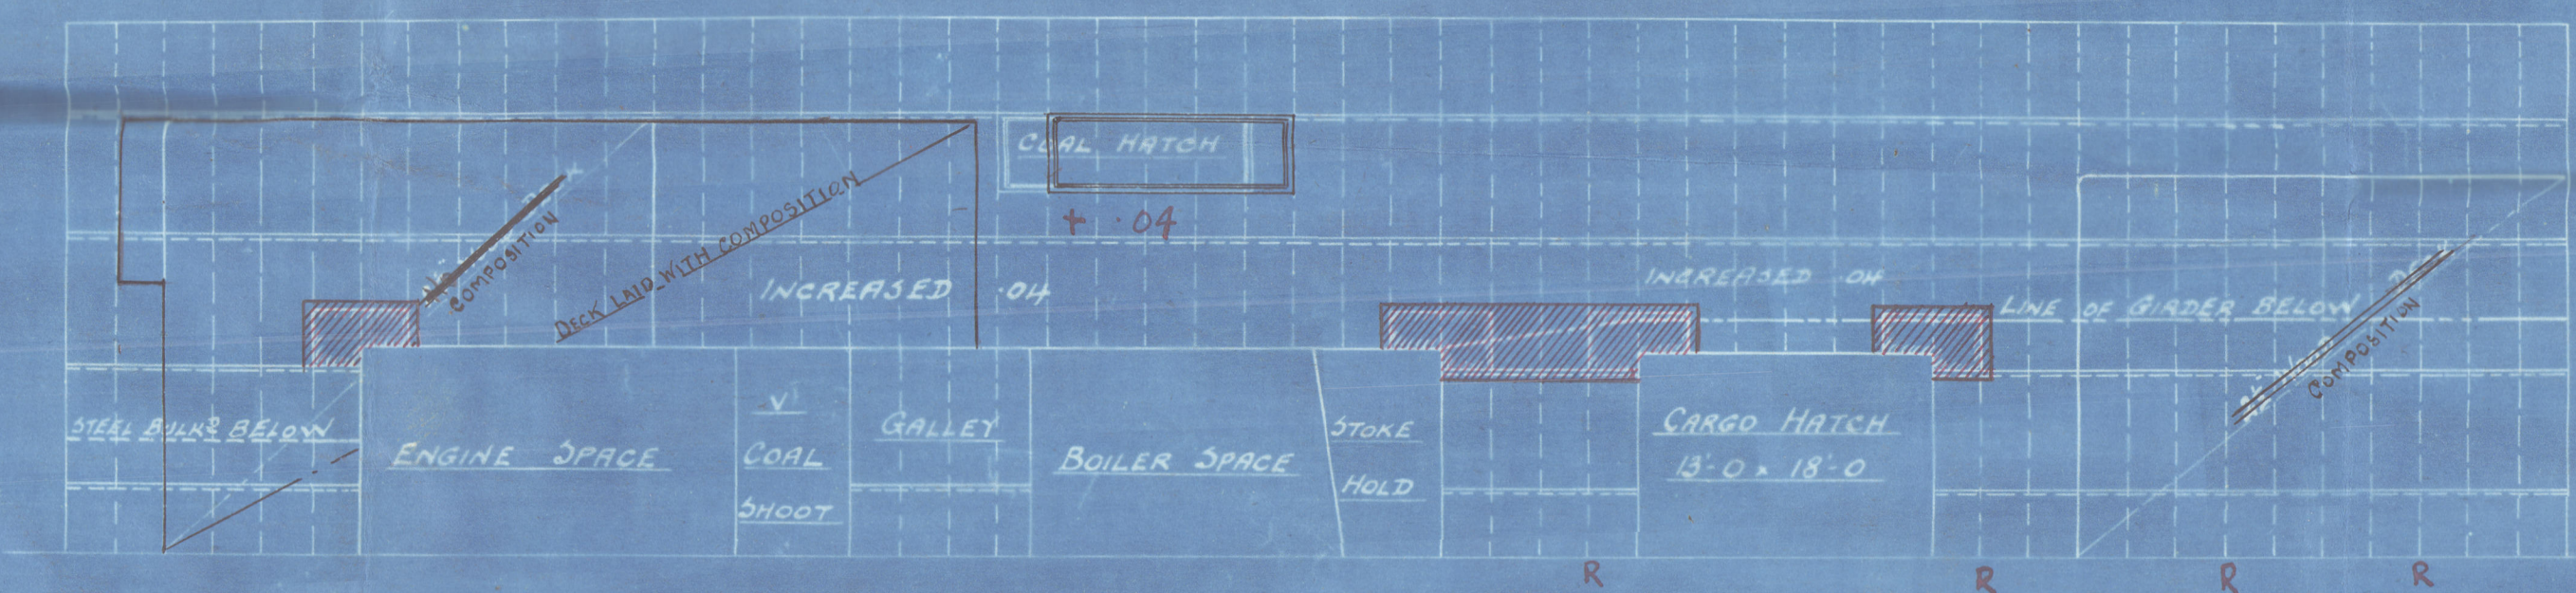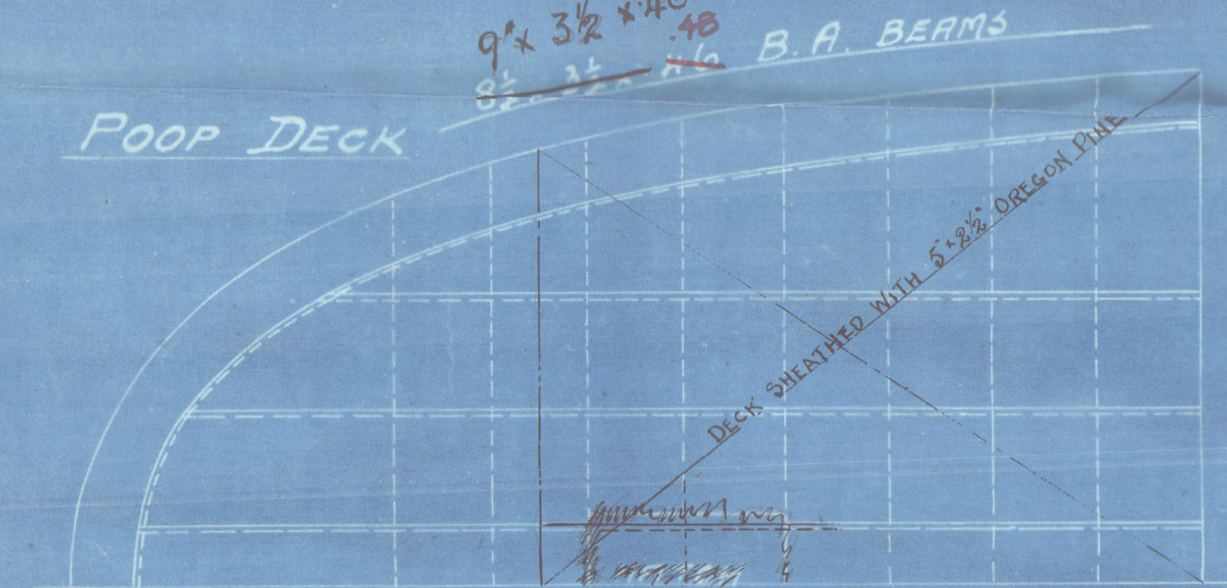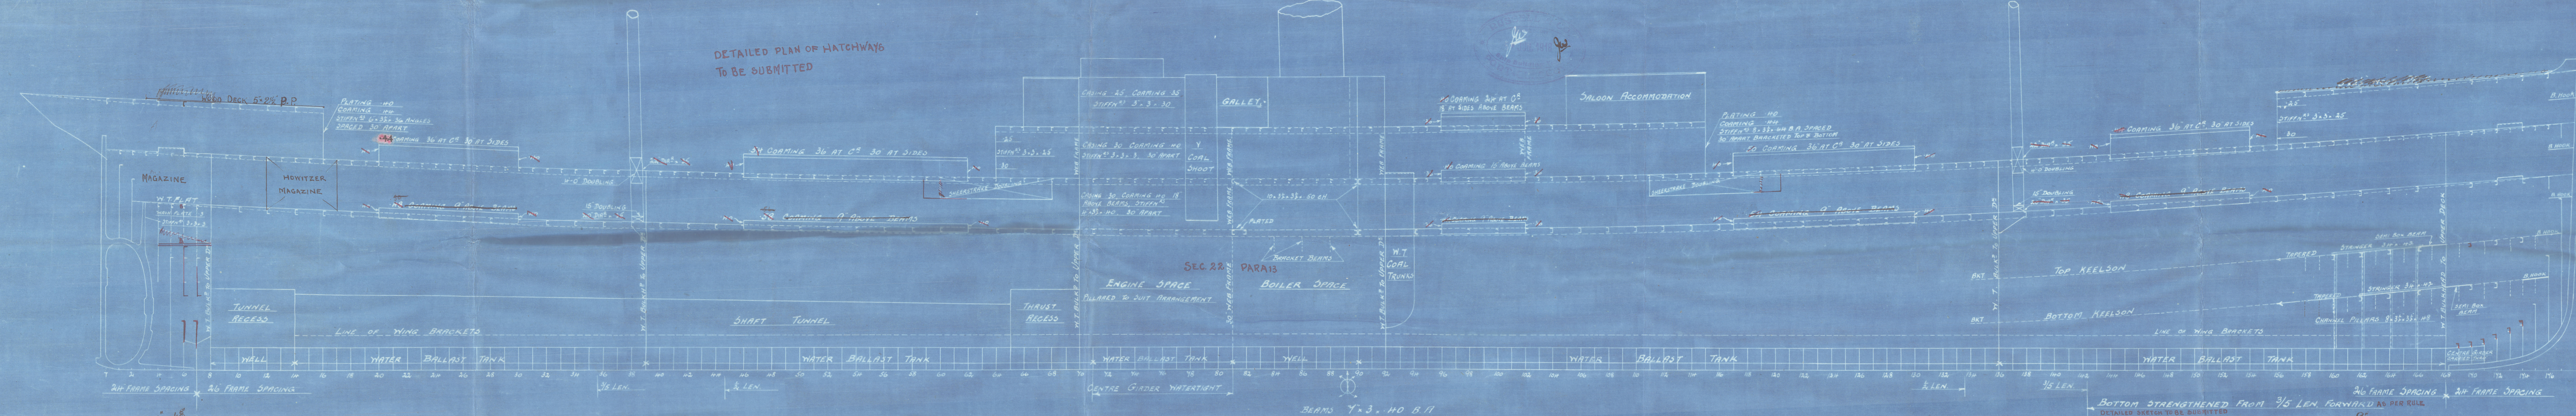



BRIDGE DECK

NOTE:-- OWING TO GIRDERS BEING 10' 0" APART, AND LEAVING WIDE SPAN AT CENTRE. REVERSE BEAMS TO BE FITTED WHERE MARKED R, OR THROUGH BEAM CLEAR OF HATCHWAYS BETWEEN THE GIRDERS THOSE FITTED TO UPPER 6" BRIDGE DECK BEAMS 6" 0" x 56" AND THOSE TO THE 2ND DECK BEAMS 4" 0" x 50" SEE LLOYD'S LETTER 157-15

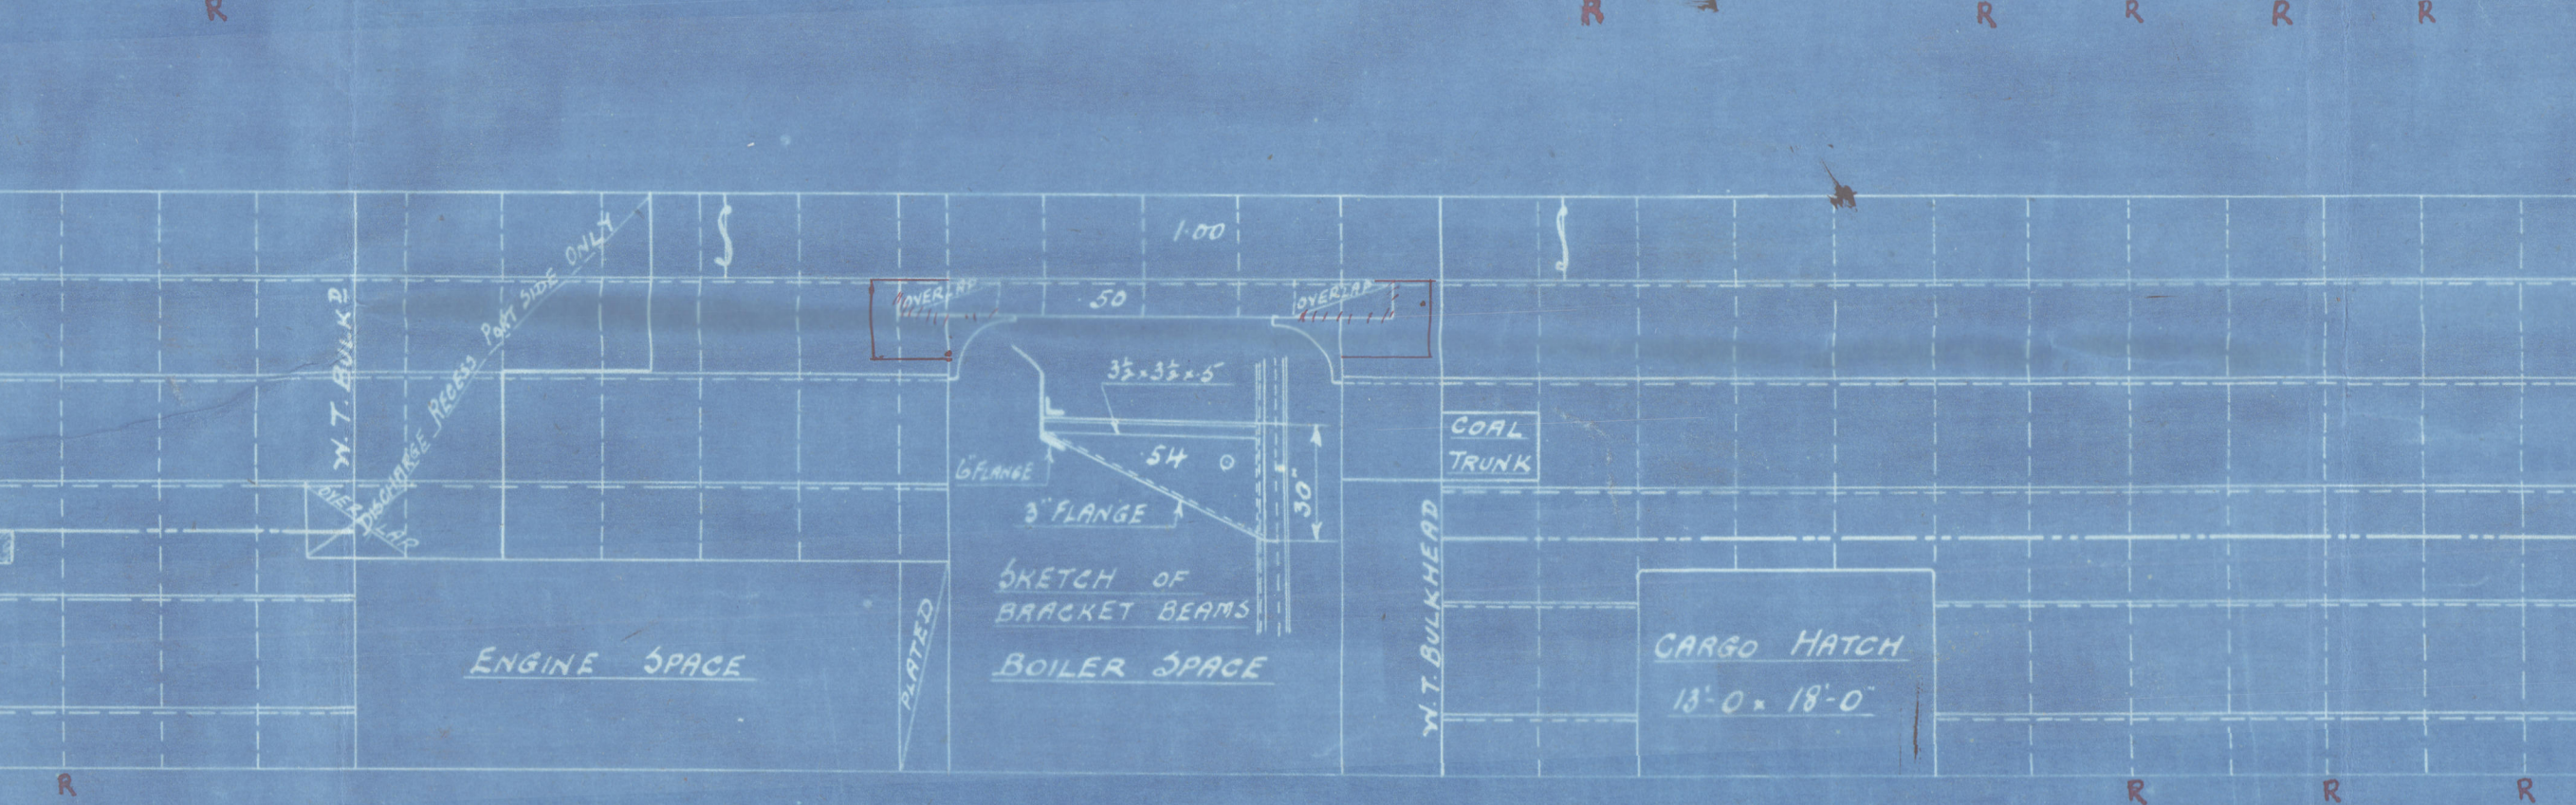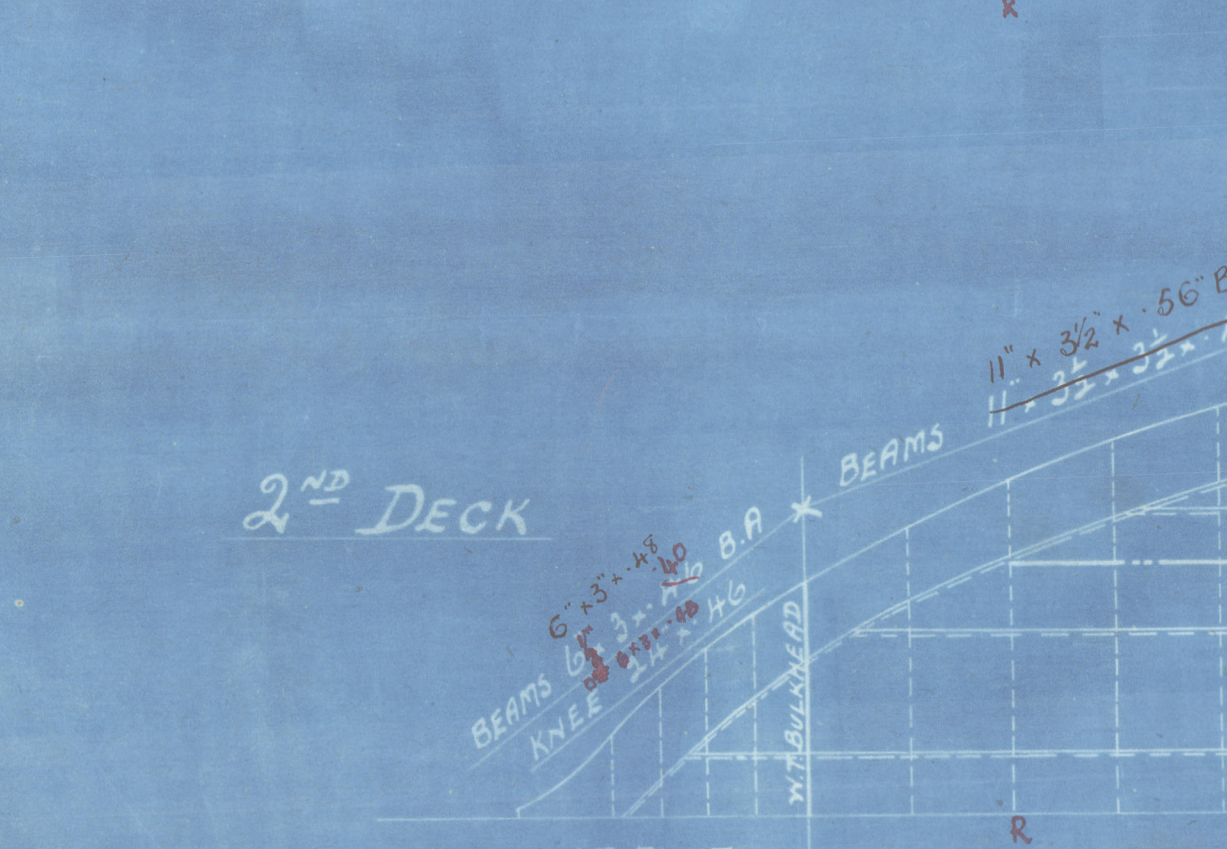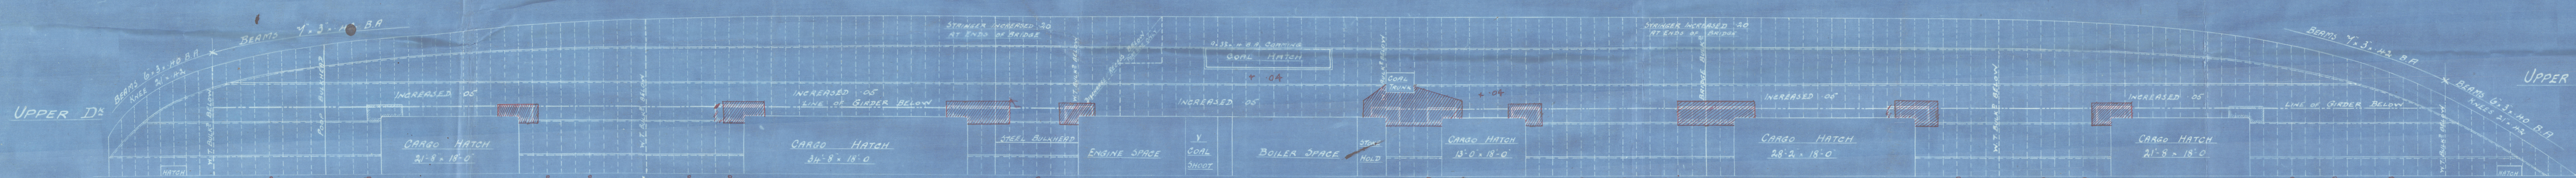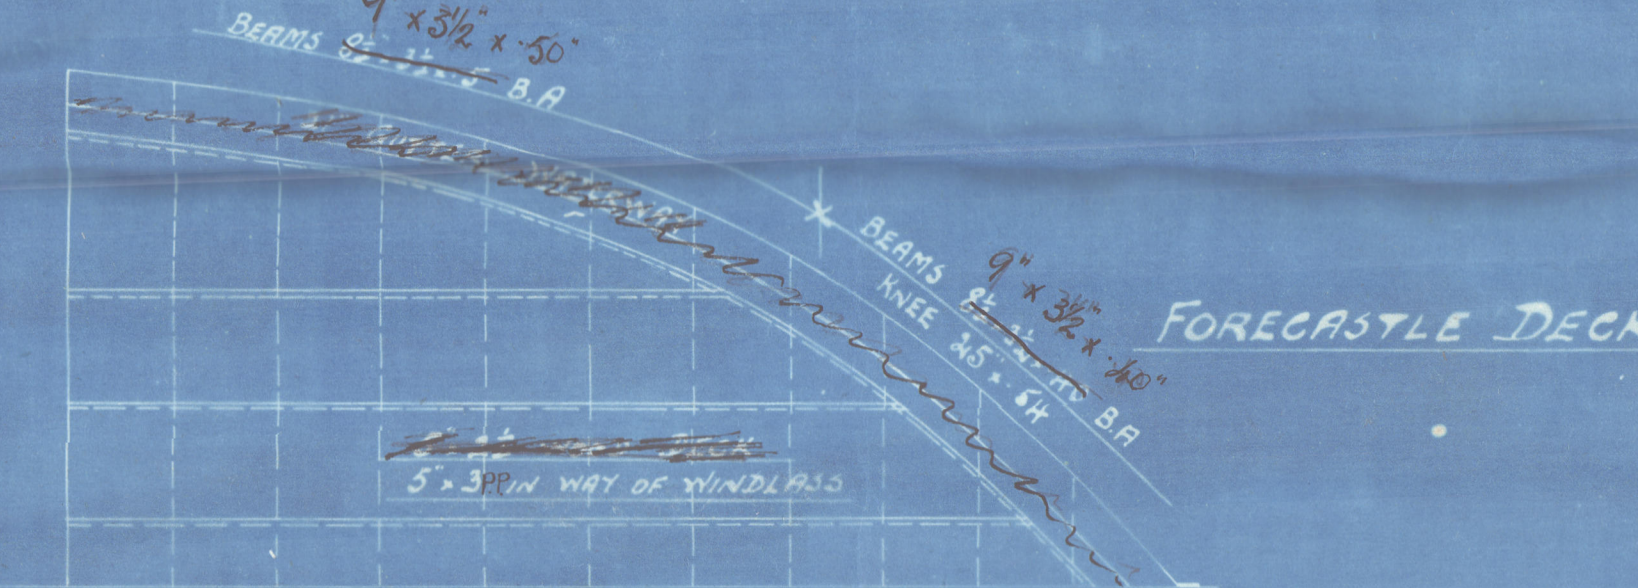

BRIDGE DECK

NOTE:-- OWING TO GIRDERS BEING 10' 0" APART, AND LEAVING WIDE SPAN AT CENTRE. REVERSE BEAMS TO BE FITTED WHERE MARKED R, OR THROUGH BEAM CLEAR OF HATCHWAYS BETWEEN THE GIRDERS THOSE FITTED TO UPPER 6" BRIDGE DECK BEAMS 6" 0" x 56" AND THOSE TO THE 2ND DECK BEAMS 4" 0" x 50" SEE LLOYD'S LETTER 157-15

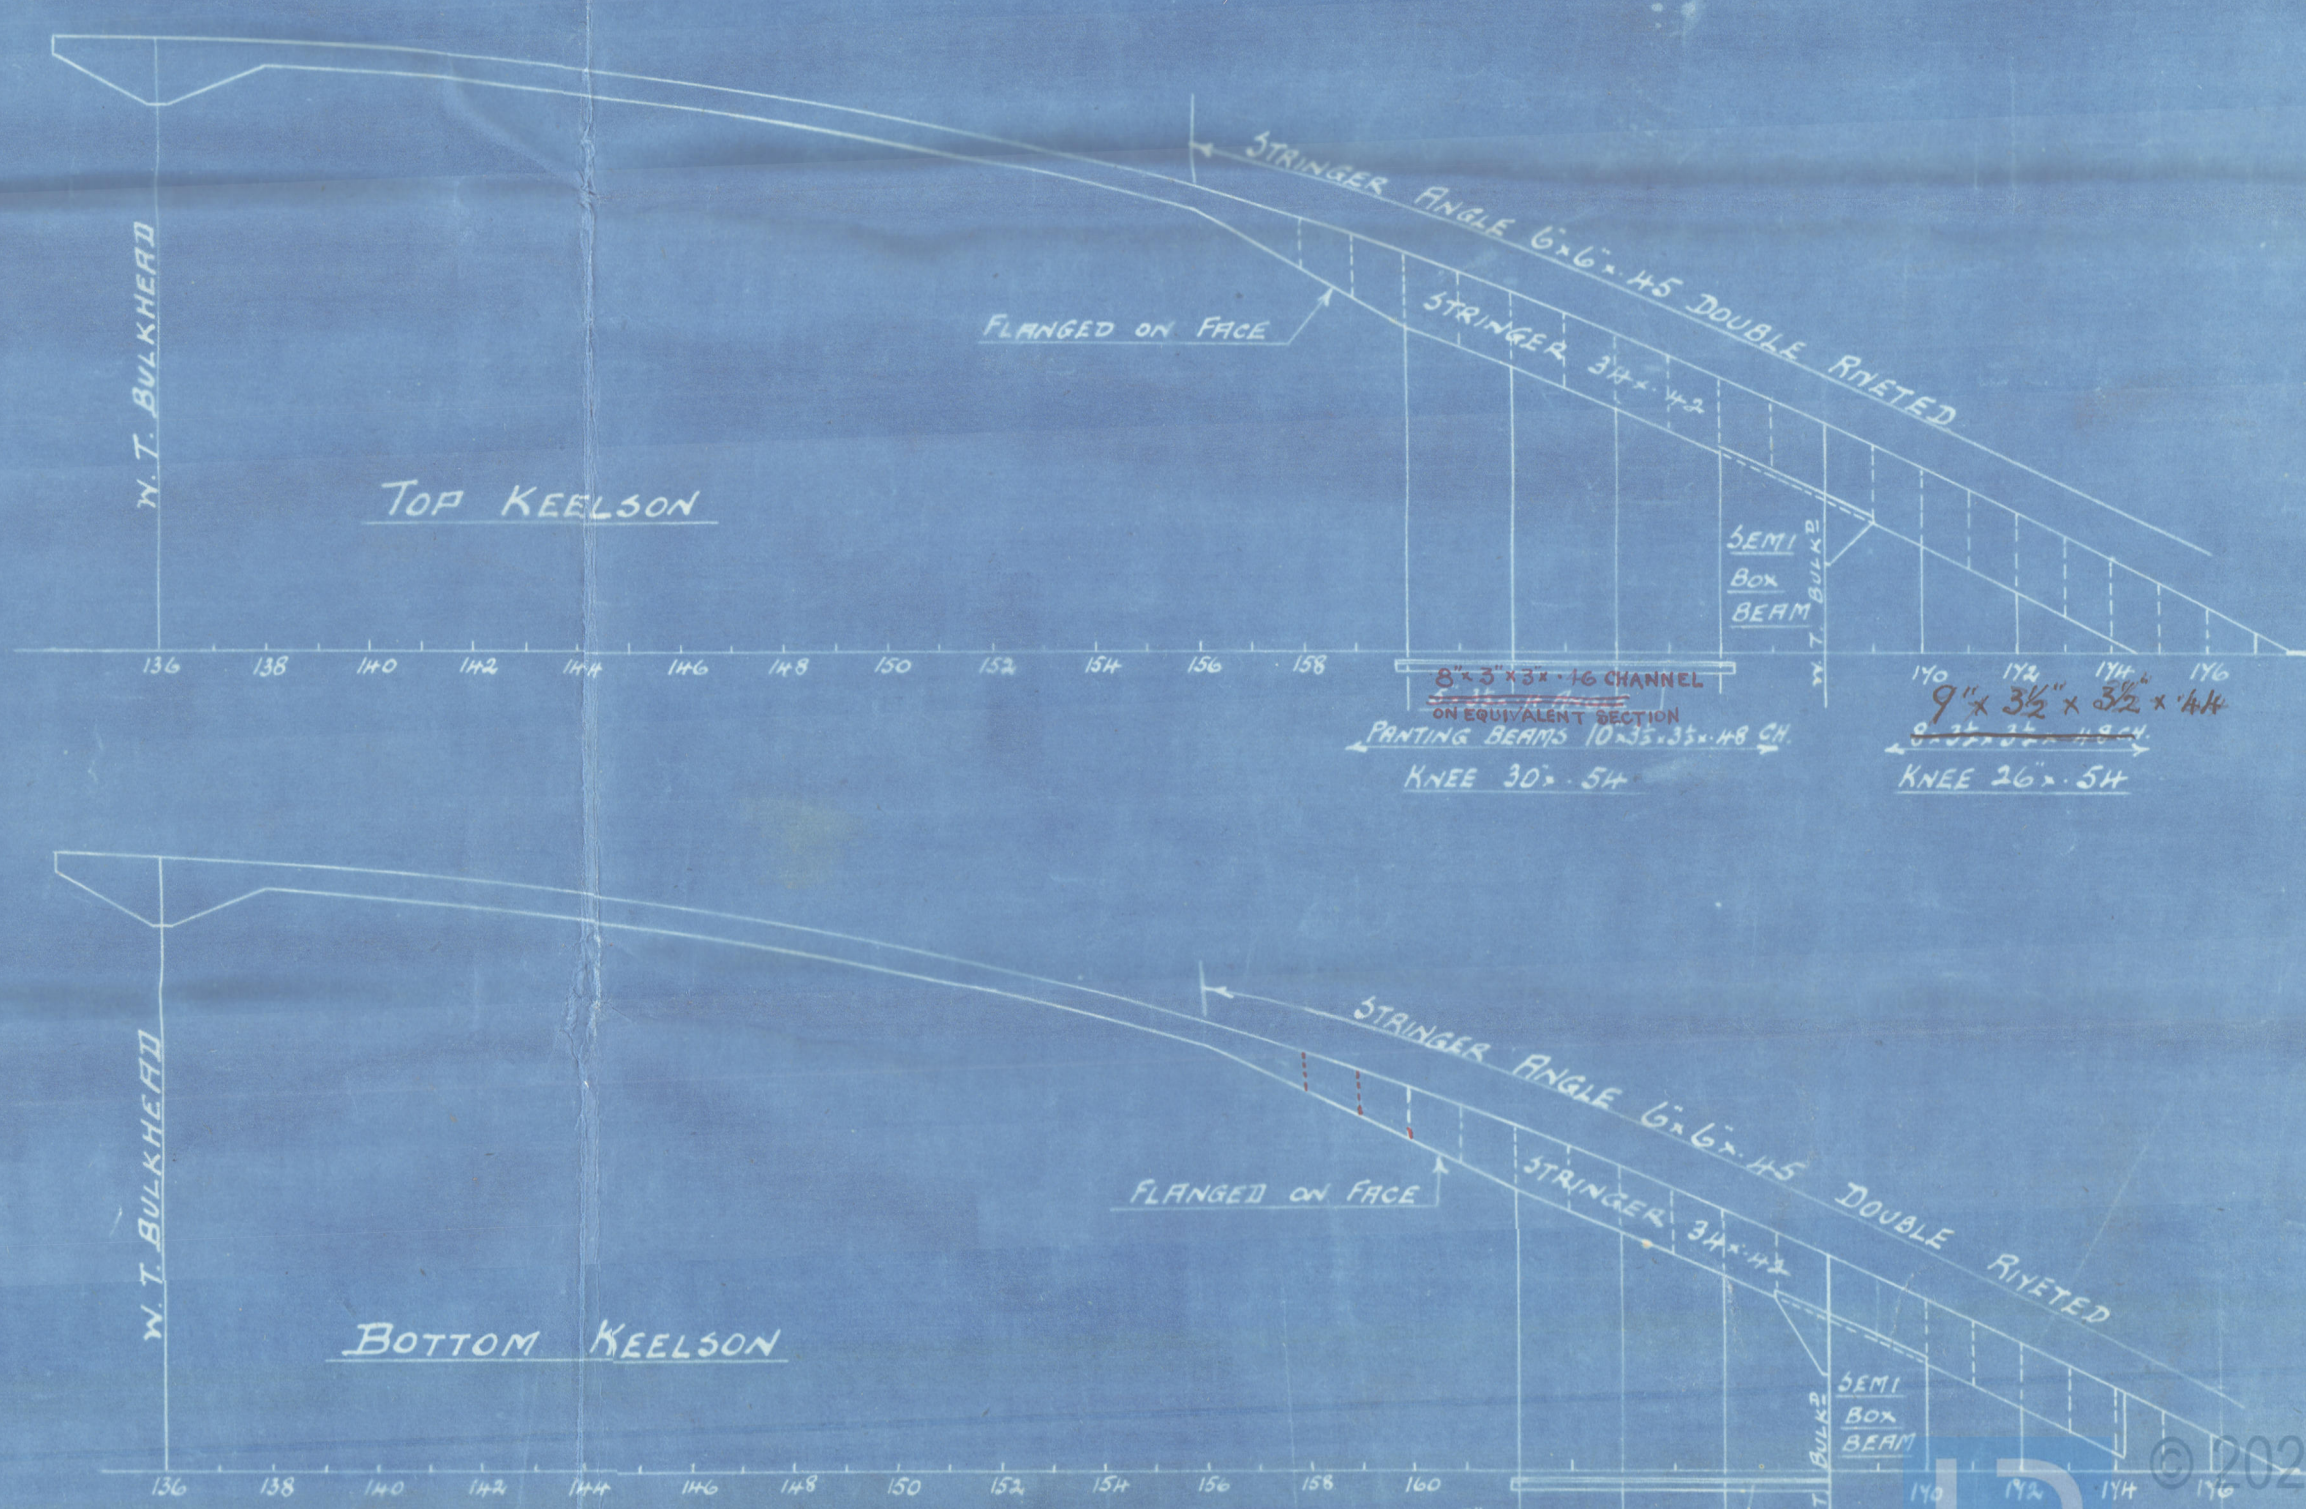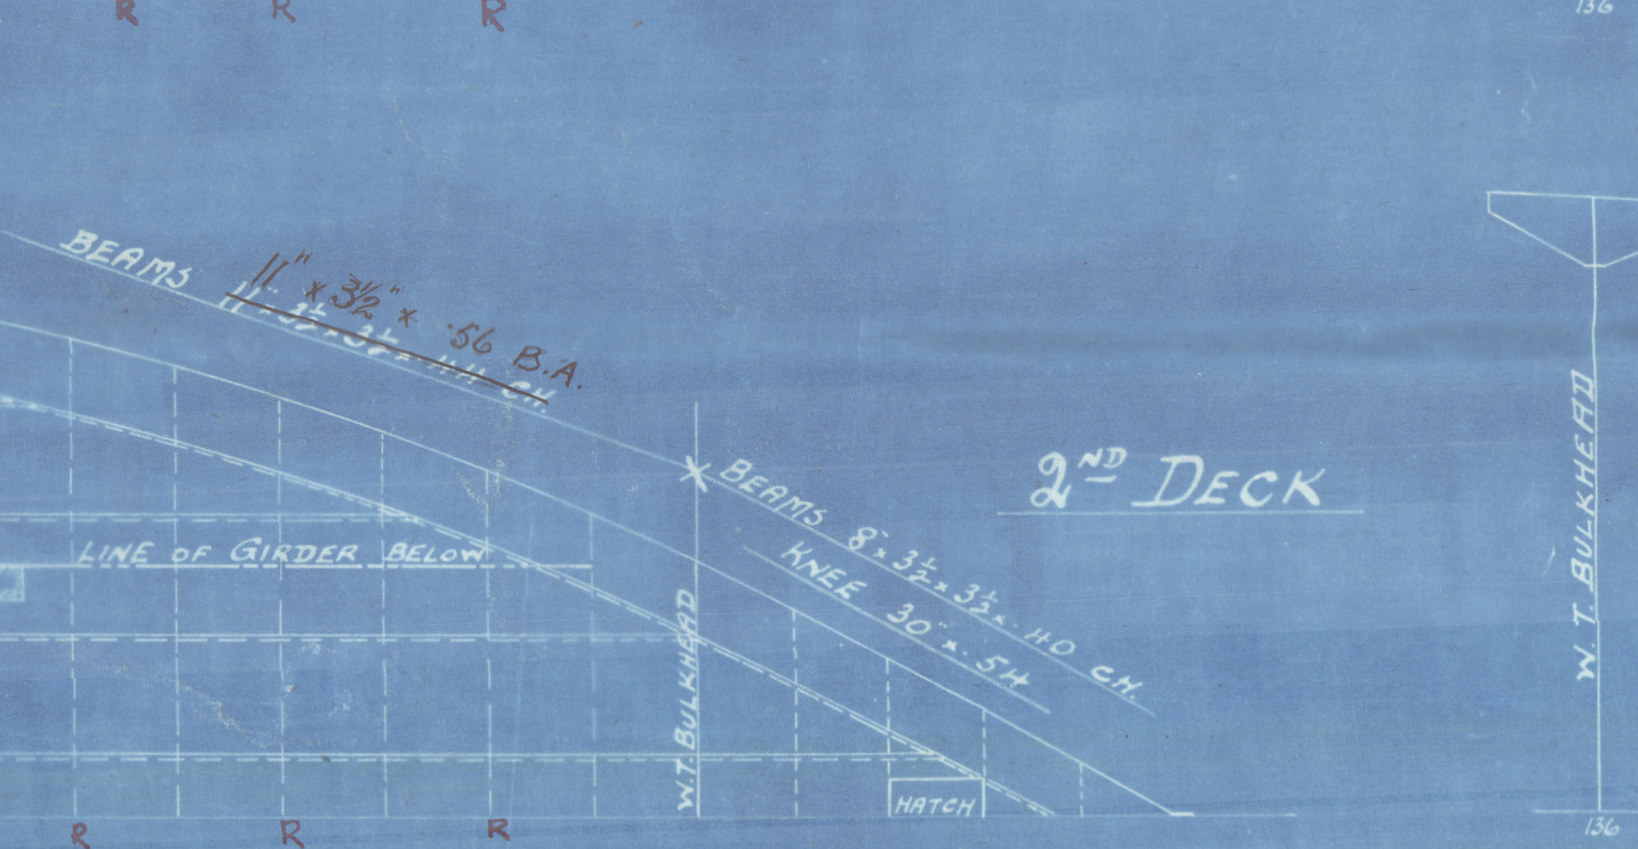

Longitudinal Slane

SS Ardgorm

Russell Co No 712

hhp & Rpt No 17312



© 2021

Lloyd's Register
Foundation

W062-0013