

No 175 CONSTRUCTION PROFILE SCALE $\frac{1}{8}'' = 1'$ (ALTERED PLAN)

ALTERED

ORIGINAL


ORIGINAL

GIRDER AT HEAD OF W & P

PROF	NO	S	D	H	SPACING	DEPTH	WEIGHT	STRESS	REMARKS
1752	104	12	13.5	7.1	52.5	8	17	44	23x24x7
	105	12	13.5	5	17.5	1	1	1	23x24x7
	106	12	13.5	5	52.5	1	1	1	23x24x7
	107	12	13.5	5	52.5	1	1	1	23x24x7
1753	108	12	13.5	5	52.5	1	1	1	23x24x7
	109	12	13.5	5	52.5	1	1	1	23x24x7
	110	12	13.5	5	52.5	1	1	1	23x24x7
	111	12	13.5	5	52.5	1	1	1	23x24x7
1754	112	12	13.5	5	52.5	1	1	1	23x24x7
	113	12	13.5	5	52.5	1	1	1	23x24x7
	114	12	13.5	5	52.5	1	1	1	23x24x7
	115	12	13.5	5	52.5	1	1	1	23x24x7



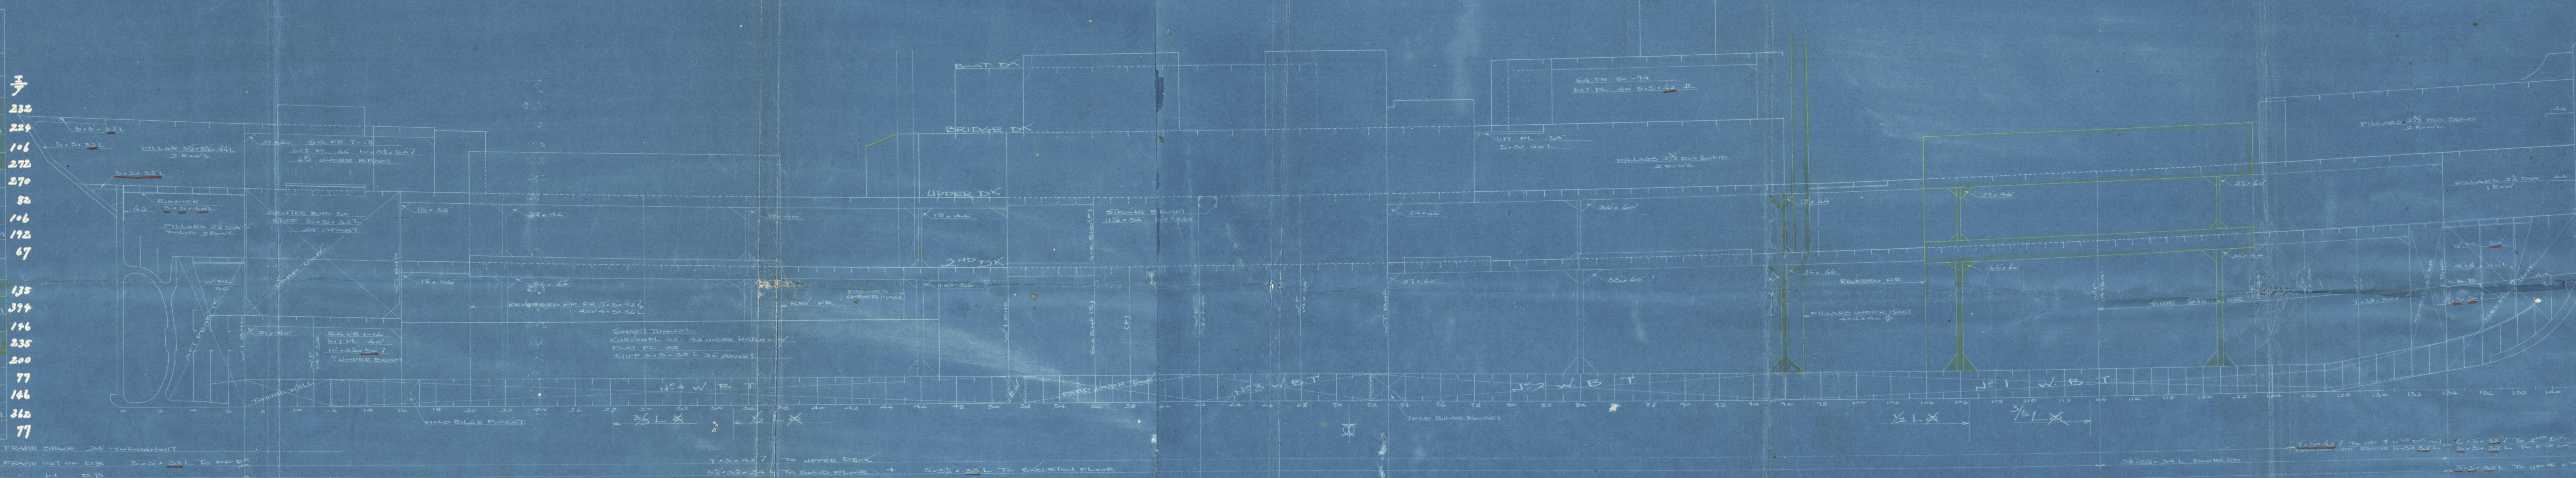







Proposed alterations to Plans and Grades approved as submitted
Yokohama Engineers informed by wire
J.P. 20.

1/5 Lashan Maan
Yka 2455

Ship's Name or No. 175.

Name CONSTRUCTION OF PROFILE.
of
Drawing (Altered Plan)

Drawing No.

Sending No.



RETAIN



© 2020

Lloyd's Register
Foundation

W1265-0087