


20.516


NO 5 Marina Dockyard S. S. CARGO STEAMER. MIDSHIP SECTION.

"TO CLASS LLOYD'S 100A1 ~~WITH FREE BOARD~~"

SCALE: 1/2 INCH TO ONE FOOT.

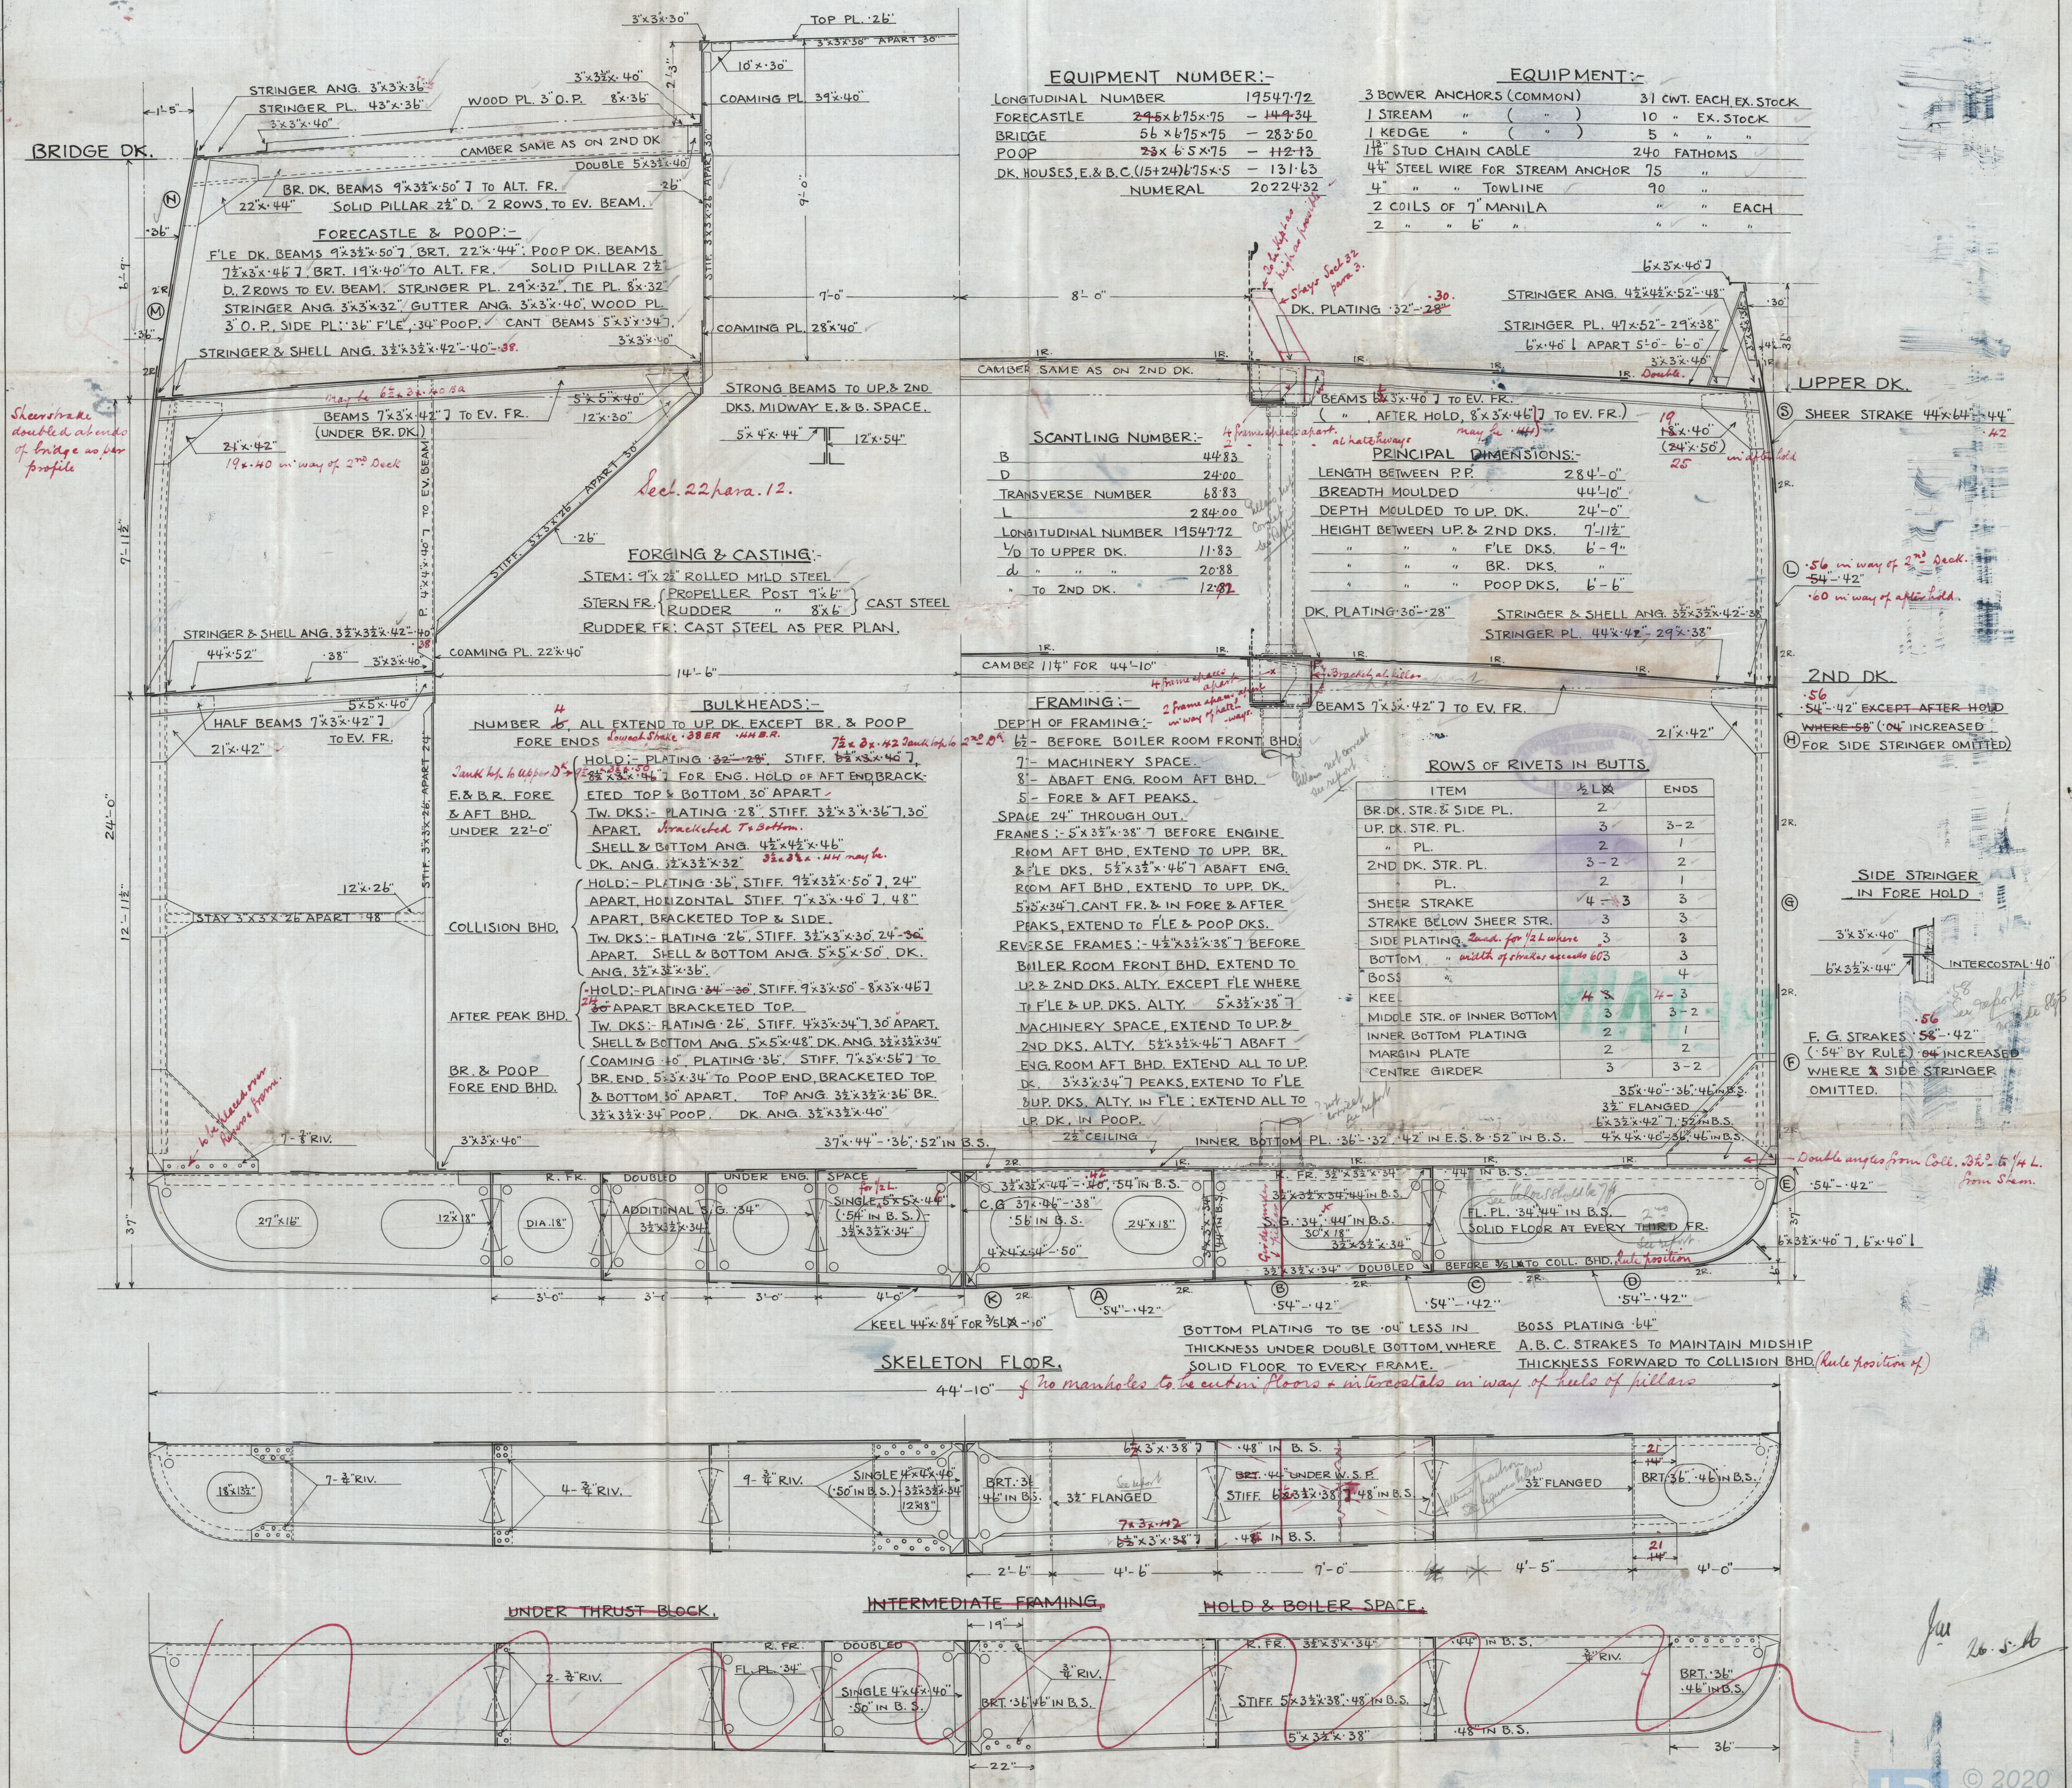

S/S "Tato Maru" Rio N
Kobe Rpt No 2080
Midship Section.

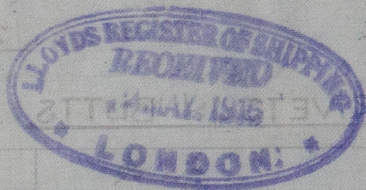

© 2020

Lloyd's Register
Foundation

W1265-0149