
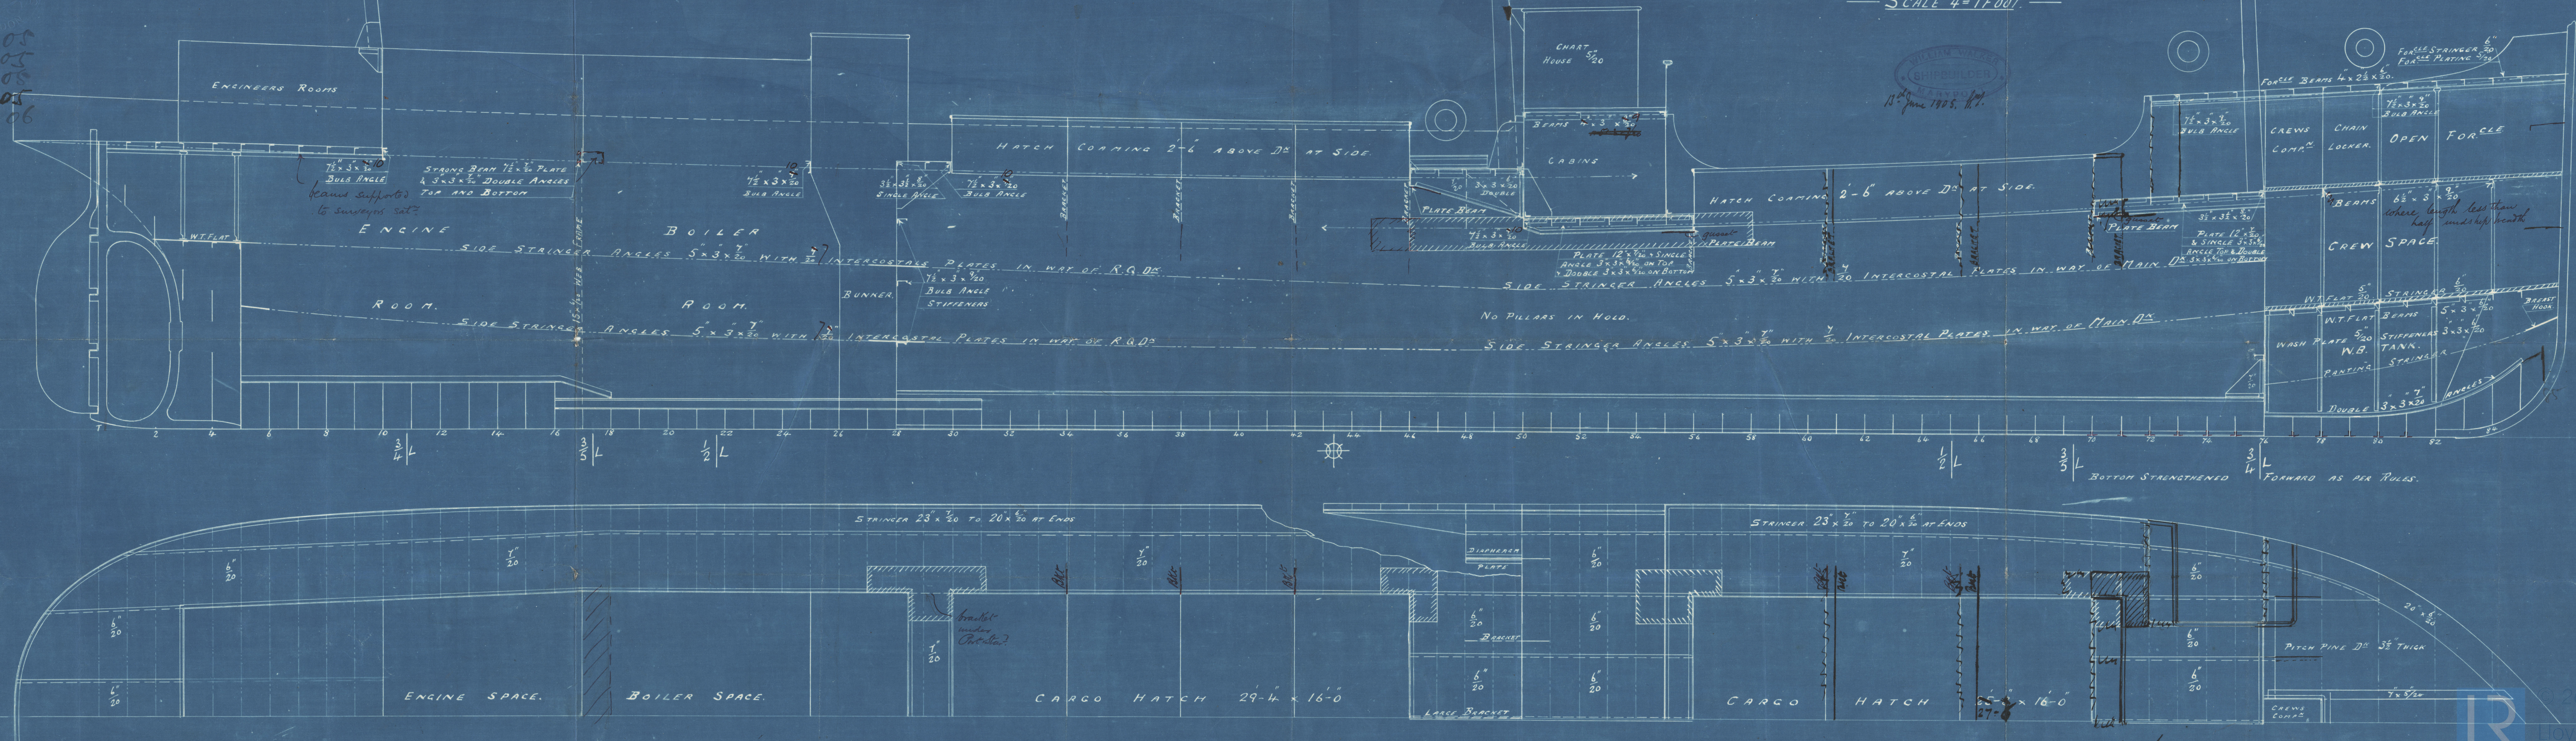




16.6.05
27.6.05
11.9.05
11.12.05
2.2.06

— PRINCIPAL DIMENSIONS —
LENGTH B.P. — 159'-0" 160'-0"
BREADTH M.L.D. — 29'-0" 28'-0"
DEPTH M.L.D. — 13'-3" 13'-1/2"

— S.S.N° 92. —
— PROFILE & DECK PLANS. —
— SCALE 1/4" = 1 FOOT. —

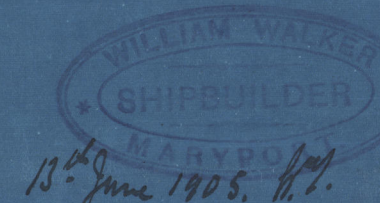

1076
16/6/05 27.6.05
2.2.06

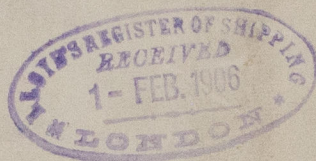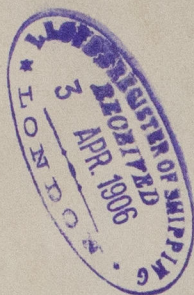



Wm Walker, Esq.

Profile and Deck Plan

S.S. N-92.

Bow Rpt. 1368.

"RUTH"

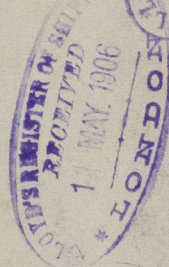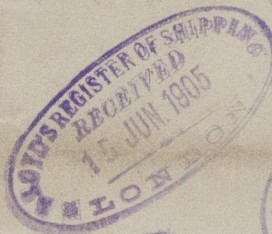

RETAIN



© 2020

Lloyd's Register
Foundation

W1266-0094