


25-2-03
25-3-03
16-4-03

"Lumbergia"

S.S. No 501.
PROFILE
DIMENSIONS 220' 33' 13" M.L.D. Main Deck

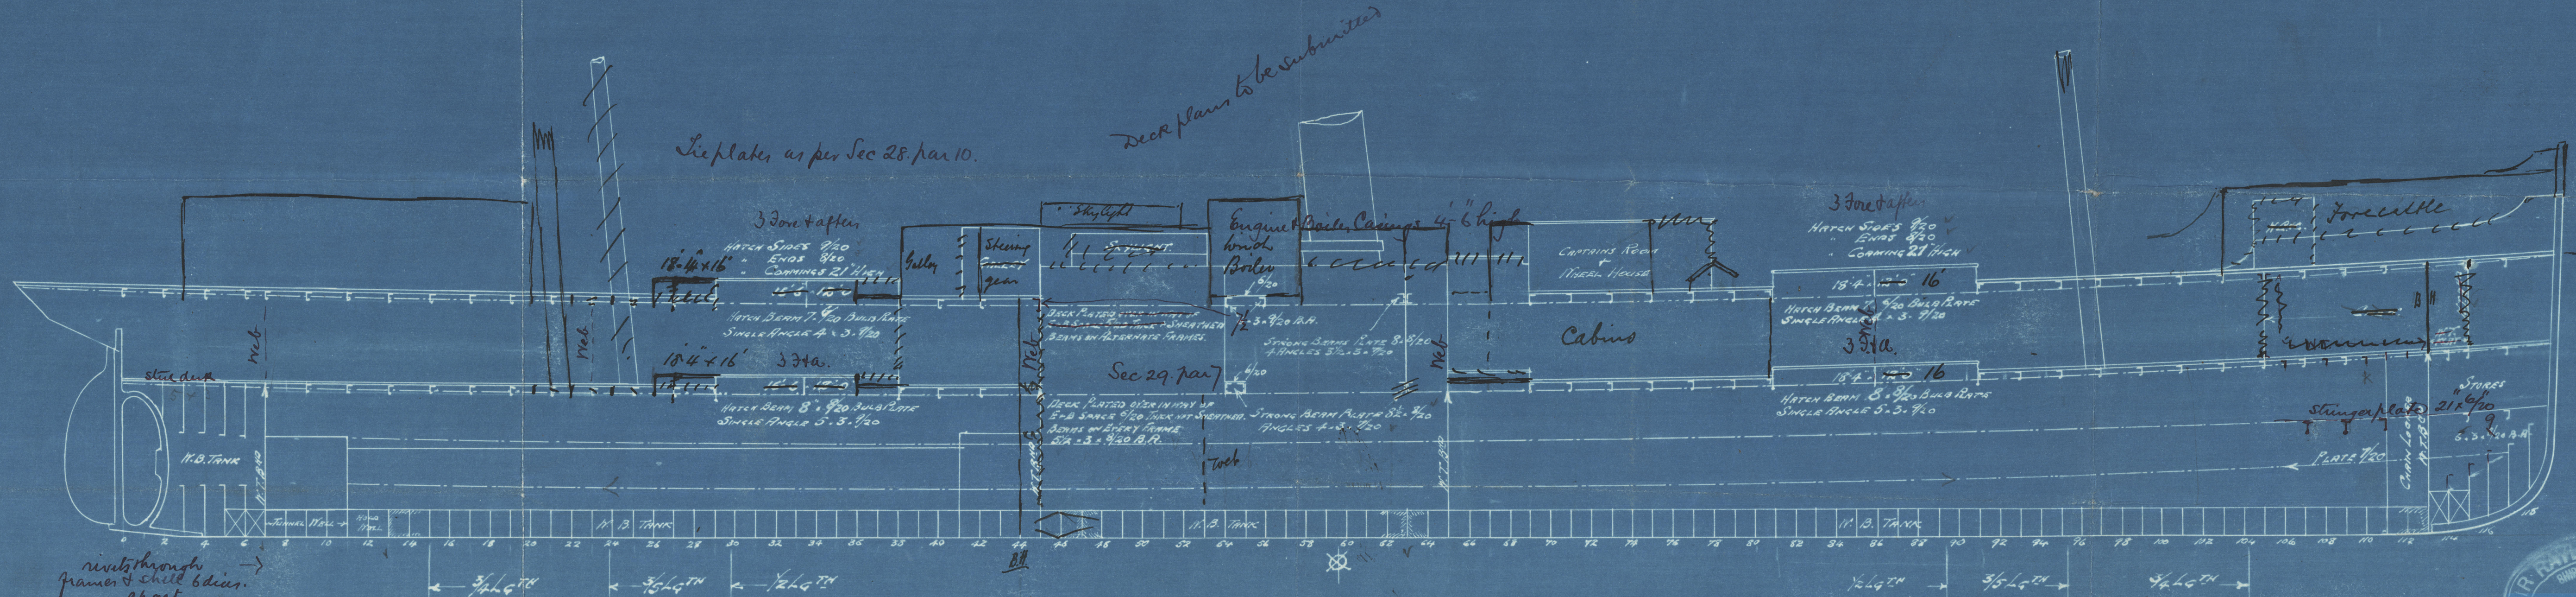

rivets through
frames & shell 6 diam.
apart.





W1266-0294


Sir R. Dixon & Co

No. 501

Profile

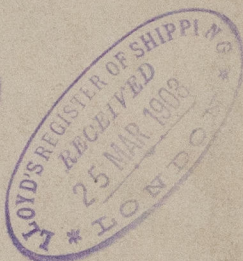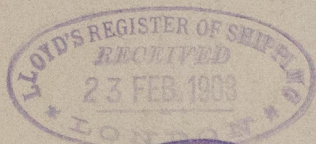

"Zambesia" EX BUZI
Mdb. Report No. 3699.

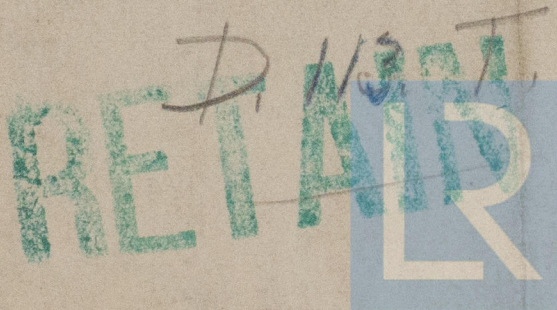

© 2020

Lloyd's Register
Foundation
W1266-0294