
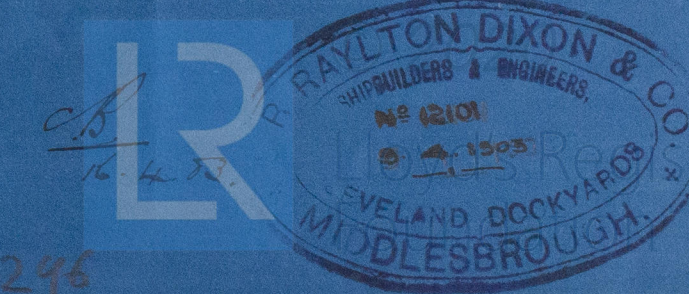


Nº 501 "Lambertia"

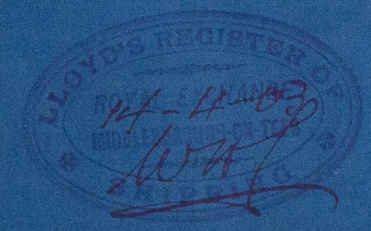


W246-0246

Sir R. Dixon & Co

No. 501

Amended
Deck plans

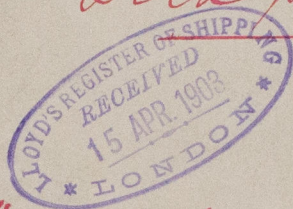

"Zambesia"

Mdt Report No 3699,

ex BUZI

D 113T



© 2020

Lloyd's Register
Foundation

W1266-0296