

1 3/16" HOLES 4 3/4" APART



Messrs. J. & Eltringham & Co.

Boiler No 1379

W. P. 120 Hs. <sup>sq</sup>

For.

Messrs Wood, Skinner & Co<sup>s</sup>

s/s. No 111

Mark, —

No 6486  
Lloyds Tnt.  
240 Hs.  
20.1.03. W.L.




J. J. Coaster

Newcastle Report

No 44936

1357-1850. C. 13722

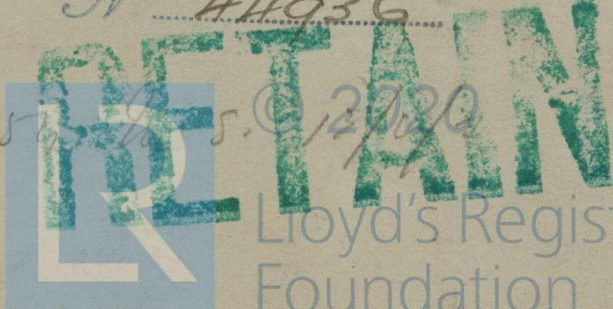

Lloyd's Register  
Foundation

W1267-0108