



# S. S. "Behar."

## Dick Plans, as fitted.

Scale  $\frac{1}{8}" = 1'-0"$   
 Dimensions 435'0" B.P. 57'4" mld x 40'9" mld to Upper dk  
 2<sup>nd</sup> class Lloyd's 100A1 with freeboard (corresponding to that of a  
 C.S.S. vessel with 5' average spacing)  
 Vessel carrying 17-6 Sections down are 1924 British Standards

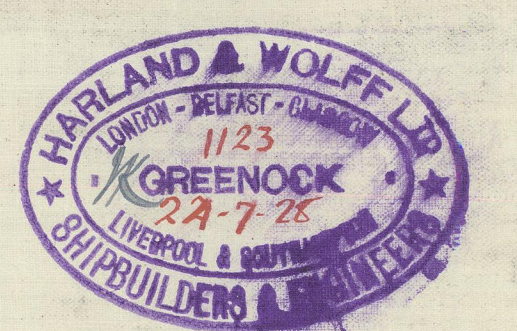

 

DECK PLANS OF SHIP AS  
BUILT.

---

HARLAND AND WOLFF'S.

No. 830. "BEHAR"

---

GRK. RPT. NO. 18977.

---

RETAIN



© 2020

Lloyd's Register  
Foundation

W1267-0161