


Nº 596

DIMS 135-0 B.P. x 23'-0" EXT x 13'-0" MLD

SCALE  $\frac{1}{4}$  = ONE FOOT

PLAN No. 3730  
ENCLOSURE TO  
Messrs Lloyd's Surveyors  
Hill FROM  
COCHRANE & SONS, LTD.  
G. INGLETON, SELBY  
DATE 17/12/13

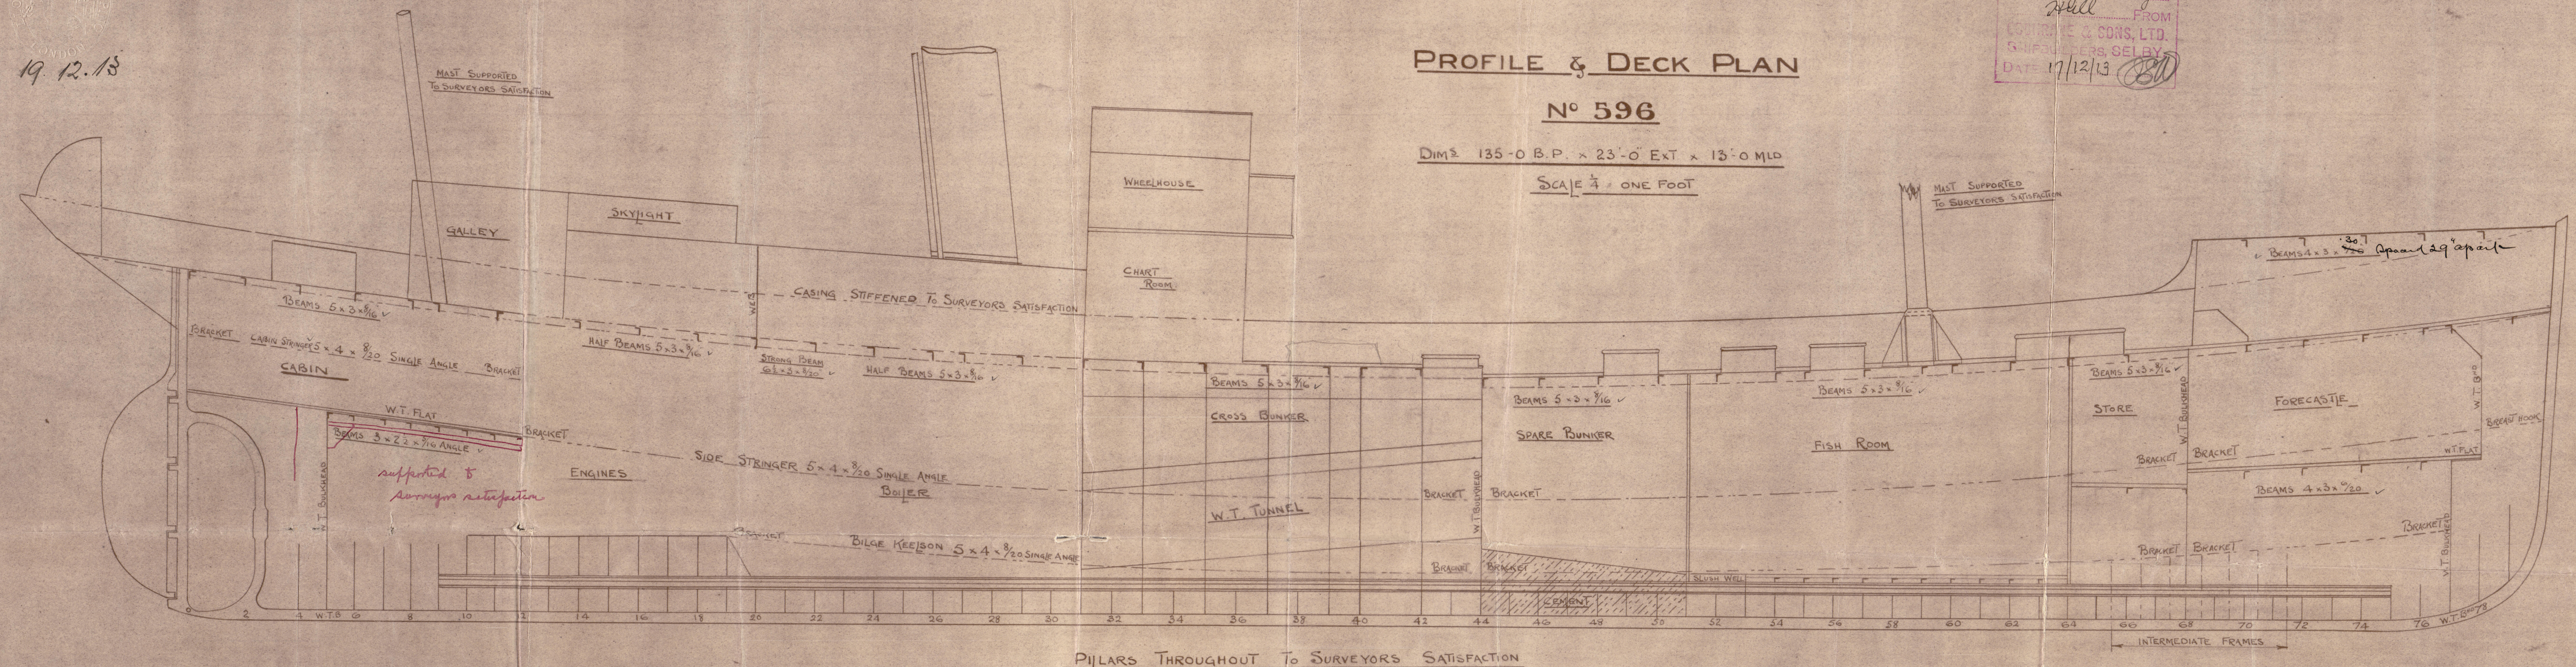

BB/  
19.12.13.




Cochrane & Sons. & Co.

No. 596

135-0 x 22.87 x 13-0

Profile at Deck.

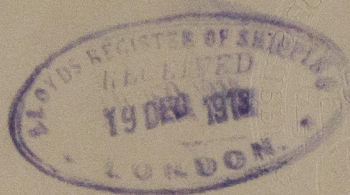

s/s 'Barle'

Hull Rpt No. 27544

RETAIN



© 2020

Lloyd's Register  
Foundation

W1269-0068



LLOYD'S REGISTER  
OF SHIPPING  
18 DEC 1913  
HULL

W1269-0068



© 2020

Lloyd's Register  
Foundation