

Mid Sea 614

Barle 614


(conversion to Oil carrier)

Midship Section

Copy for 6/1/16

75' Elmleaf " Hull freeboard Rpt. No. 29775

75' Elmleaf " Hull Rpt. No 29850

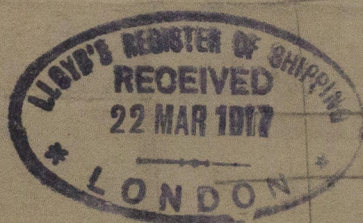

© 2020

Lloyd's Register
Foundation

W1269-0134