
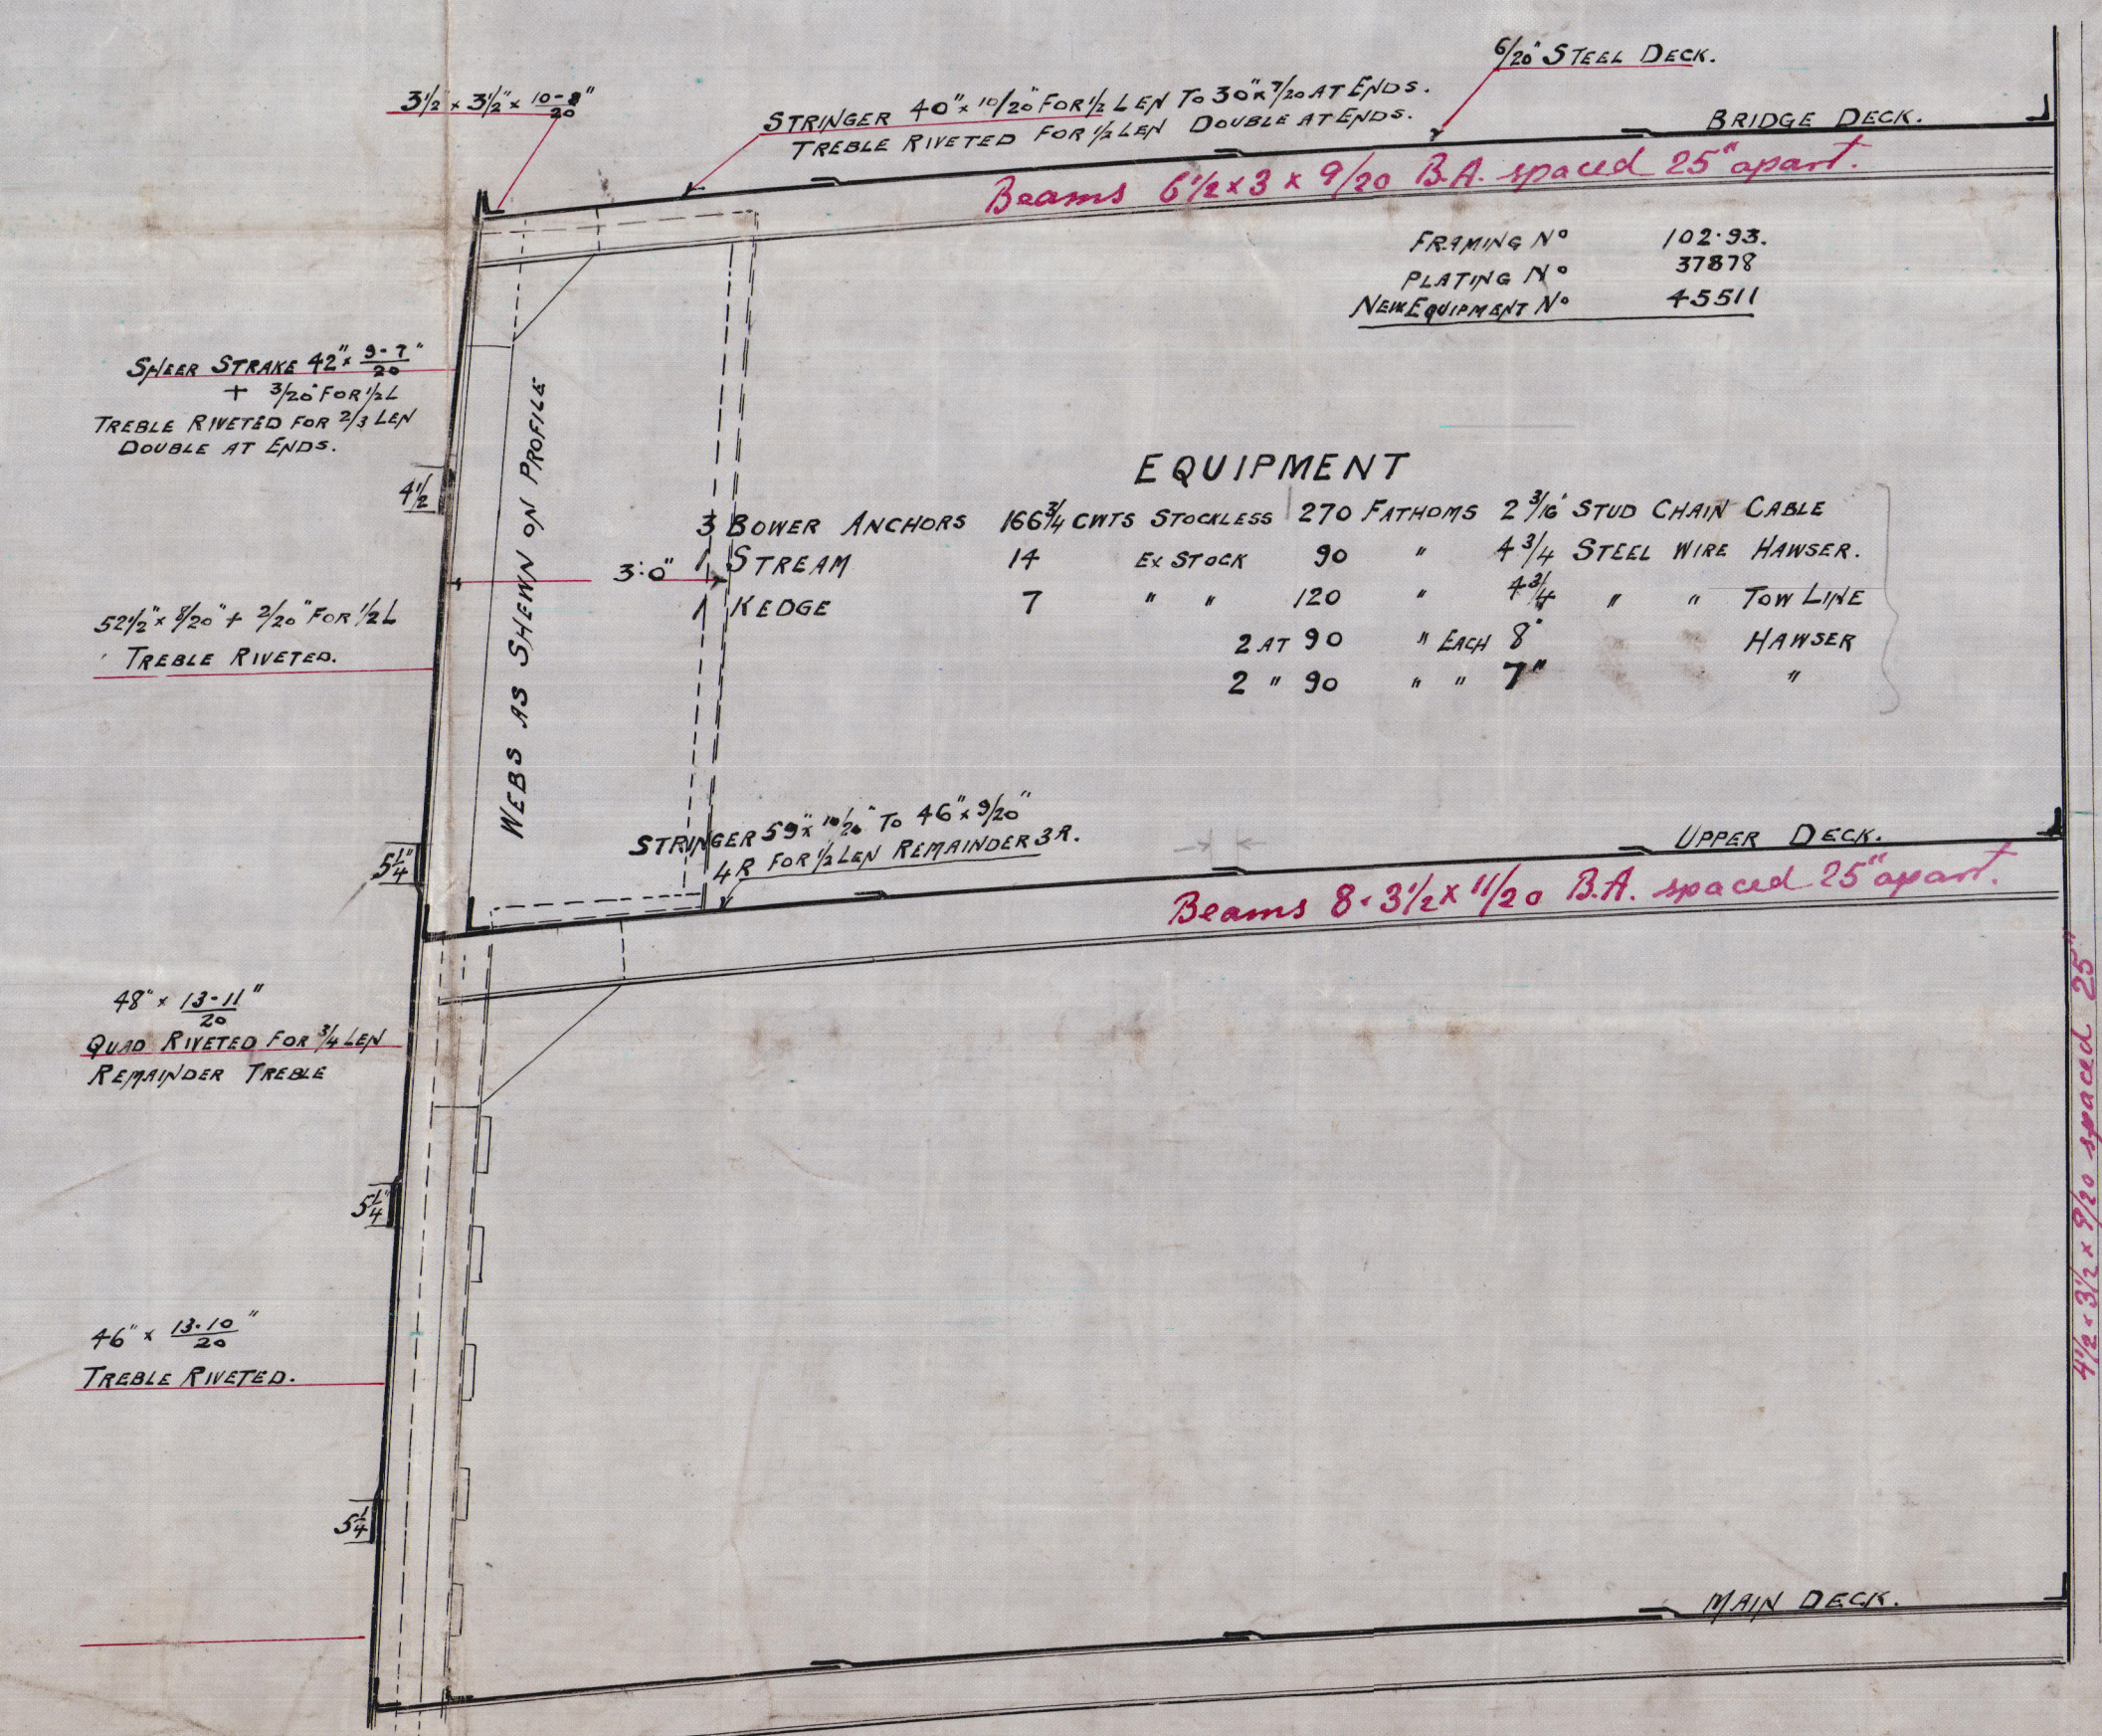
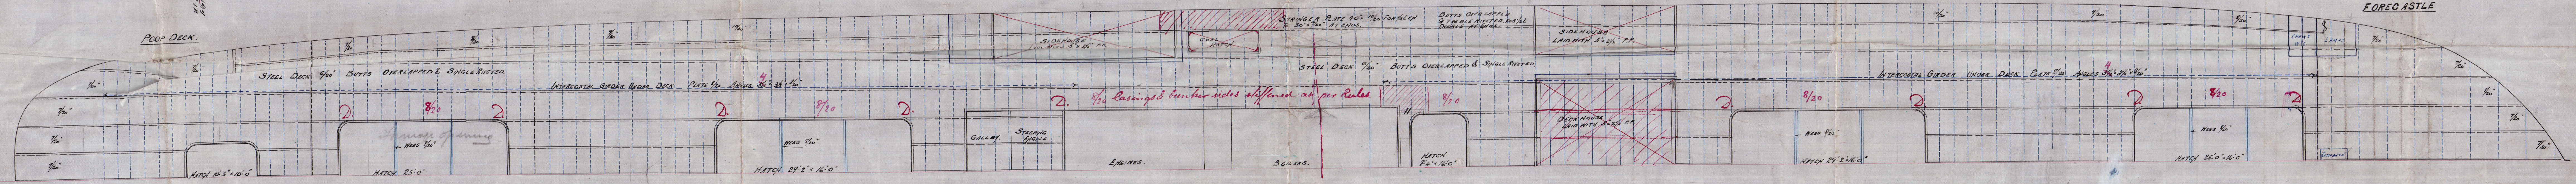


31.12.00

LONGITUDINAL SECTION AND DECK PLAN
SS No 159
SCALE 1/8" = 1 FOOT

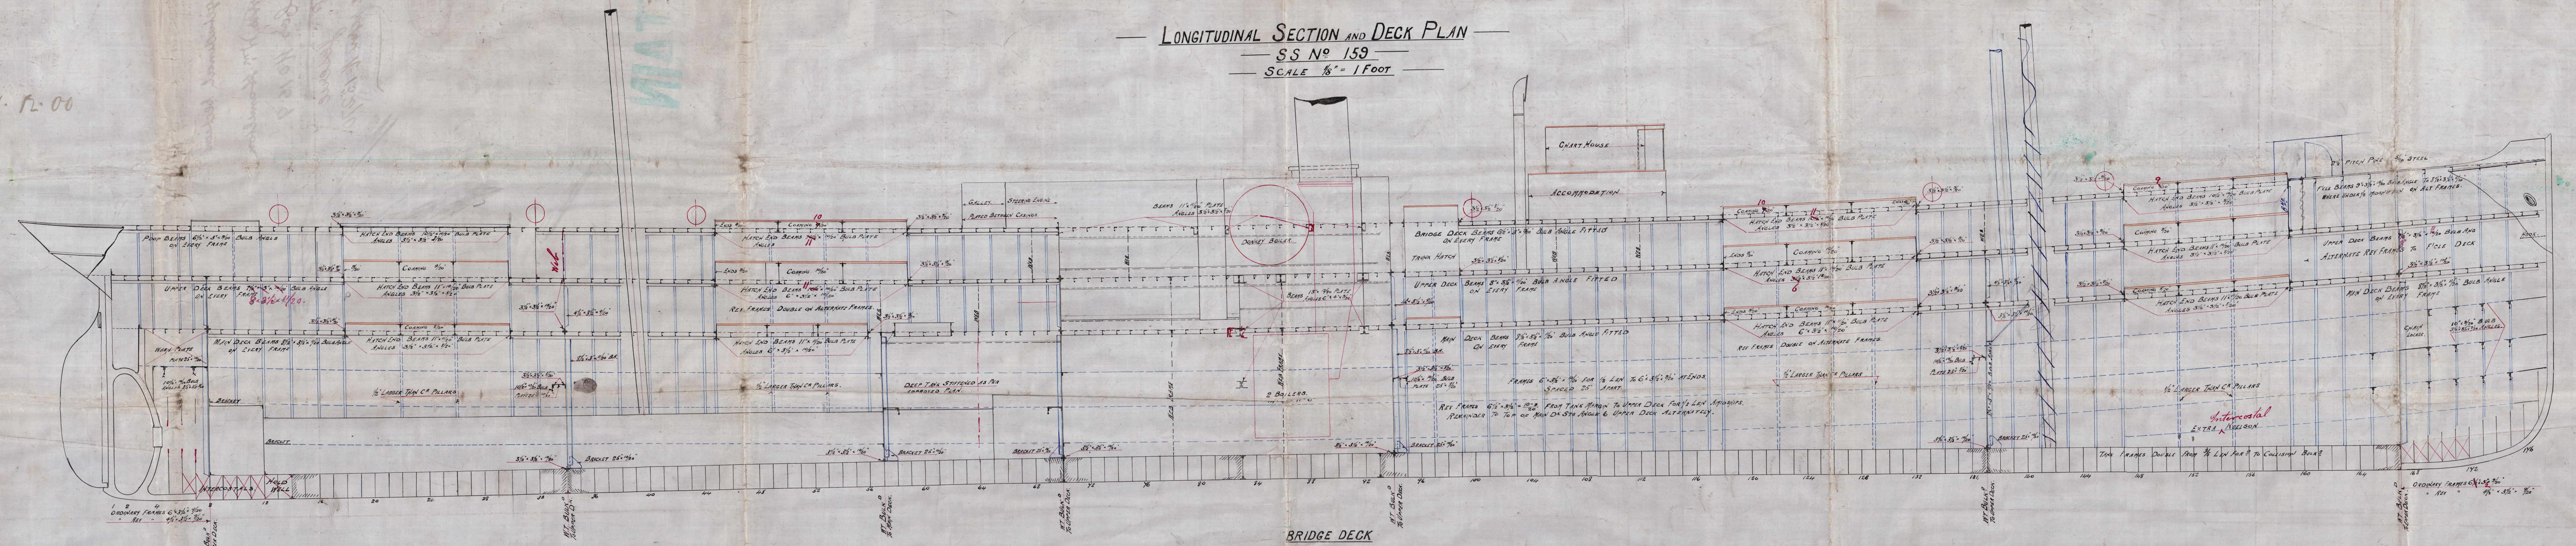



31/12/00

Longitudinal section

Messrs Wm Hamilton

No's 11015-9

L.P. Jeserie
Gen report No 13270

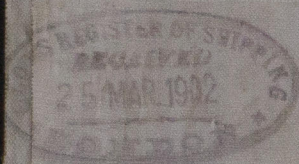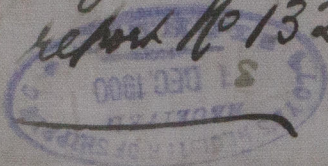

RETAIN

W1269-0186 $2\frac{1}{2}$



© 2020

Lloyd's Register
Foundation