


Not less than 25% thick
or alternatively tensile strength
of material not less than
43.5 kg/cm²

Thick holes not less than 20%
not greater than 24% dia.

Not less than 25% thick
or alternatively tensile strength
of material not less than 43.5 kg/cm²

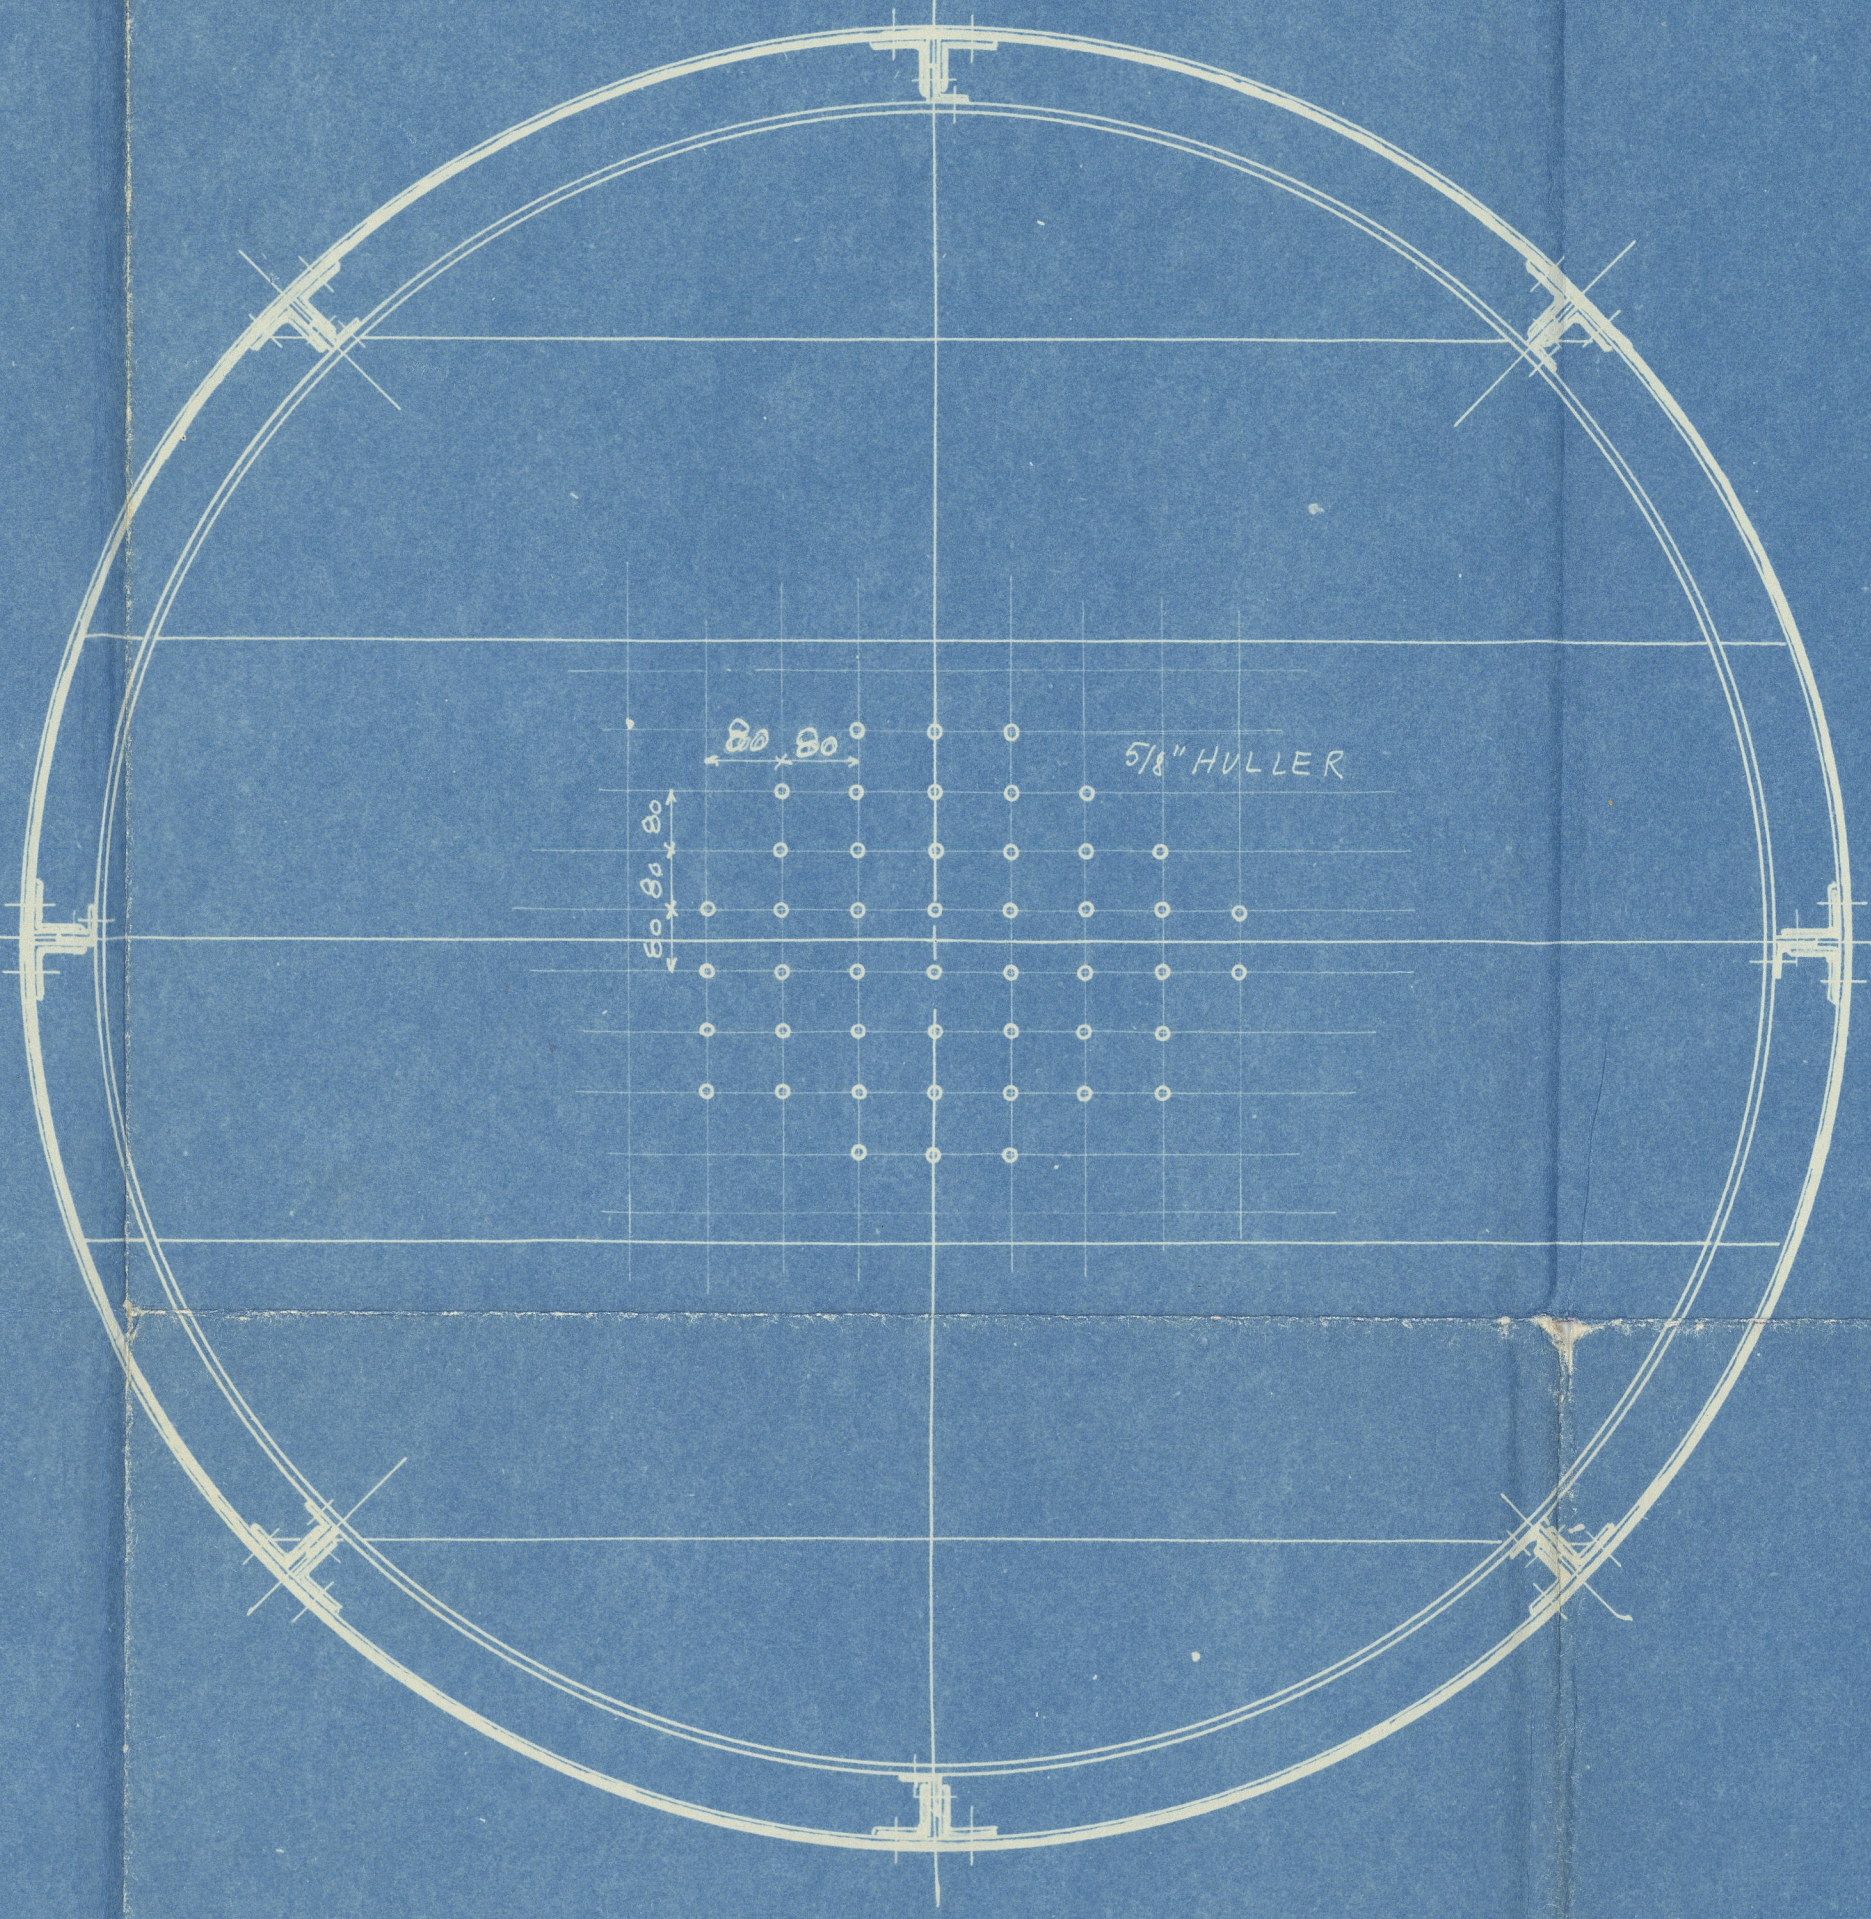

Southern Express
Mar. 13426

M=1:10
PRESKJELE 2400 mm DIA., 3660 mm HØI
[CA 8' DIA. x 12' HØI]
ARBEIDSTRYK 80 LB.S. PR. 0"

ALSMIRENS VERKSTED 10-5-1928

1928
30/5/28

S.P. Southern Express,
(ex Dan Jeronimo)

Mdb. rept. No. 13426,

W127-0131



© 2019

Lloyd's Register
Foundation