



Rud. C. Hartmann
Berlin - Rndow.

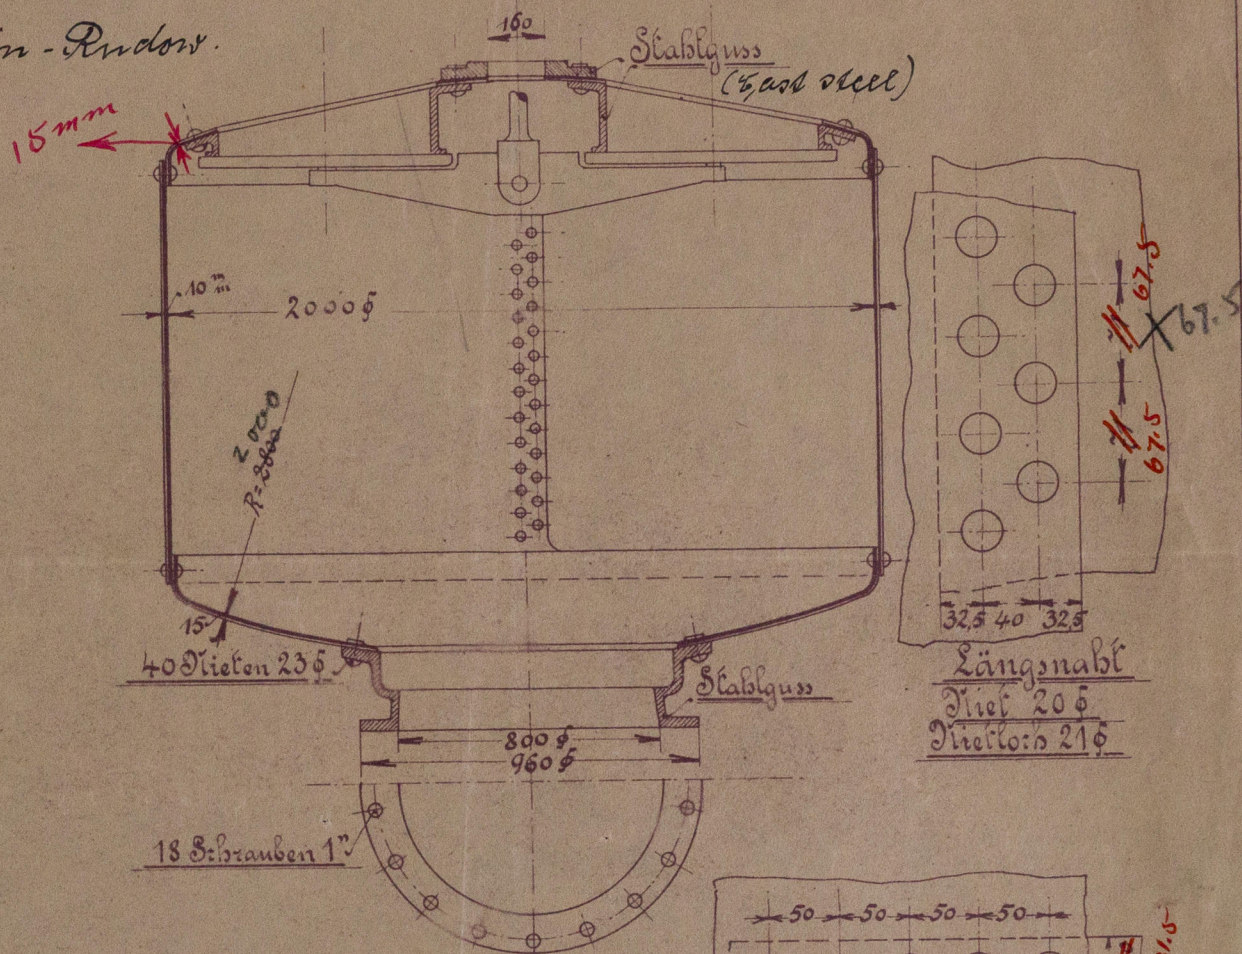


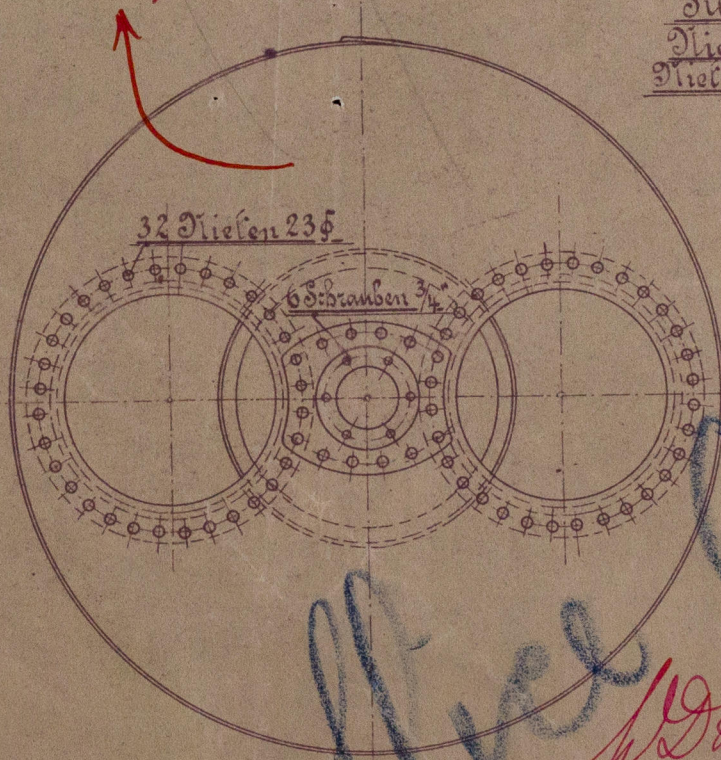

Filling chest
H. P. 3 kg/cm².
Gen. letter 26.7.28.

Einfüllbehälter
Betriebsdruck 3 kg/cm²

© 31/1/28

Lloyd's Register
Foundation

5510-721M