

Telephone: 293 London Wall.

Telegrams:
"TUNGUZ, LONDON."

The "STANDARD" Shipping Code.

THE
LIMITED.

JOSS, SONS & CO.,


Steamship Owners and Brokers,

25, ABCHURCH LANE,

LONDON, E.C.

19

Lloyd's Register
Foundation

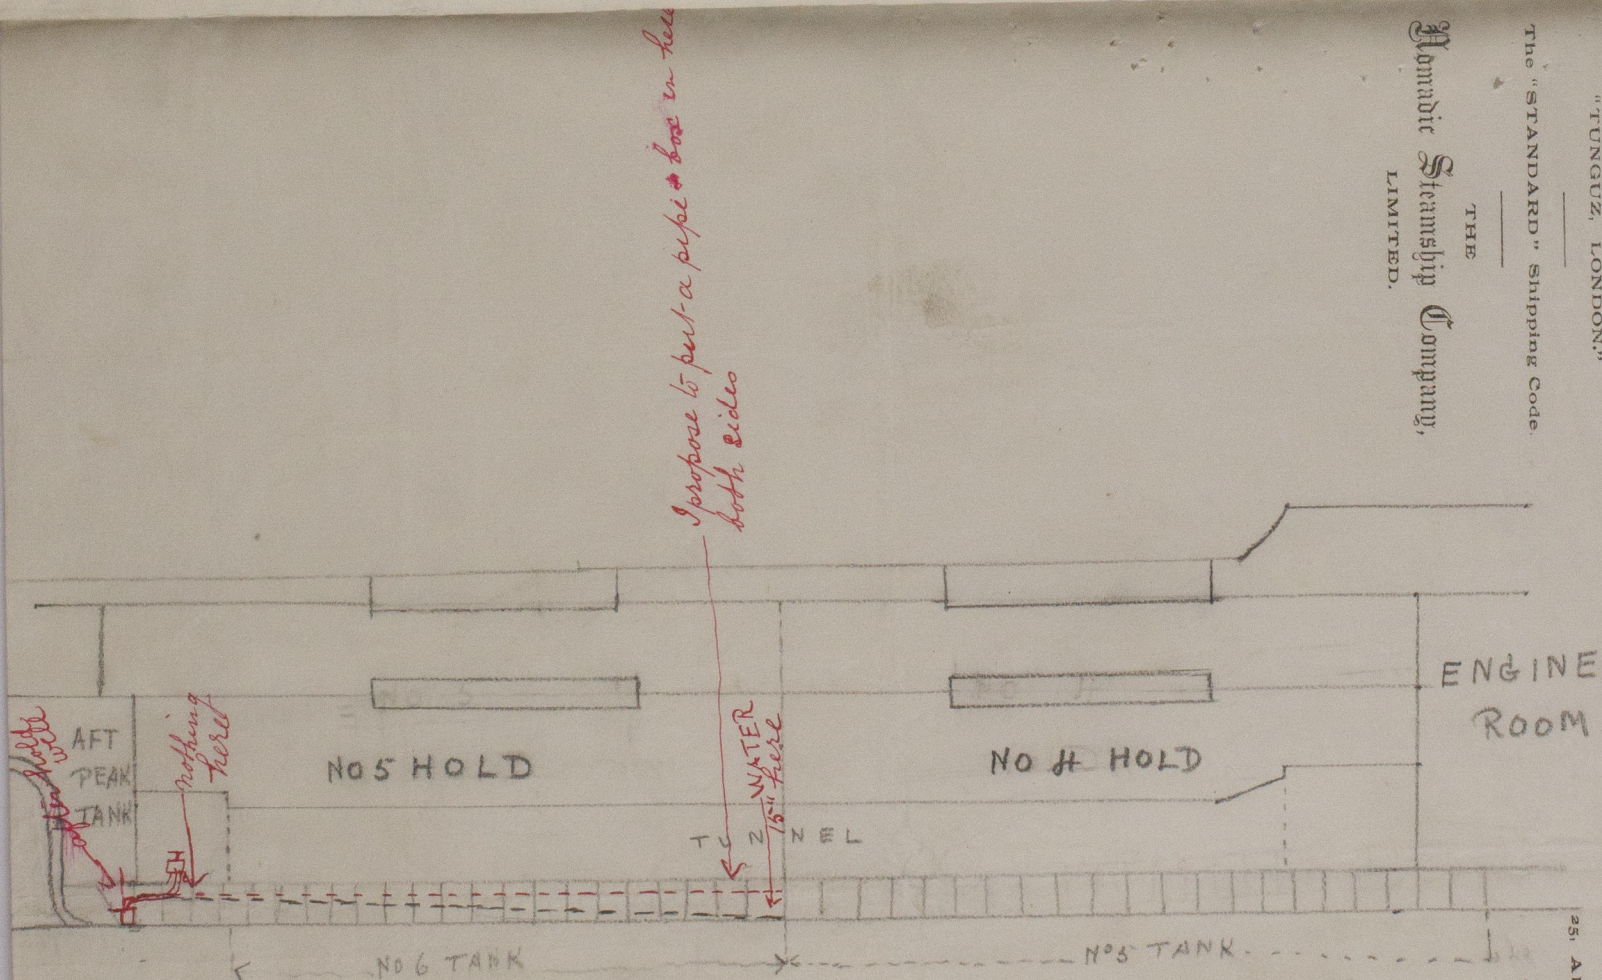

----- shear of Bilge \leftarrow This line denotes the shear of the bilge
----- water in Bilges \leftarrow This line denotes the water in the Bilges 15" at forward end
and nothing at after end Ship 4 foot by the stern

W1272 - 208