


W1272-0209


Bulkhead No 5 hold

For Bulkhead

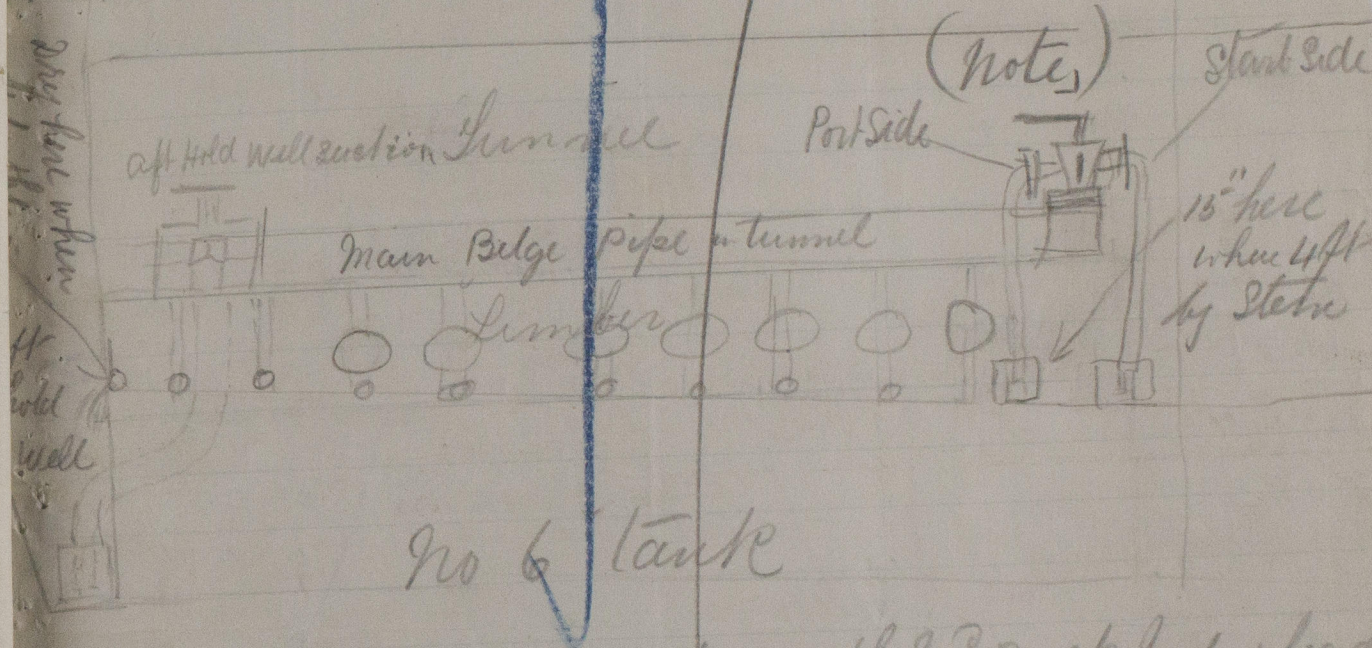

I propose to put a 2 way cock in at the For Bulkhead + lead pipes across to for Lumber, jointing on the Belge pipe in the tunnel independant of the Aft hold well valve up here (note) of course they will be each side of the tunnel Bulkhead close to the floor of the hold then the pipes could be cased over. I think you will be able to follow this. It is owing to the ship



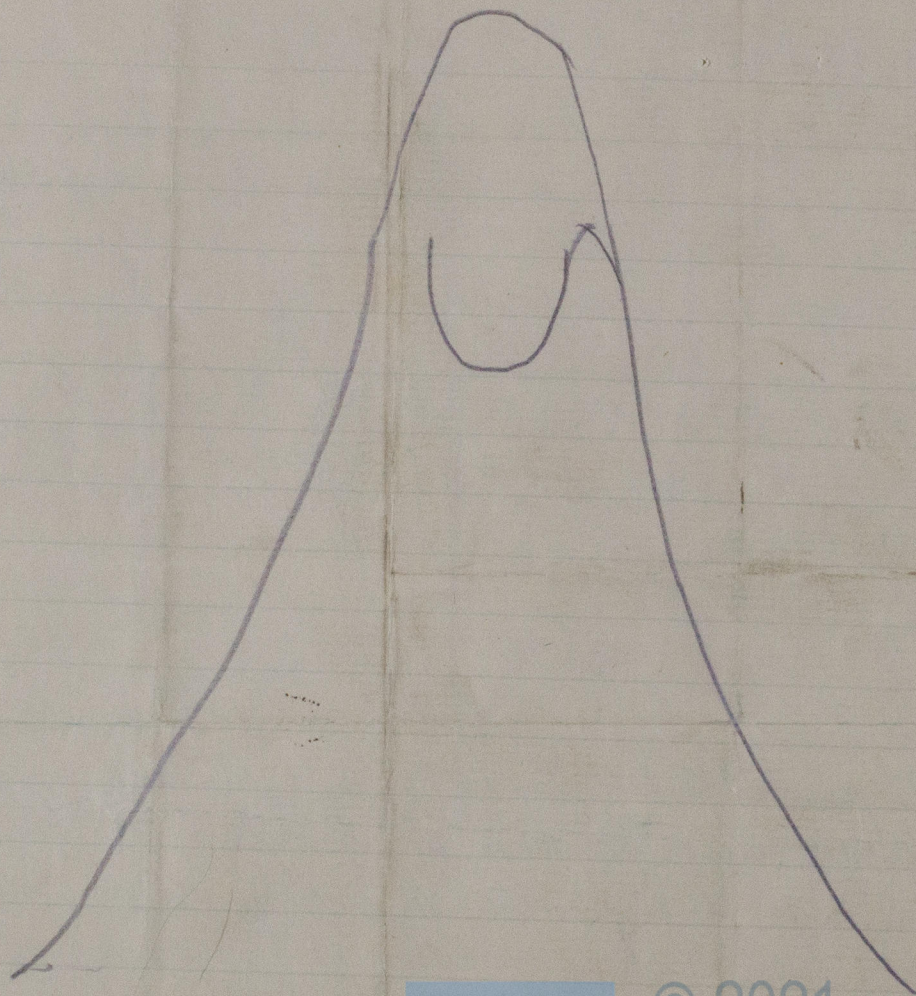

© 2021

Lloyd's Register  
Foundation