


**S.S. No 404**  
**MIDSHIP SECTION**  
 SCALE  $\frac{1}{2}'' = \text{ONE FOOT}$

360'0" B.P. x 50'0" EXTREME, 149'9" 11'10" x 27'14" 11'10" TO CLASS 100 R.I. SPAN DECK.

6-5-05  
12-10-05

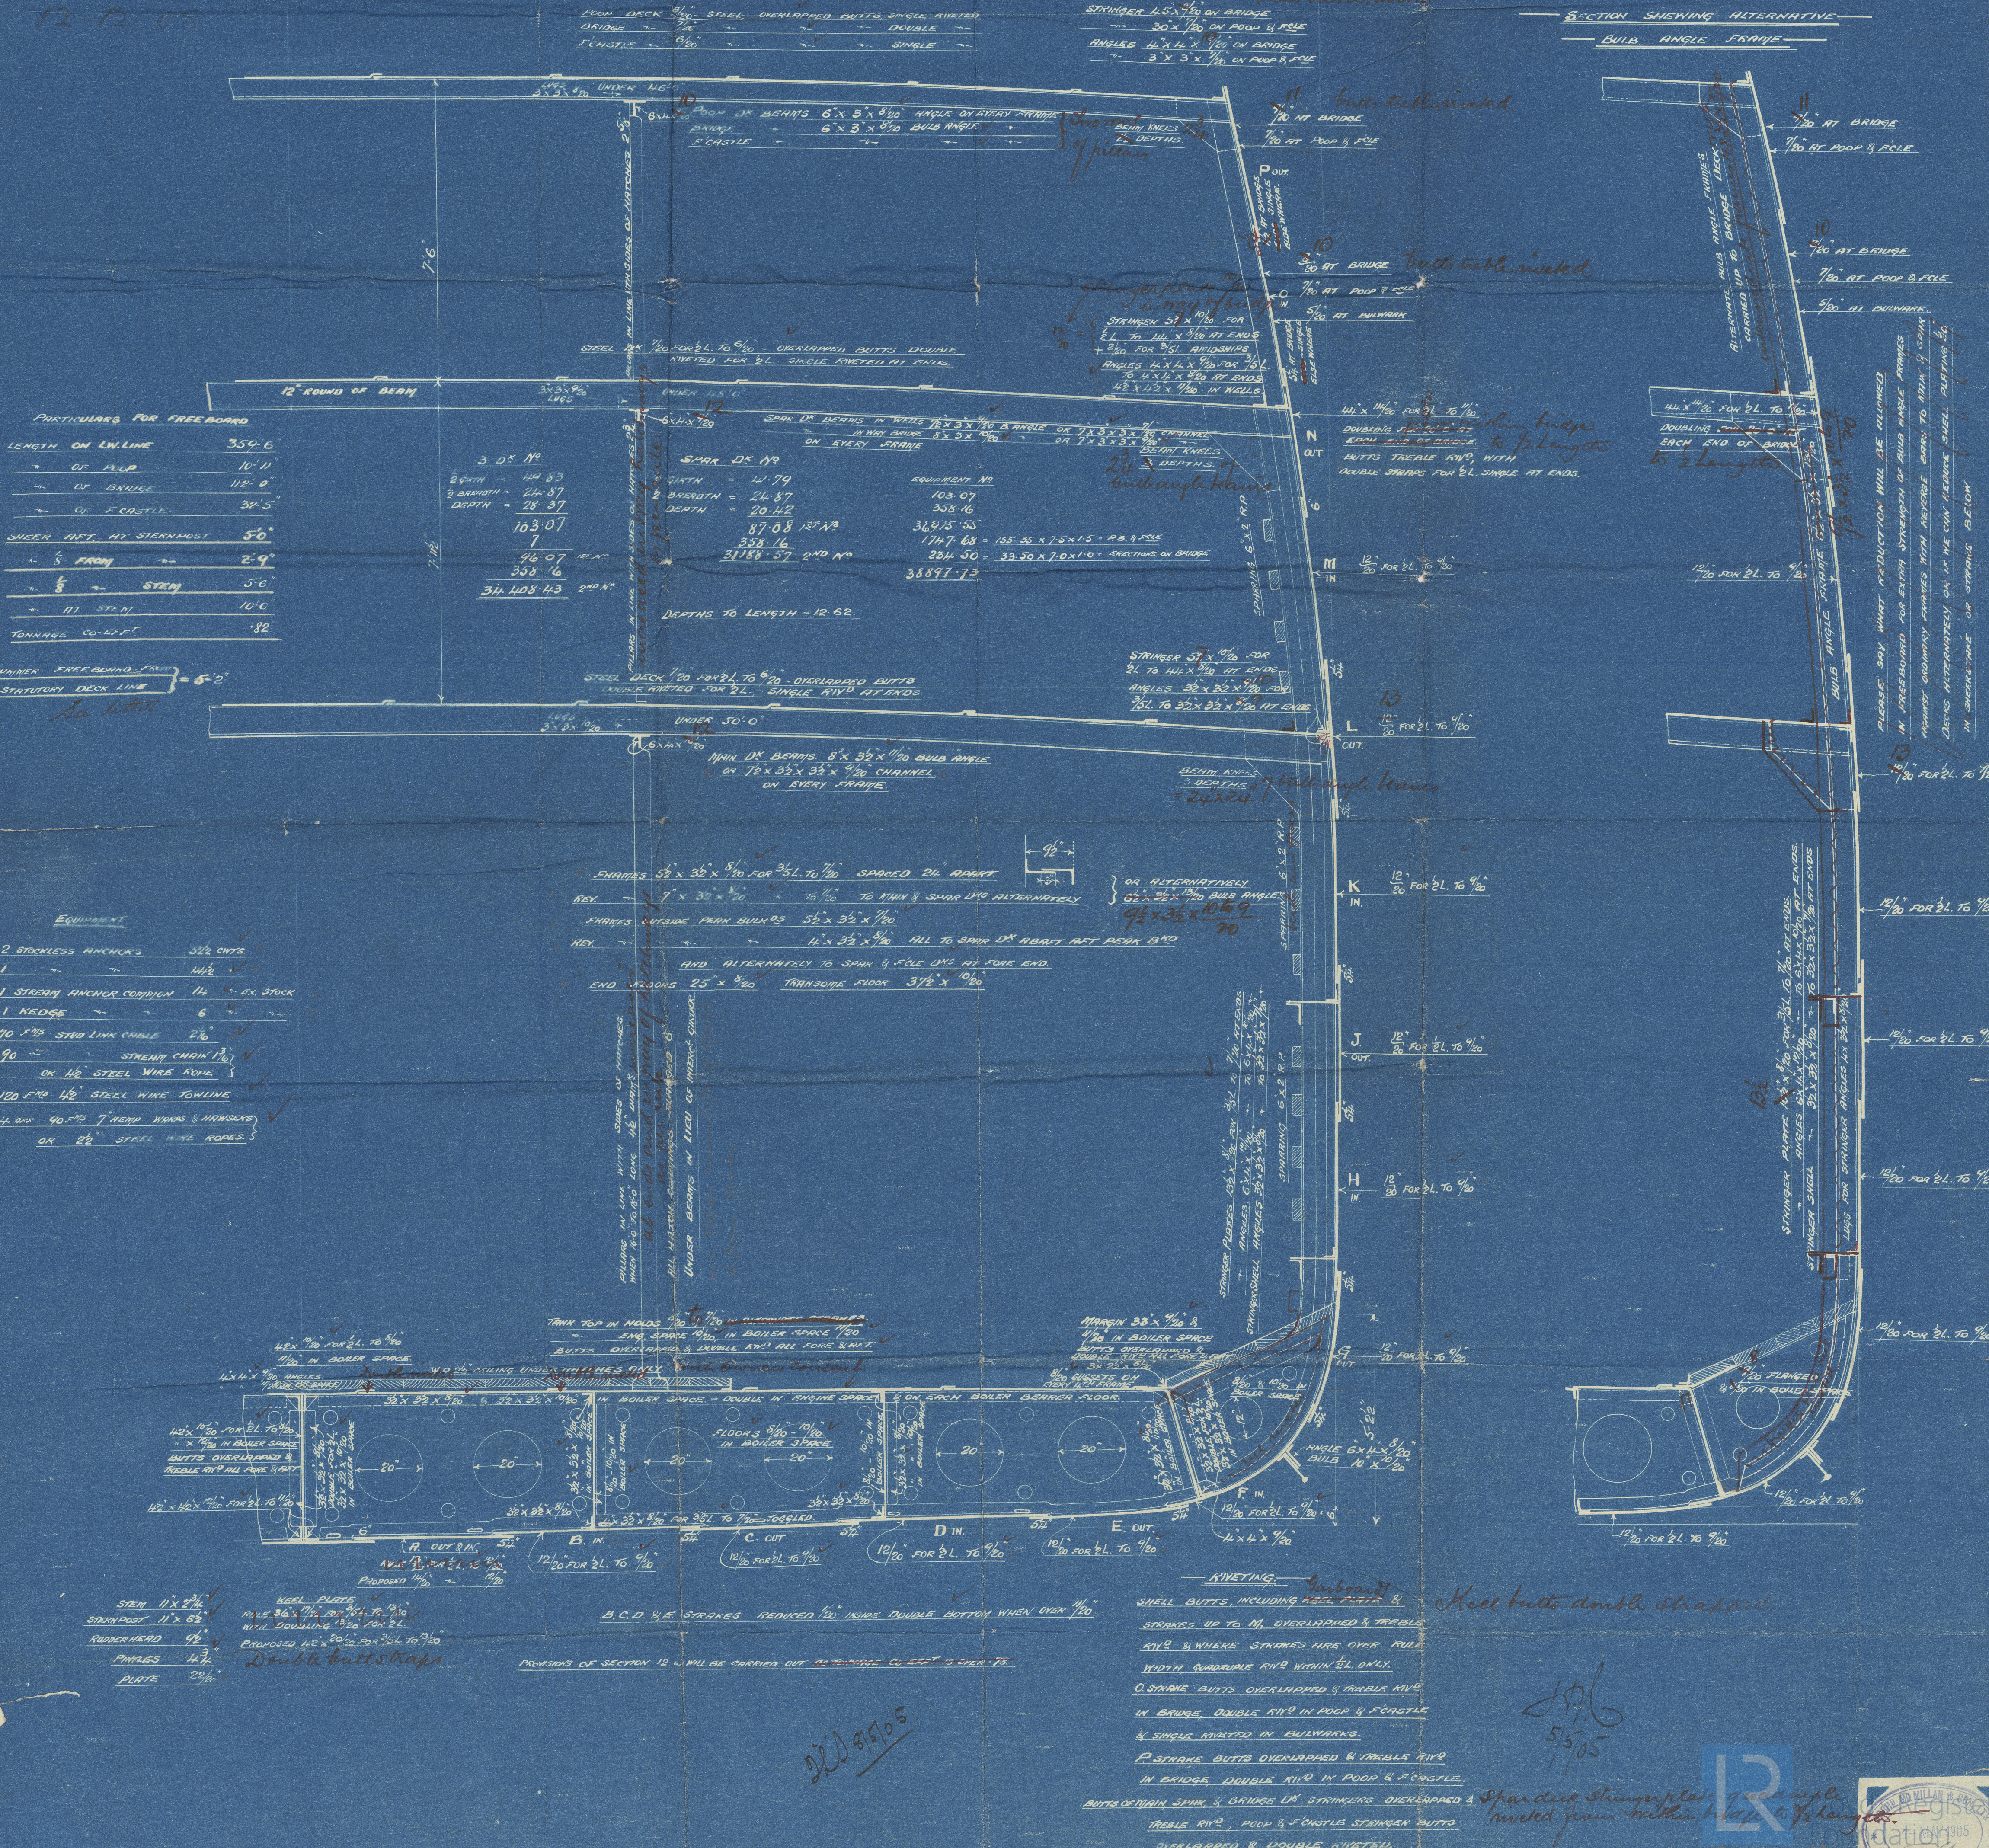

**PARTICULARS FOR FREEBOARD**

|                        |       |
|------------------------|-------|
| LENGTH ON LWLINE       | 359.6 |
| OF POOP                | 10.11 |
| OF BRIDGE              | 112.0 |
| OF FORECASTLE          | 32.5  |
| SKEER AFT AT STERNPOST | 50°   |
| OF FRAME               | 2.9°  |
| OF STEM                | 5.6°  |
| OF STERN               | 10.0  |
| TONNAGE COEFFICIENT    | .82   |

**SPR DECK NO**

|            |        |
|------------|--------|
| 3 D'S NO   | 140.83 |
| 2 ANGLE    | 24.87  |
| DEPTH      | 28.37  |
|            | 103.07 |
|            | 96.07  |
|            | 358.16 |
| 34.1408.43 | 2ND NO |

**SPR DECK NO**

|          |              |
|----------|--------------|
| SIXTH    | 42.79        |
| SEVENTH  | 24.87        |
| DEPTH    | 20.12        |
|          | 87.08 1ST NO |
|          | 358.16       |
| 31.88.57 | 2ND NO       |

**EQUIPMENT NO**

|  |  |
|--|--|
|  | 103.07   |
|  | 358.16   |
|  | 174.7.68 = 155.35 x 7.5 x 1.5 = P.O. & F.O.E.    |
|  | 234.50 = 33.50 x 7.0 x 1.0 = STRAINERS ON BRIDGE |
|  | 38897.73   |

DEPTHS TO LENGTH = 12.62

- EQUIPMENT**
- 2 STOCKLESS ANCHORS 322 CWT.
  - 1 STREAM ANCHOR COMBINATION 14 EX STOCK
  - 1 KEDGE 6
  - 270 LBS STD LINK CHAIN 2 1/2"
  - 90 " STREAM CHAIN 1 3/4"
  - OR 142 STEEL WIRE ROPE
  - 120 LBS 1/2" STEEL WIRE TOWLINE
  - 14.000 40.500 7" WIRE WINDERS & WINDINGS
  - OR 22" STEEL WIRE ROPES

**STEM** 11' x 24'

**STERNPOST** 11' x 62'

**RIDDERHEAD** 92'

**PLATES** 42'

**PLATE** 20' x 12'

Double butt straps

B, C, D, E STRAINERS REDUCED 1/2" INSIDE DOUBLE BOTTOM WHEN OVER 1/20"

PROVISIONS OF SECTION 12 WILL BE CARRIED OUT AS FOLLOWS: 1. 1/20" IS OVER 1/20"

**RIVETING**

SHALL BUTTS, INCLUDING RIGID CUTS & STRAINERS UP TO 1/4" OVERLAPPED & TRIPLE RIVET & WHERE STRAINERS ARE OVER RIVET WITH QUADRUPLE RIVET WITHIN 1/4" ONLY.

OVERLAPPED & TRIPLE RIVET IN BRIDGE, DOUBLE RIVET IN POOP & FORECASTLE & SINGLE RIVET IN BULKHEADS.

P STRAINERS BUTTS OVERLAPPED & TRIPLE RIVET IN BRIDGE, DOUBLE RIVET IN POOP & FORECASTLE.

BUTTS OF MAIN SPARK & BRIDGE DECK STRAINERS OVERLAPPED & TRIPLE RIVET, POOP & FORECASTLE STRAINERS BUTTS OVERLAPPED & DOUBLE RIVET.

Keel butts double strapped






5/5/05

SPR DECK STRINGER PLATE QUADRUPLE RIVETED FROM BULKHEAD TO 1/2 LENGTH






Midship Section  
McMillan & Son  
No. 4.04

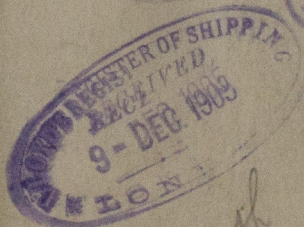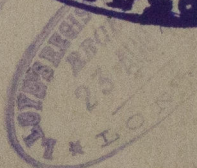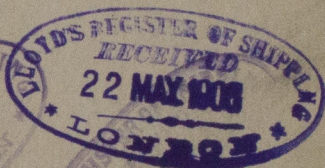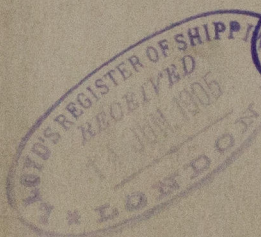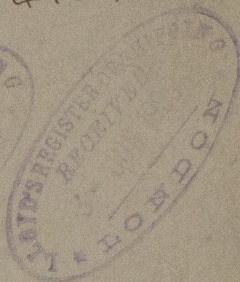

Visigoth

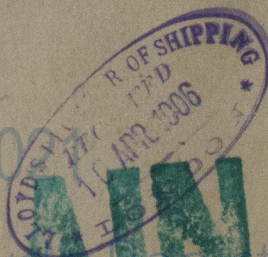

© 2005  
Lloyd's Register  
Foundation

W1272-0219