


6.5.05  
12.12.05

—S.S. N<sup>o</sup> 404.—  
—PROFILE.—  
—SCALE  $\frac{1}{8}$ " = ONE FOOT.—

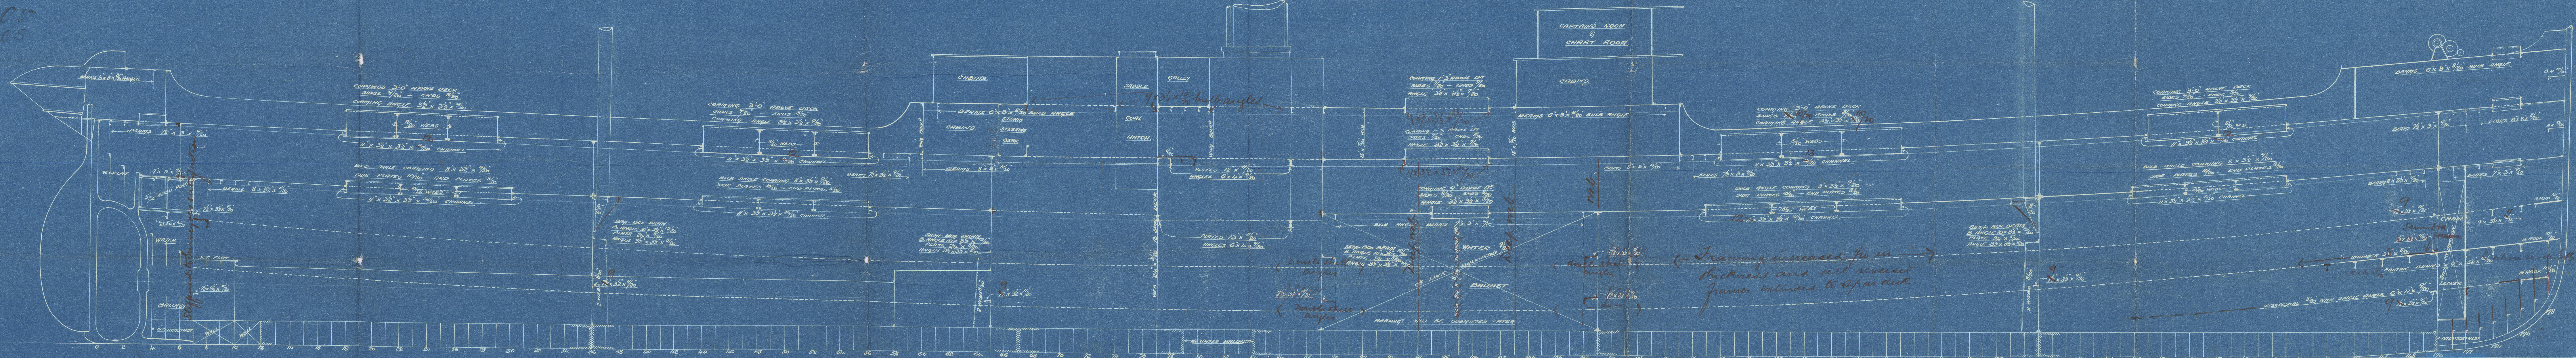

← Framing increased for in thickness and all reverse frames extended to spar deck. →





22/5 9/5/05

5/5/05



Profile  
McMillan & Son  
No. 404

S.S. "Disigoth"  
Ges. nrt. m. 24015,

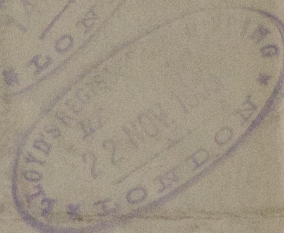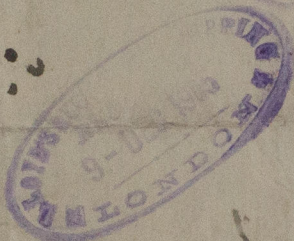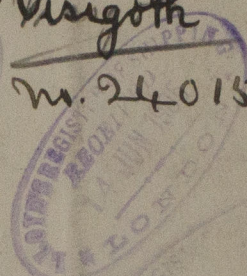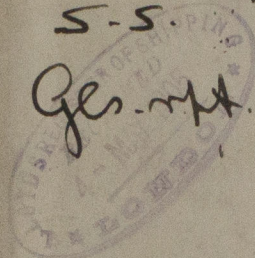

RETURN

W1272 - 0220



© 2021

Lloyd's Register  
Foundation